RASTER

PARENT PARCEL: 11-00-047-000-053

CHILD PARCEL: 11-00-047-000-054, -055

STARTING POINT: CENTERLINE OF AVON BELDEN RD & O.L. 47

08-02624

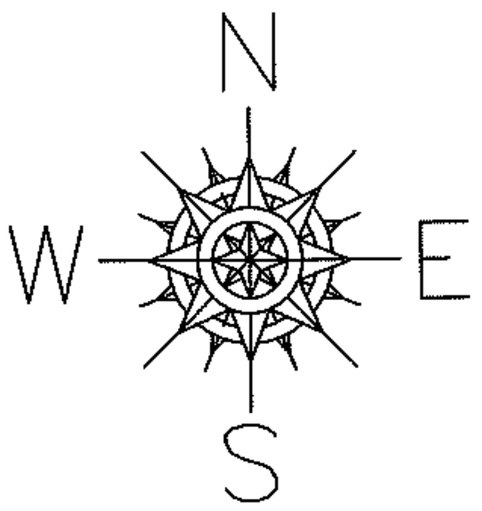

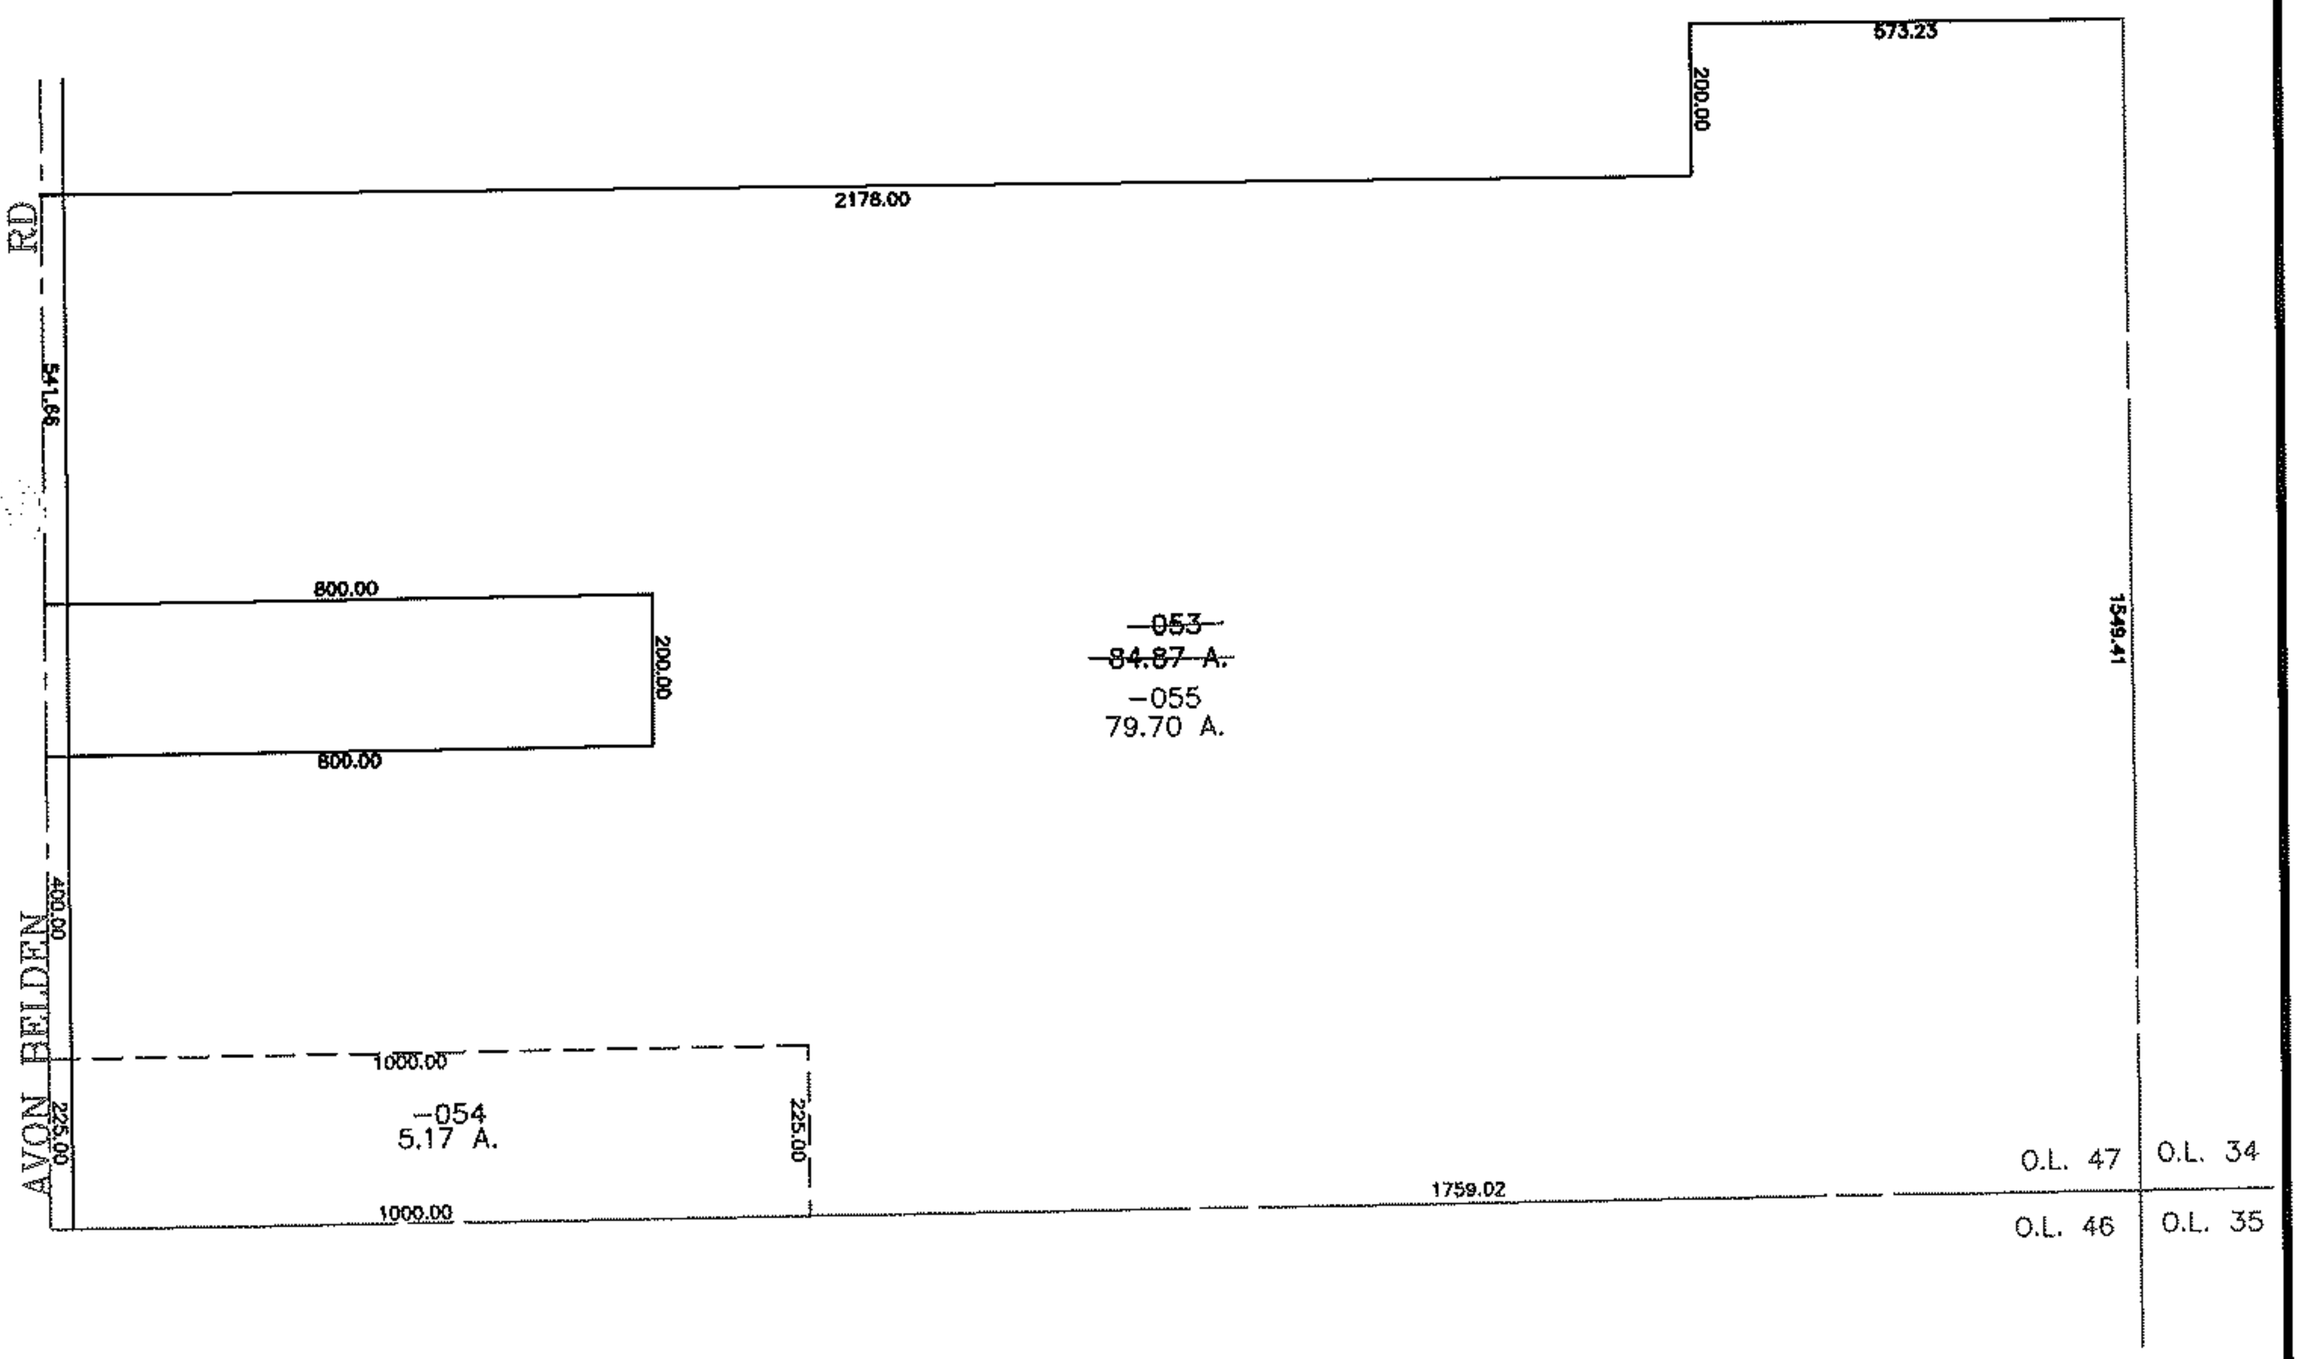

SPLITS/DEEDS PROCESSED

LORAIN COUNTY TAX MAP DEPARTMENT
226 MIDDLE AVE. ELYRIA, OHIO

SURVEYED BY: JAMES B ROOT

CLOSURE: 0.00 : 10,000

MAP PAGE(S): 11-00-047-B

APPROVED BY: JAH DATE: 10-21-08

SCALE: 1"= 400 PRIOR INSTRUMENT: 20070205850