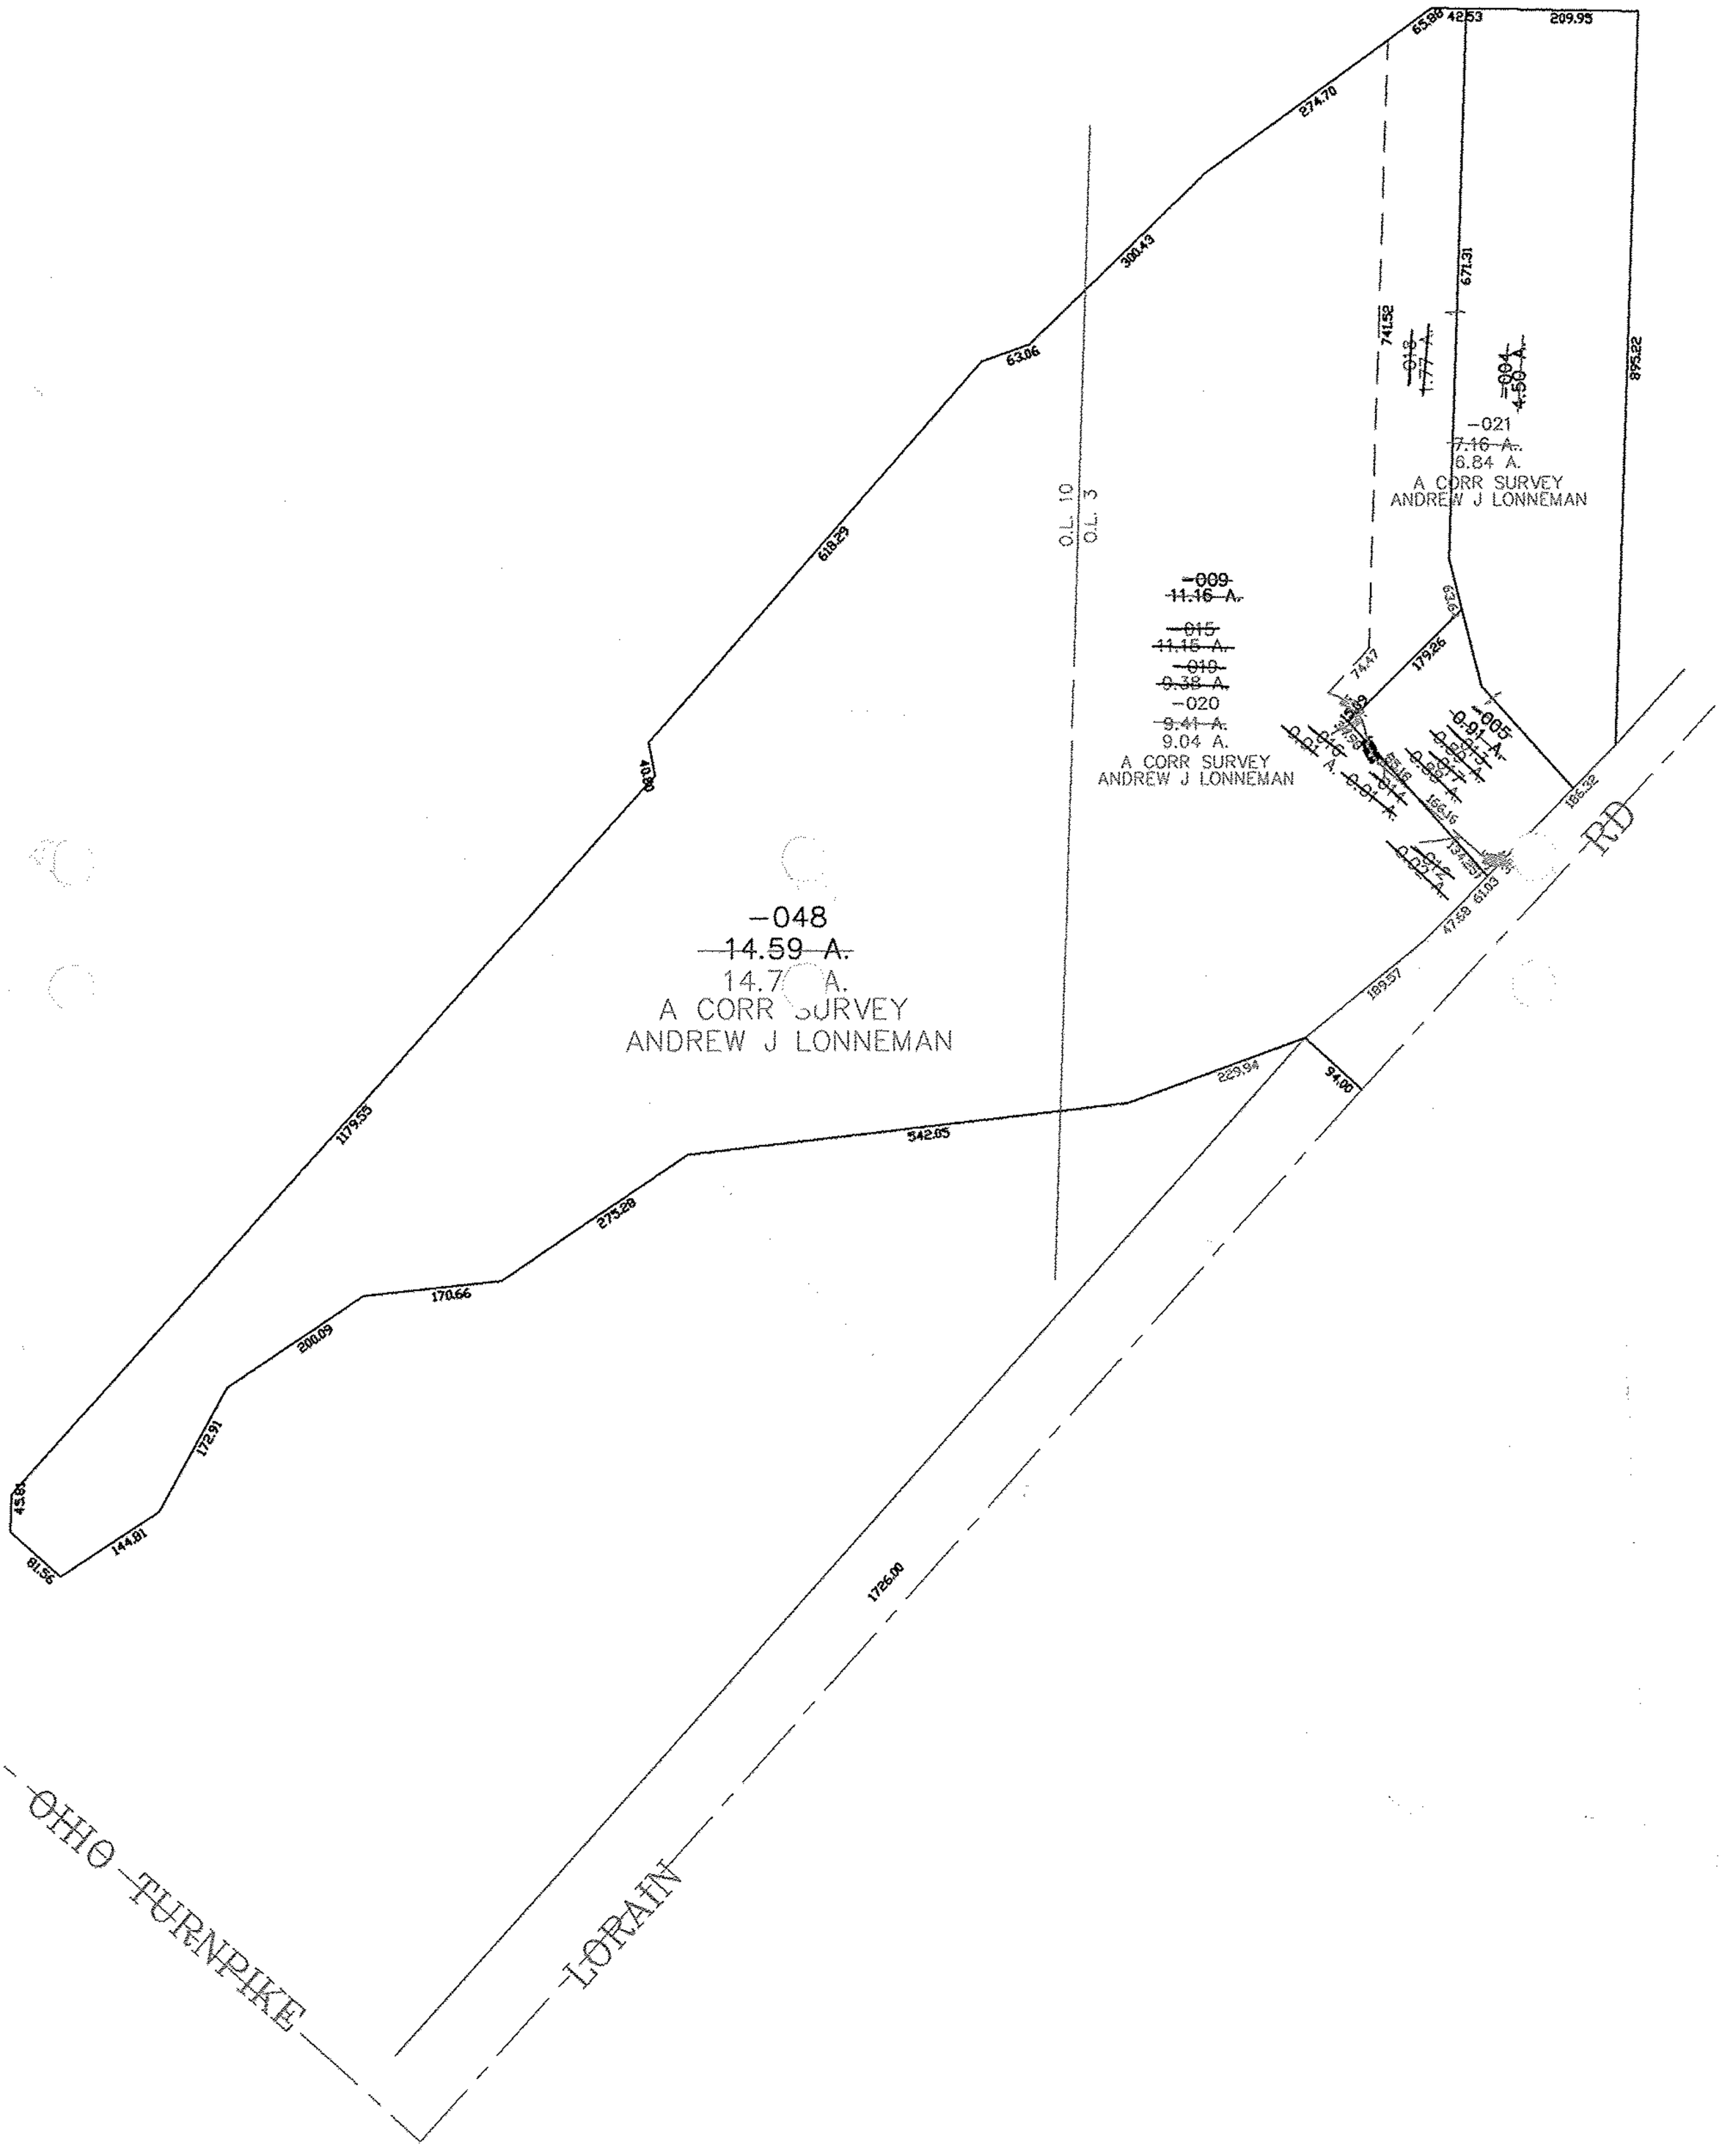
65.80
42.53
209.95
274.70
300.43
63.06
618.29
671.31
741.52
895.22
O.L. 10
O.L. 3
-009
11.16 A.
-015
11.15 A.
-019
9.38 A.
-020
9.41 A.
9.04 A.
A CORR SURVEY
ANDREW J LONNEMAN
-021
7.16 A.
6.84 A.
A CORR SURVEY
ANDREW J LONNEMAN
-048
14.59 A.
14.7 A.
A CORR SURVEY
ANDREW J LONNEMAN
1179.55
45.80
81.56
144.81
172.91
200.09
170.66
275.28
342.05
229.94
94.00
1726.00
RD
OHIO TURNPIKE
LORAIN

08-02029