


PARENT PARCEL: SEE BELOW

CHILD PARCEL: XX-XX-XXX-XXX-XXX

STARTING POINT: XXXXXX

13-02641-A

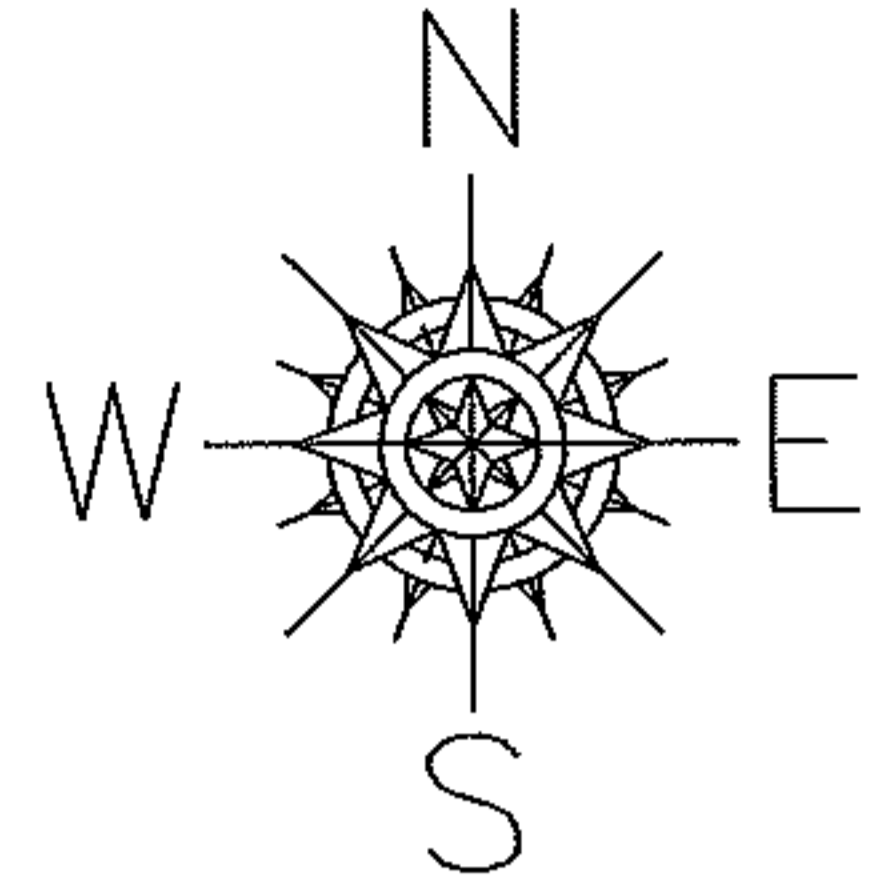

ACREAGE CORRECTION

08-13-005-000-003

~~19.99~~ A.

19.12 A.

PER DV 1403/745

ACREAGE CORRECTION

08-13-016-000-001

~~48.50~~ A.

48.62 A.

PER DV 1403/745

ACREAGE CORRECTION

08-13-017-000-002

~~12.00~~ A.

11.50 A.

PER DV 1403/745


ACREAGE CORRECTION

08-15-007-000-002

~~89.00~~ A.

89.71 A.

PER OR 61/753

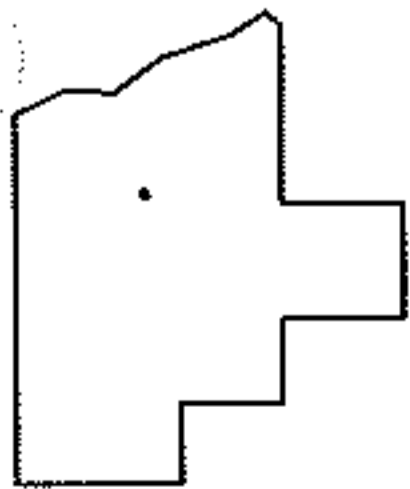

SPLITS/DEEDS PROCESSED

LORAIN COUNTY TAX MAP DEPARTMENT
226 MIDDLE AVE. ELYRIA, OHIO

SURVEYED BY: NA

CLOSURE: NA

MAP PAGE(S): 8-F & 8-D

APPROVED BY: TJS DATE: 1/2/13

SCALE: 1"=100 PRIOR INST.: SEE ABOVE