PARENT PARCEL: 13-11-018-000-010

CHILD PARCEL: XX-XX-XXX-XXX-XXX

STARTING POINT: XXXXXX

13-02647-A

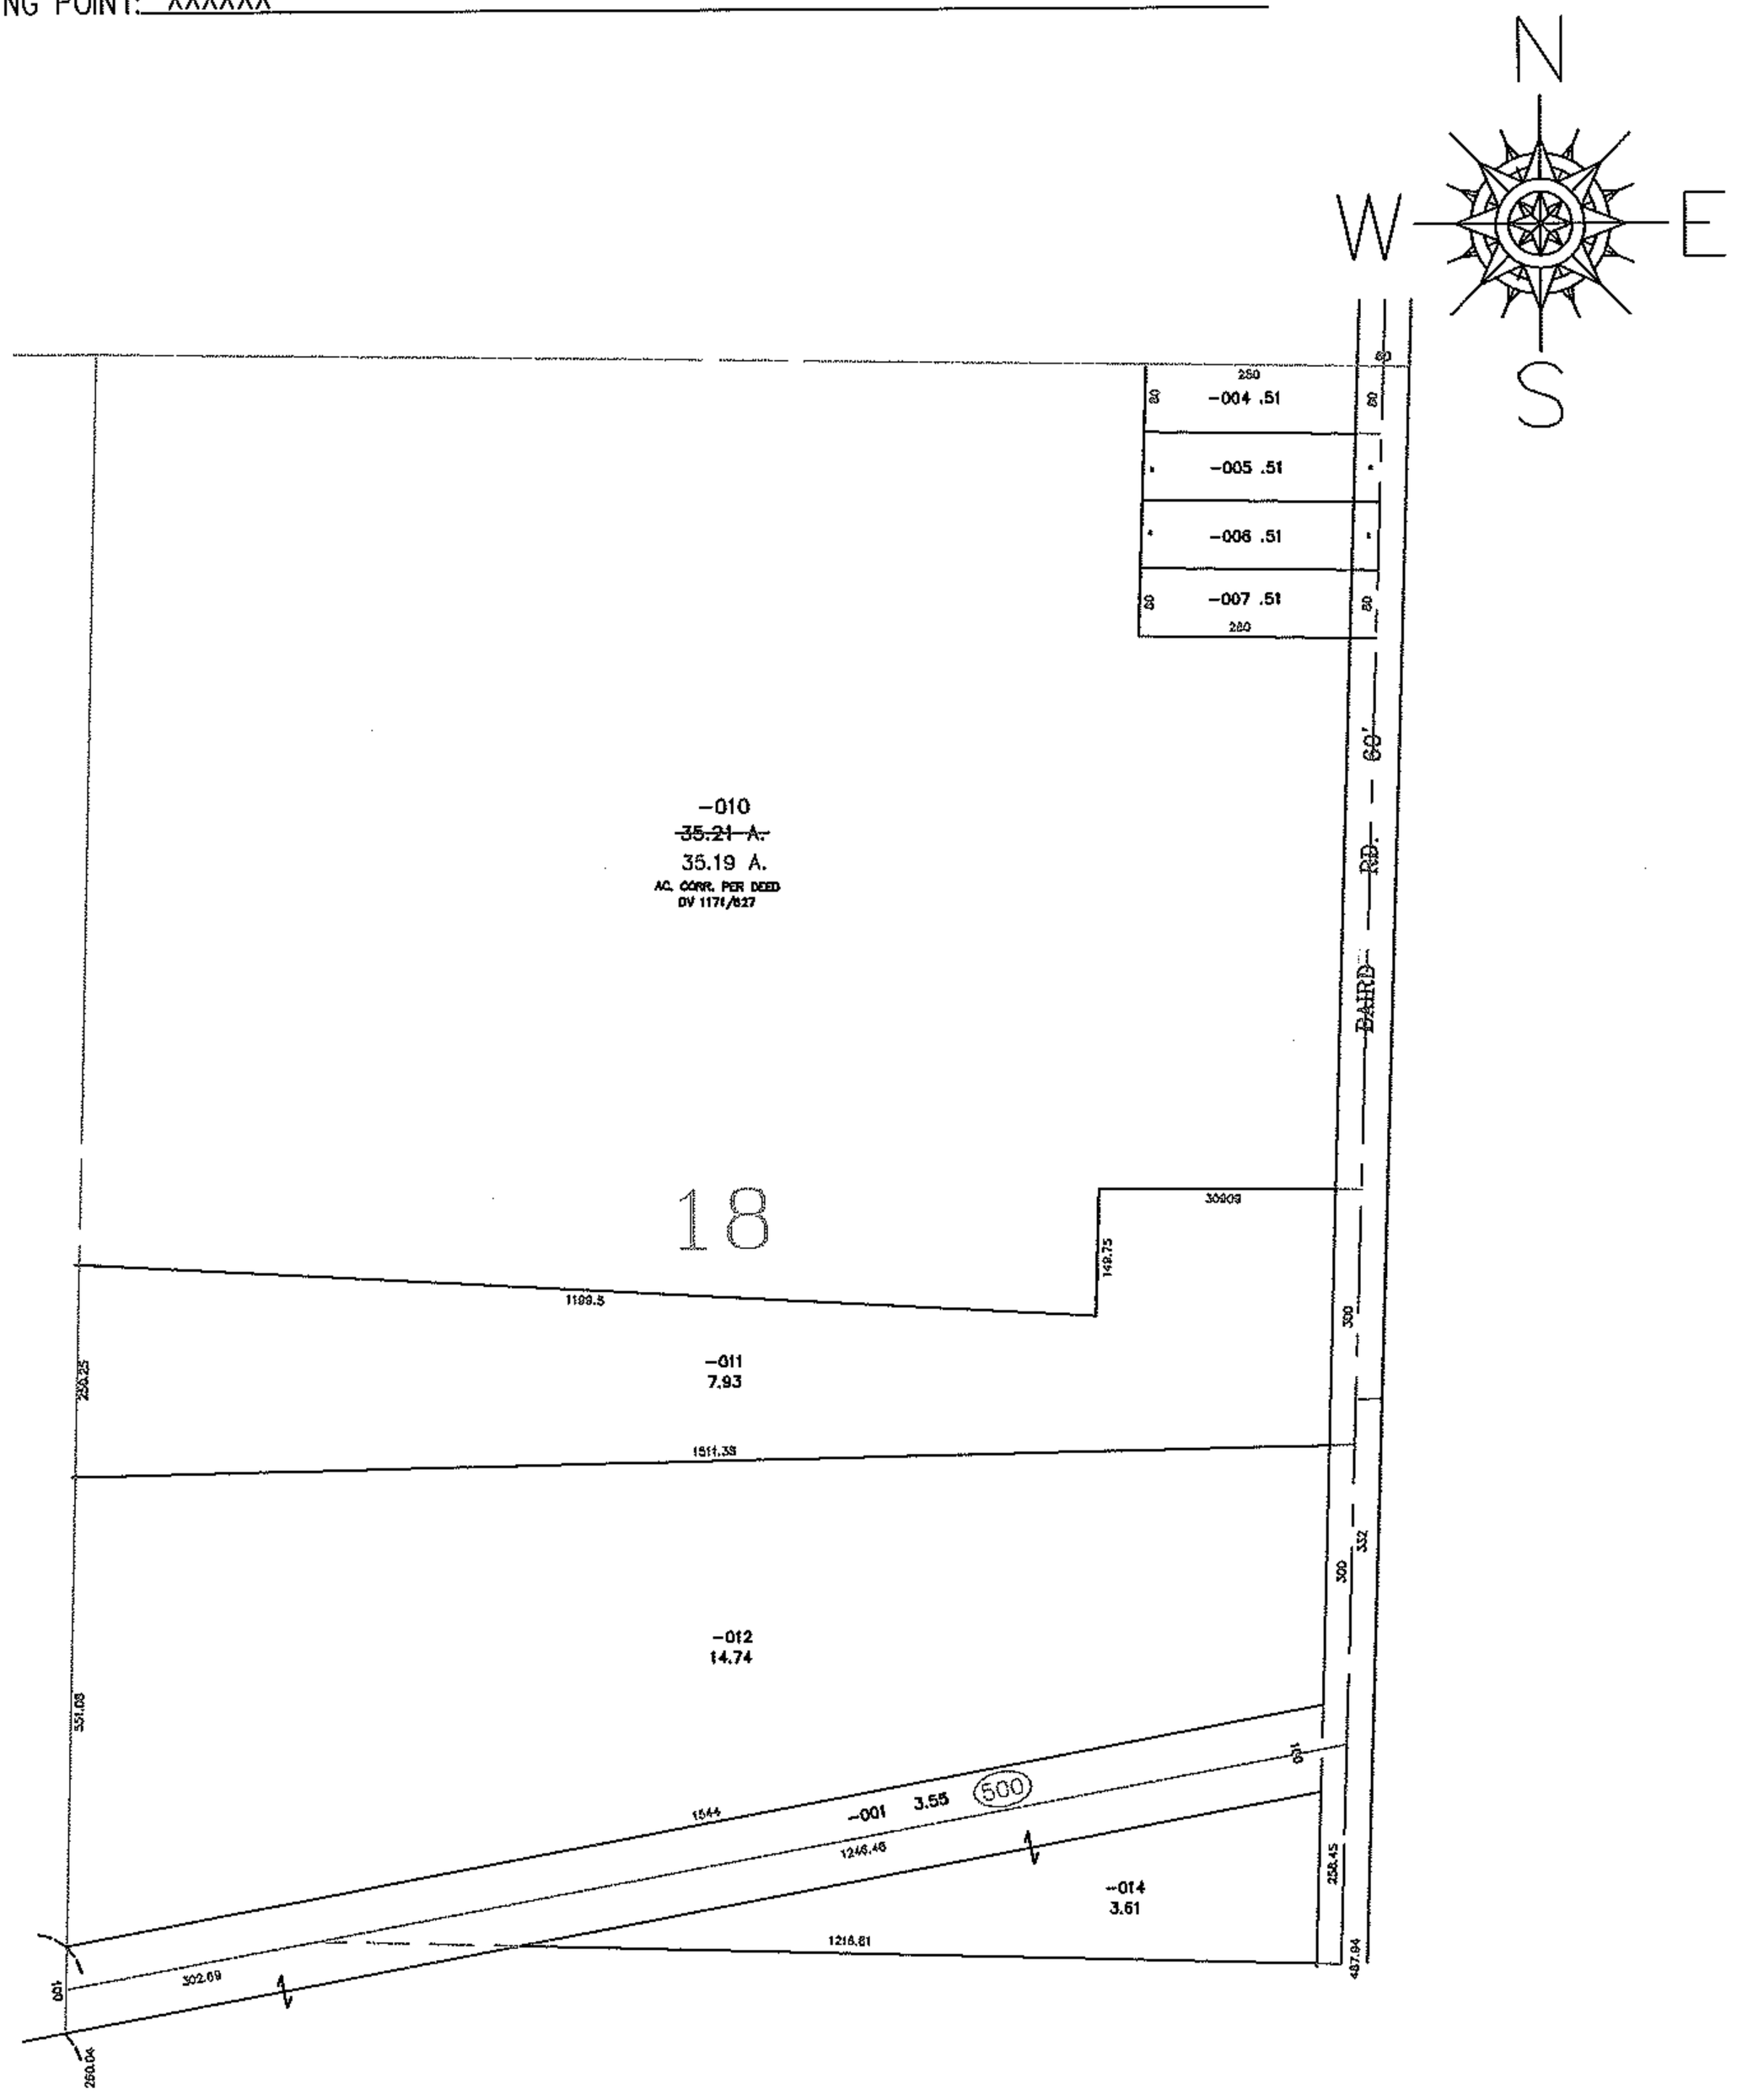

SPLITS/DEEDS PROCESSED

LORAIN COUNTY TAX MAP DEPARTMENT
226 MIDDLE AVE. ELYRIA, OHIO

SURVEYED BY: NONE

CLOSURE: NONE

MAP PAGE(S): 13-B

APPROVED BY: TJS DATE: 1/10/13

SCALE: 1"= 300 PRIOR INSTRUMENT: DV 1171/627