RASTER

PARENT PARCEL: 11-00-027-000-026, -017, -038

CHILD PARCEL: 11-00-027-000-040 THRU -042

STARTING POINT: CENTERLINE OF ISLAND RD & COOLEY RD

08-02649

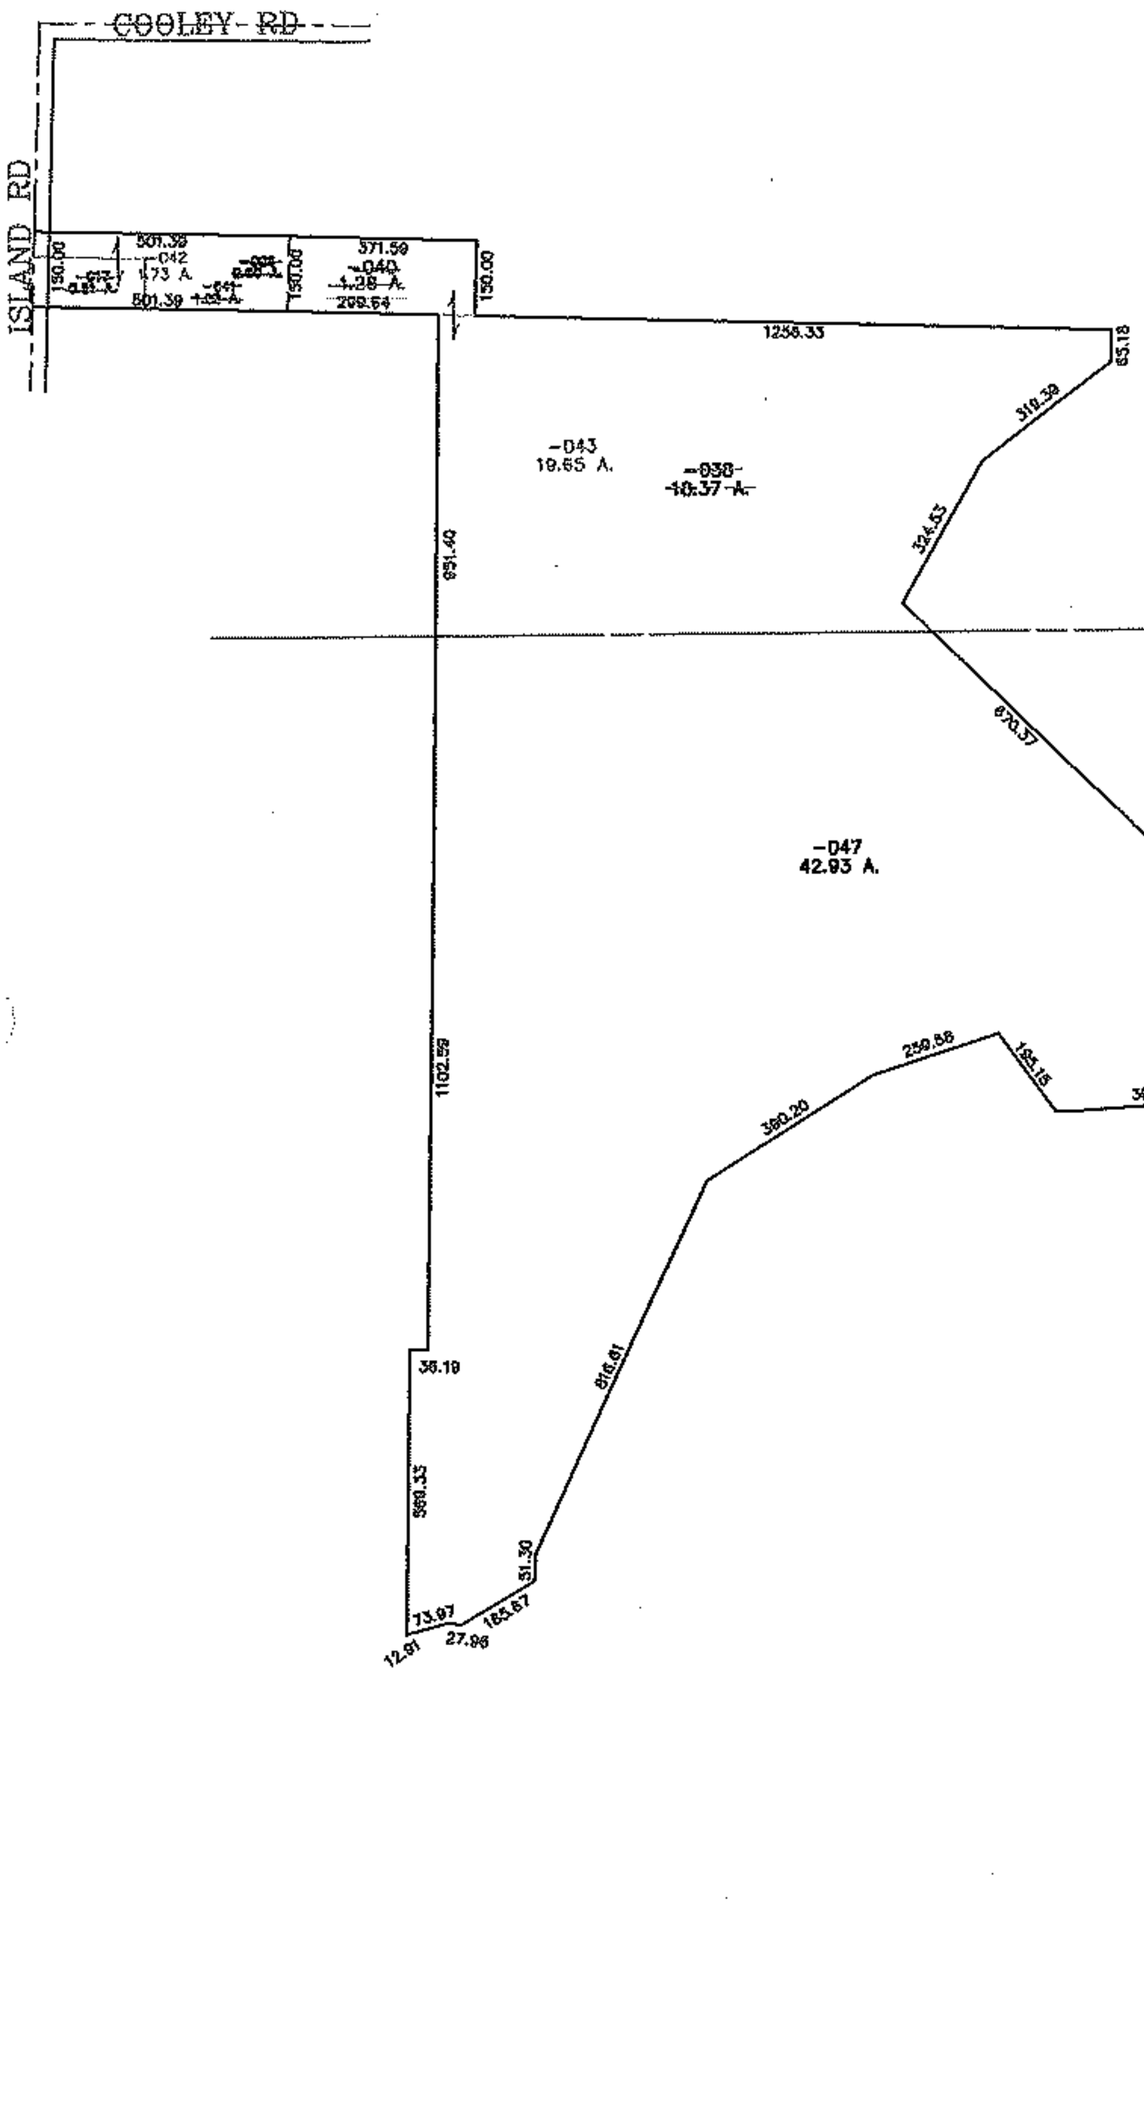

N

W E

S

SPLITS/DEEDS PROCESSED

LORAIN COUNTY TAX MAP DEPARTMENT
226 MIDDLE AVE. ELYRIA, OHIO

SURVEYED BY: CARL ANDERSON

CLOSURE: 0.00 : 10,000

MAP PAGE(S): 11-00-027-A

APPROVED BY: JAH DATE: 12-12-08

SCALE: 1"= 600 PRIOR INSTRUMENT: 20040037177