RASTER

PARENT PARCEL: *SEE BELOW

CHILD PARCEL:

STARTING POINT: CENTERLINE OF LAGRANGE RD & O.L.10

09-02656

19-05-010-000-002
19-05-0008-000-007
19-05-012-000-003
19-05-011-000-001
19-04-003-000-003

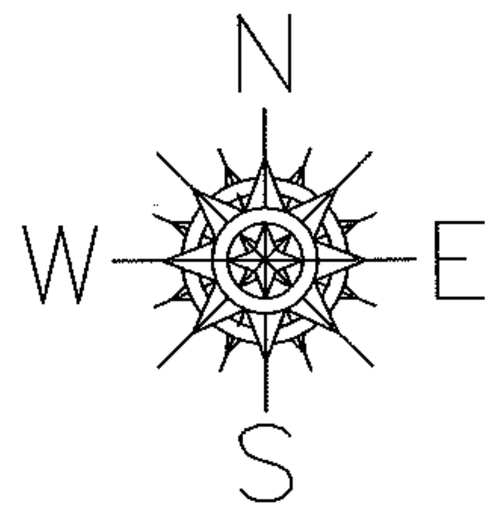

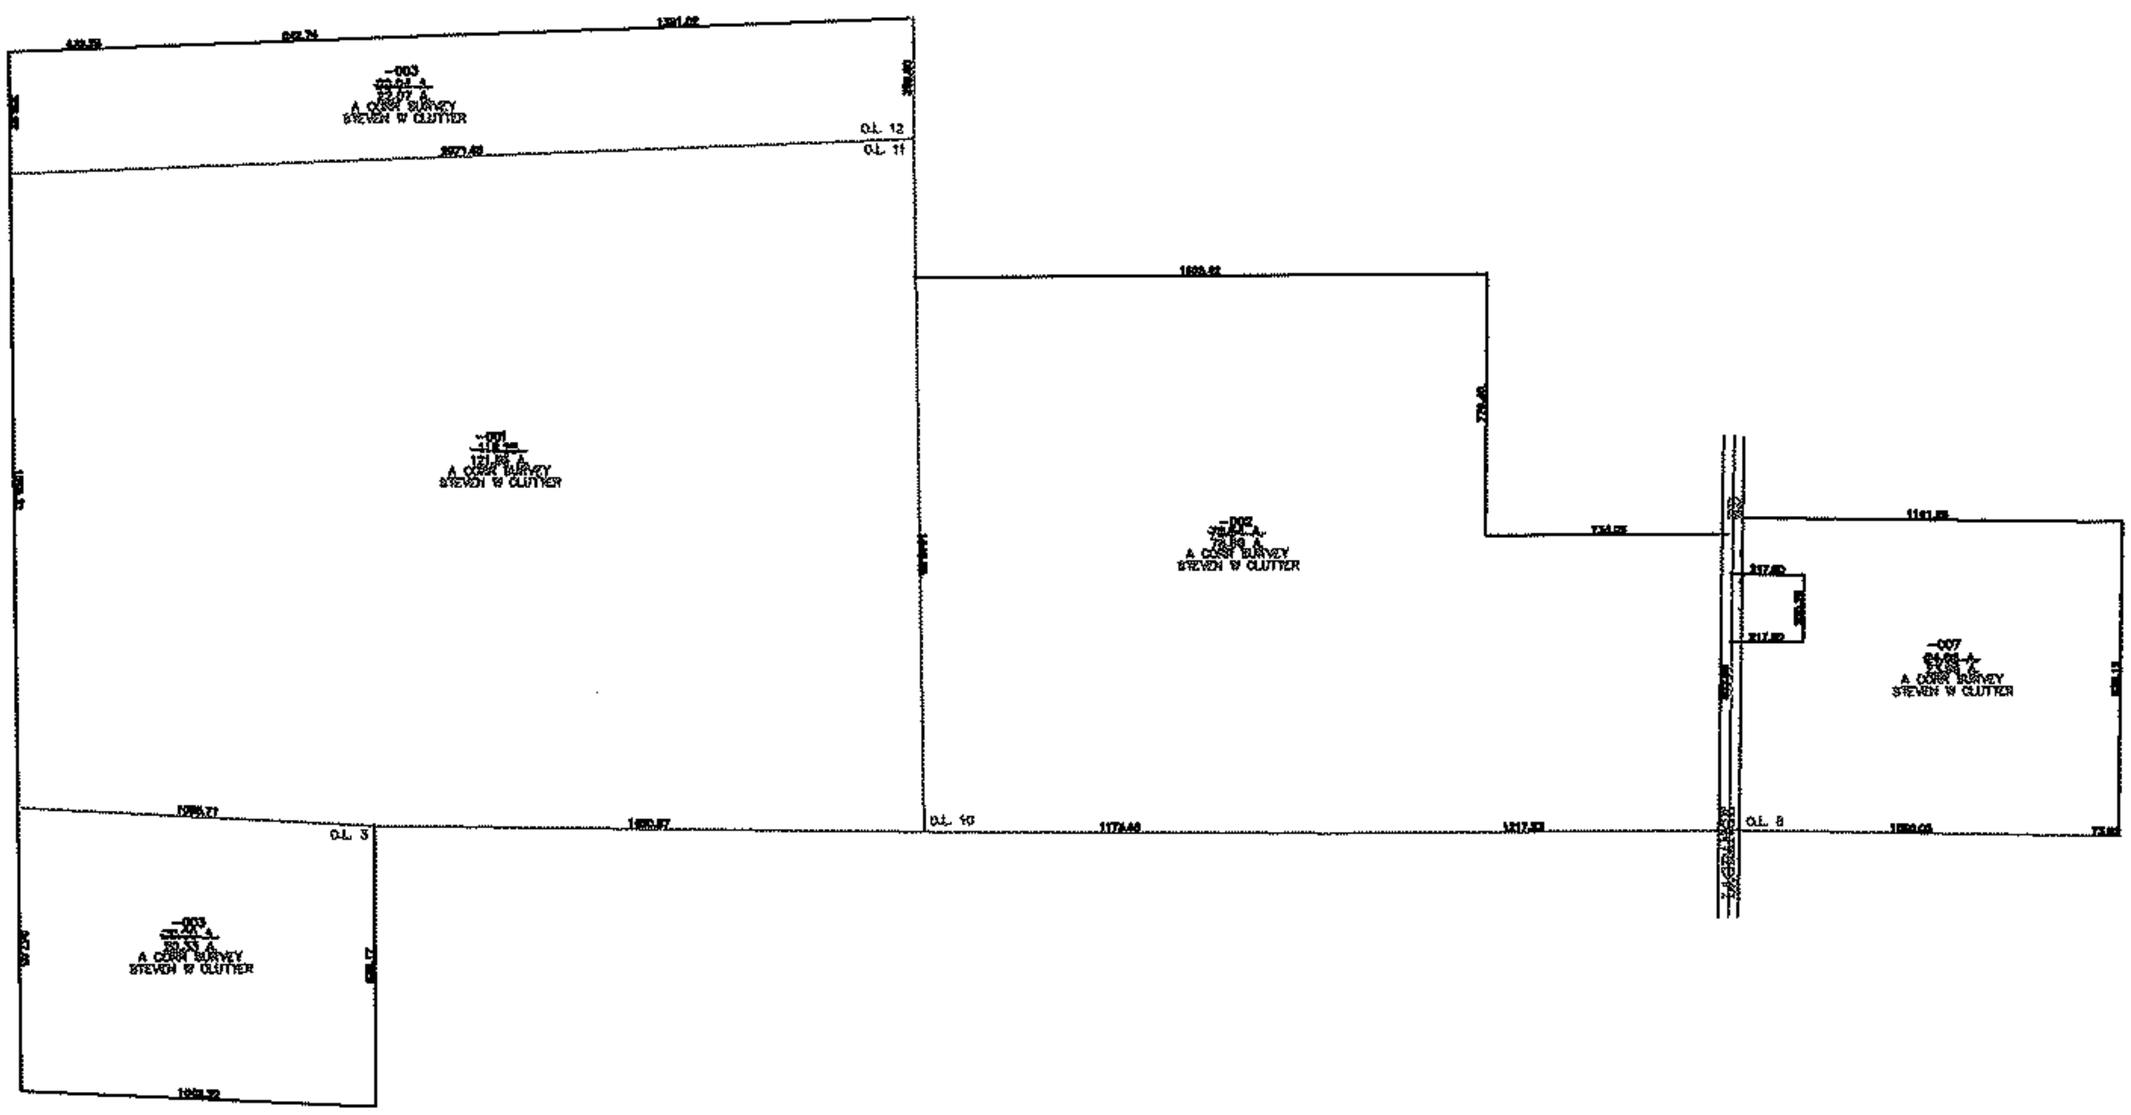

SPLITS/DEEDS PROCESSED

LORAIN COUNTY TAX MAP DEPARTMENT
226 MIDDLE AVE. ELYRIA, OHIO

SURVEYED BY: STEVEN W CLUTTER
CLOSURE: 0.00 : 10,000
MAP PAGE(S): 19-4, 19-B
APPROVED BY: JAH DATE: 1-19-09
SCALE: 1"= 900 PRIOR INSTRUMENT: DV 1375/743