RASTER

PARENT PARCEL: 15-00-033-000-016, -015, -006
CHILD PARCEL: 15-00-033-000-019 THRU -024
STARTING POINT: CENTERLINE OF WHEELER RD & O.L. 33

09-02666

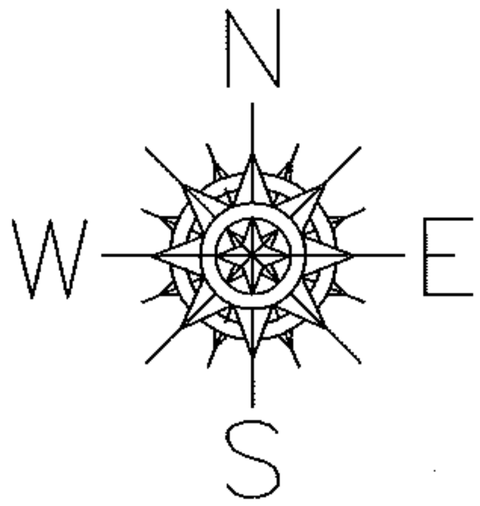

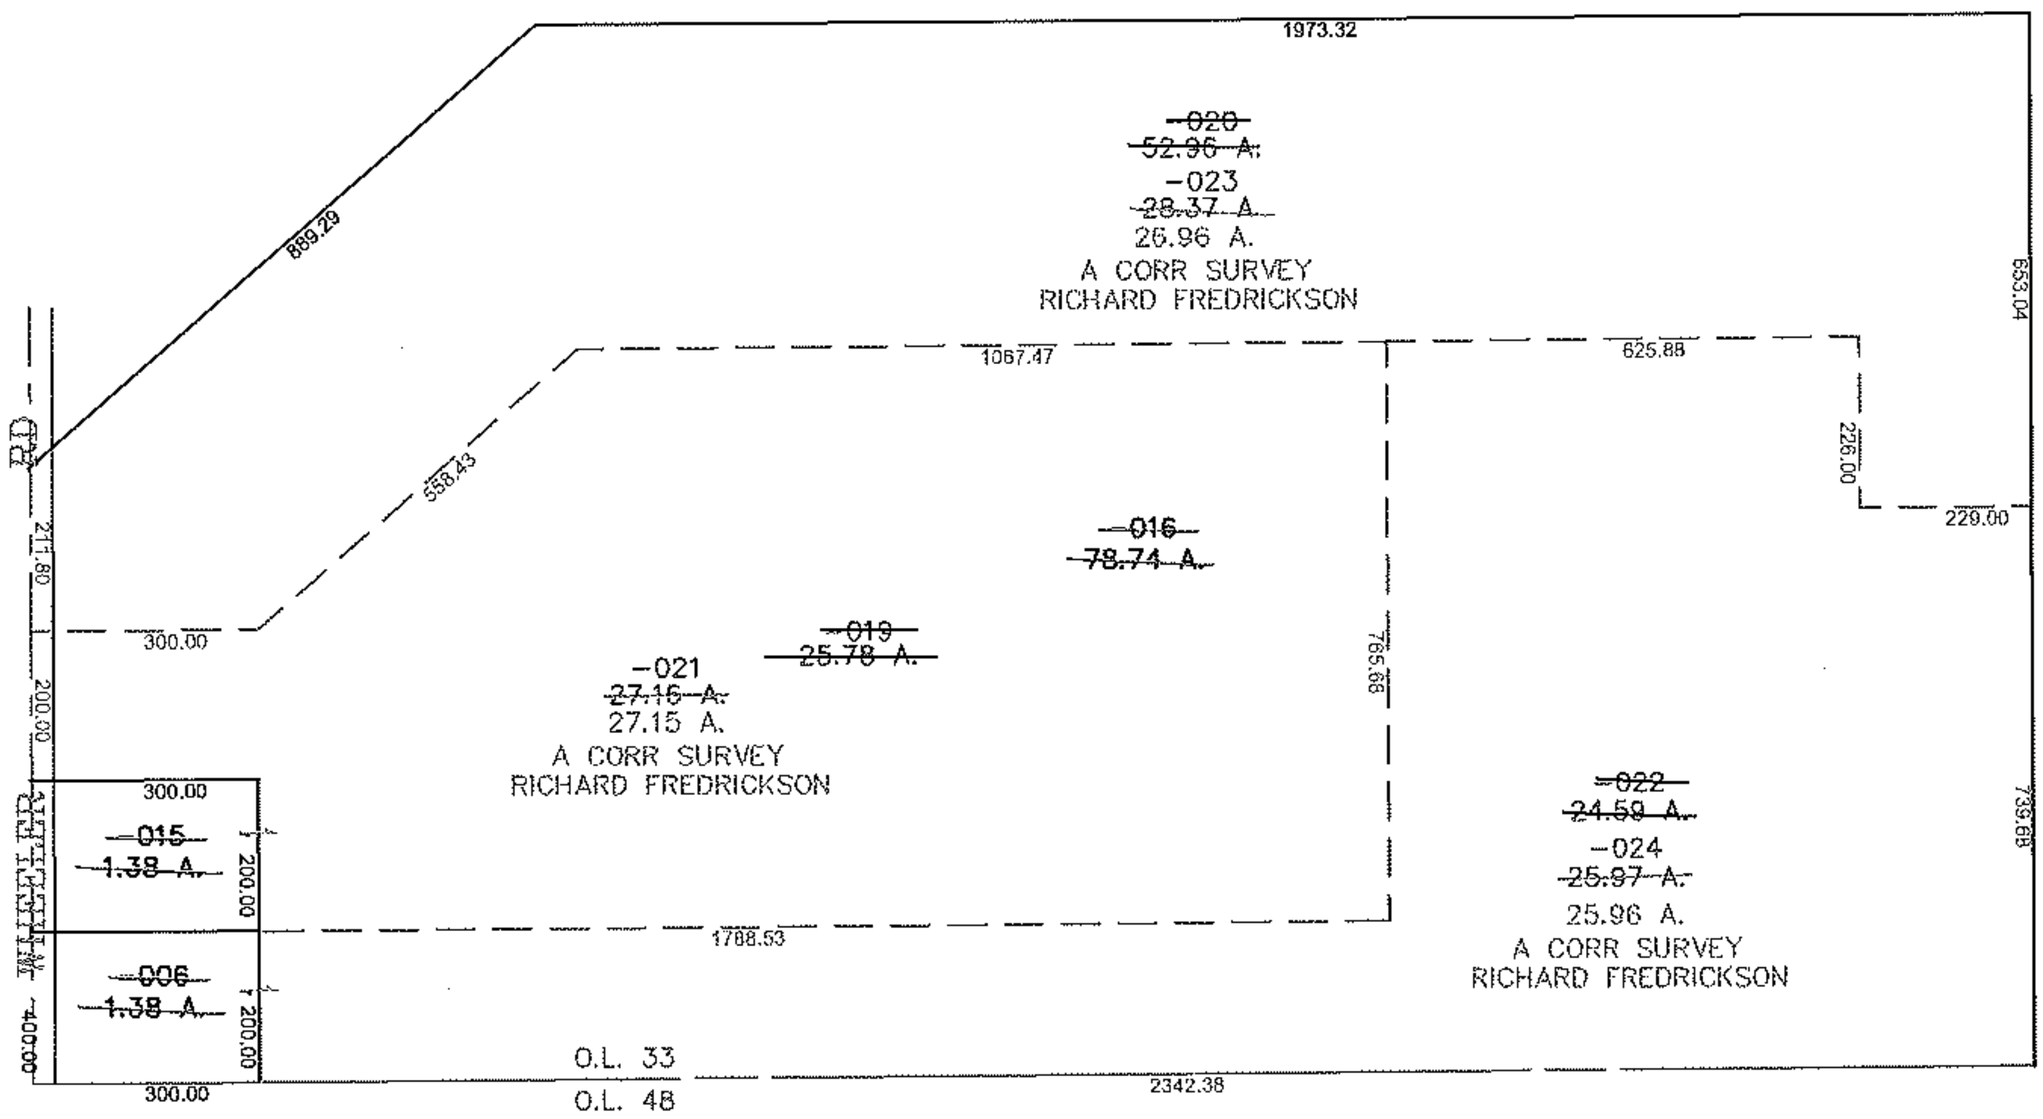

SPLITS/DEEDS PROCESSED

LORAIN COUNTY TAX MAP DEPARTMENT
226 MIDDLE AVE. ELYRIA, OHIO

SURVEYED BY: RICHARD FREDRICKSON
CLOSURE: 0.00 : 10,000
MAP PAGE(S): 15-D
APPROVED BY: JAH DATE: 2-18-09
SCALE: 1"= 400 PRIOR INSTRUMENT: 20000680988