RASTER

PARENT PARCEL: 02-02-008-107-048, -041

CHILD PARCEL: 02-02-008-107-049 THRU -052

STARTING POINT: CENTERLINE OF JAEGER RD & O.L. 8

09-02674

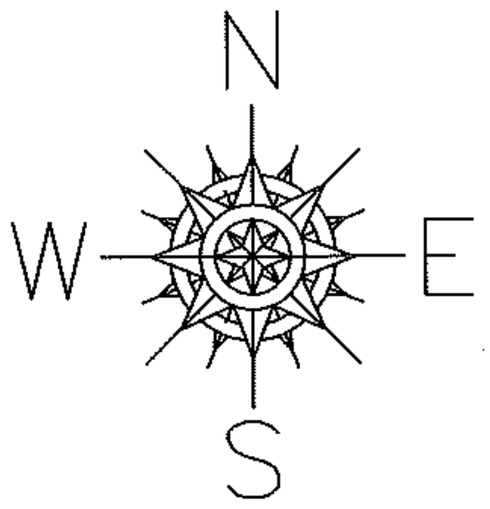

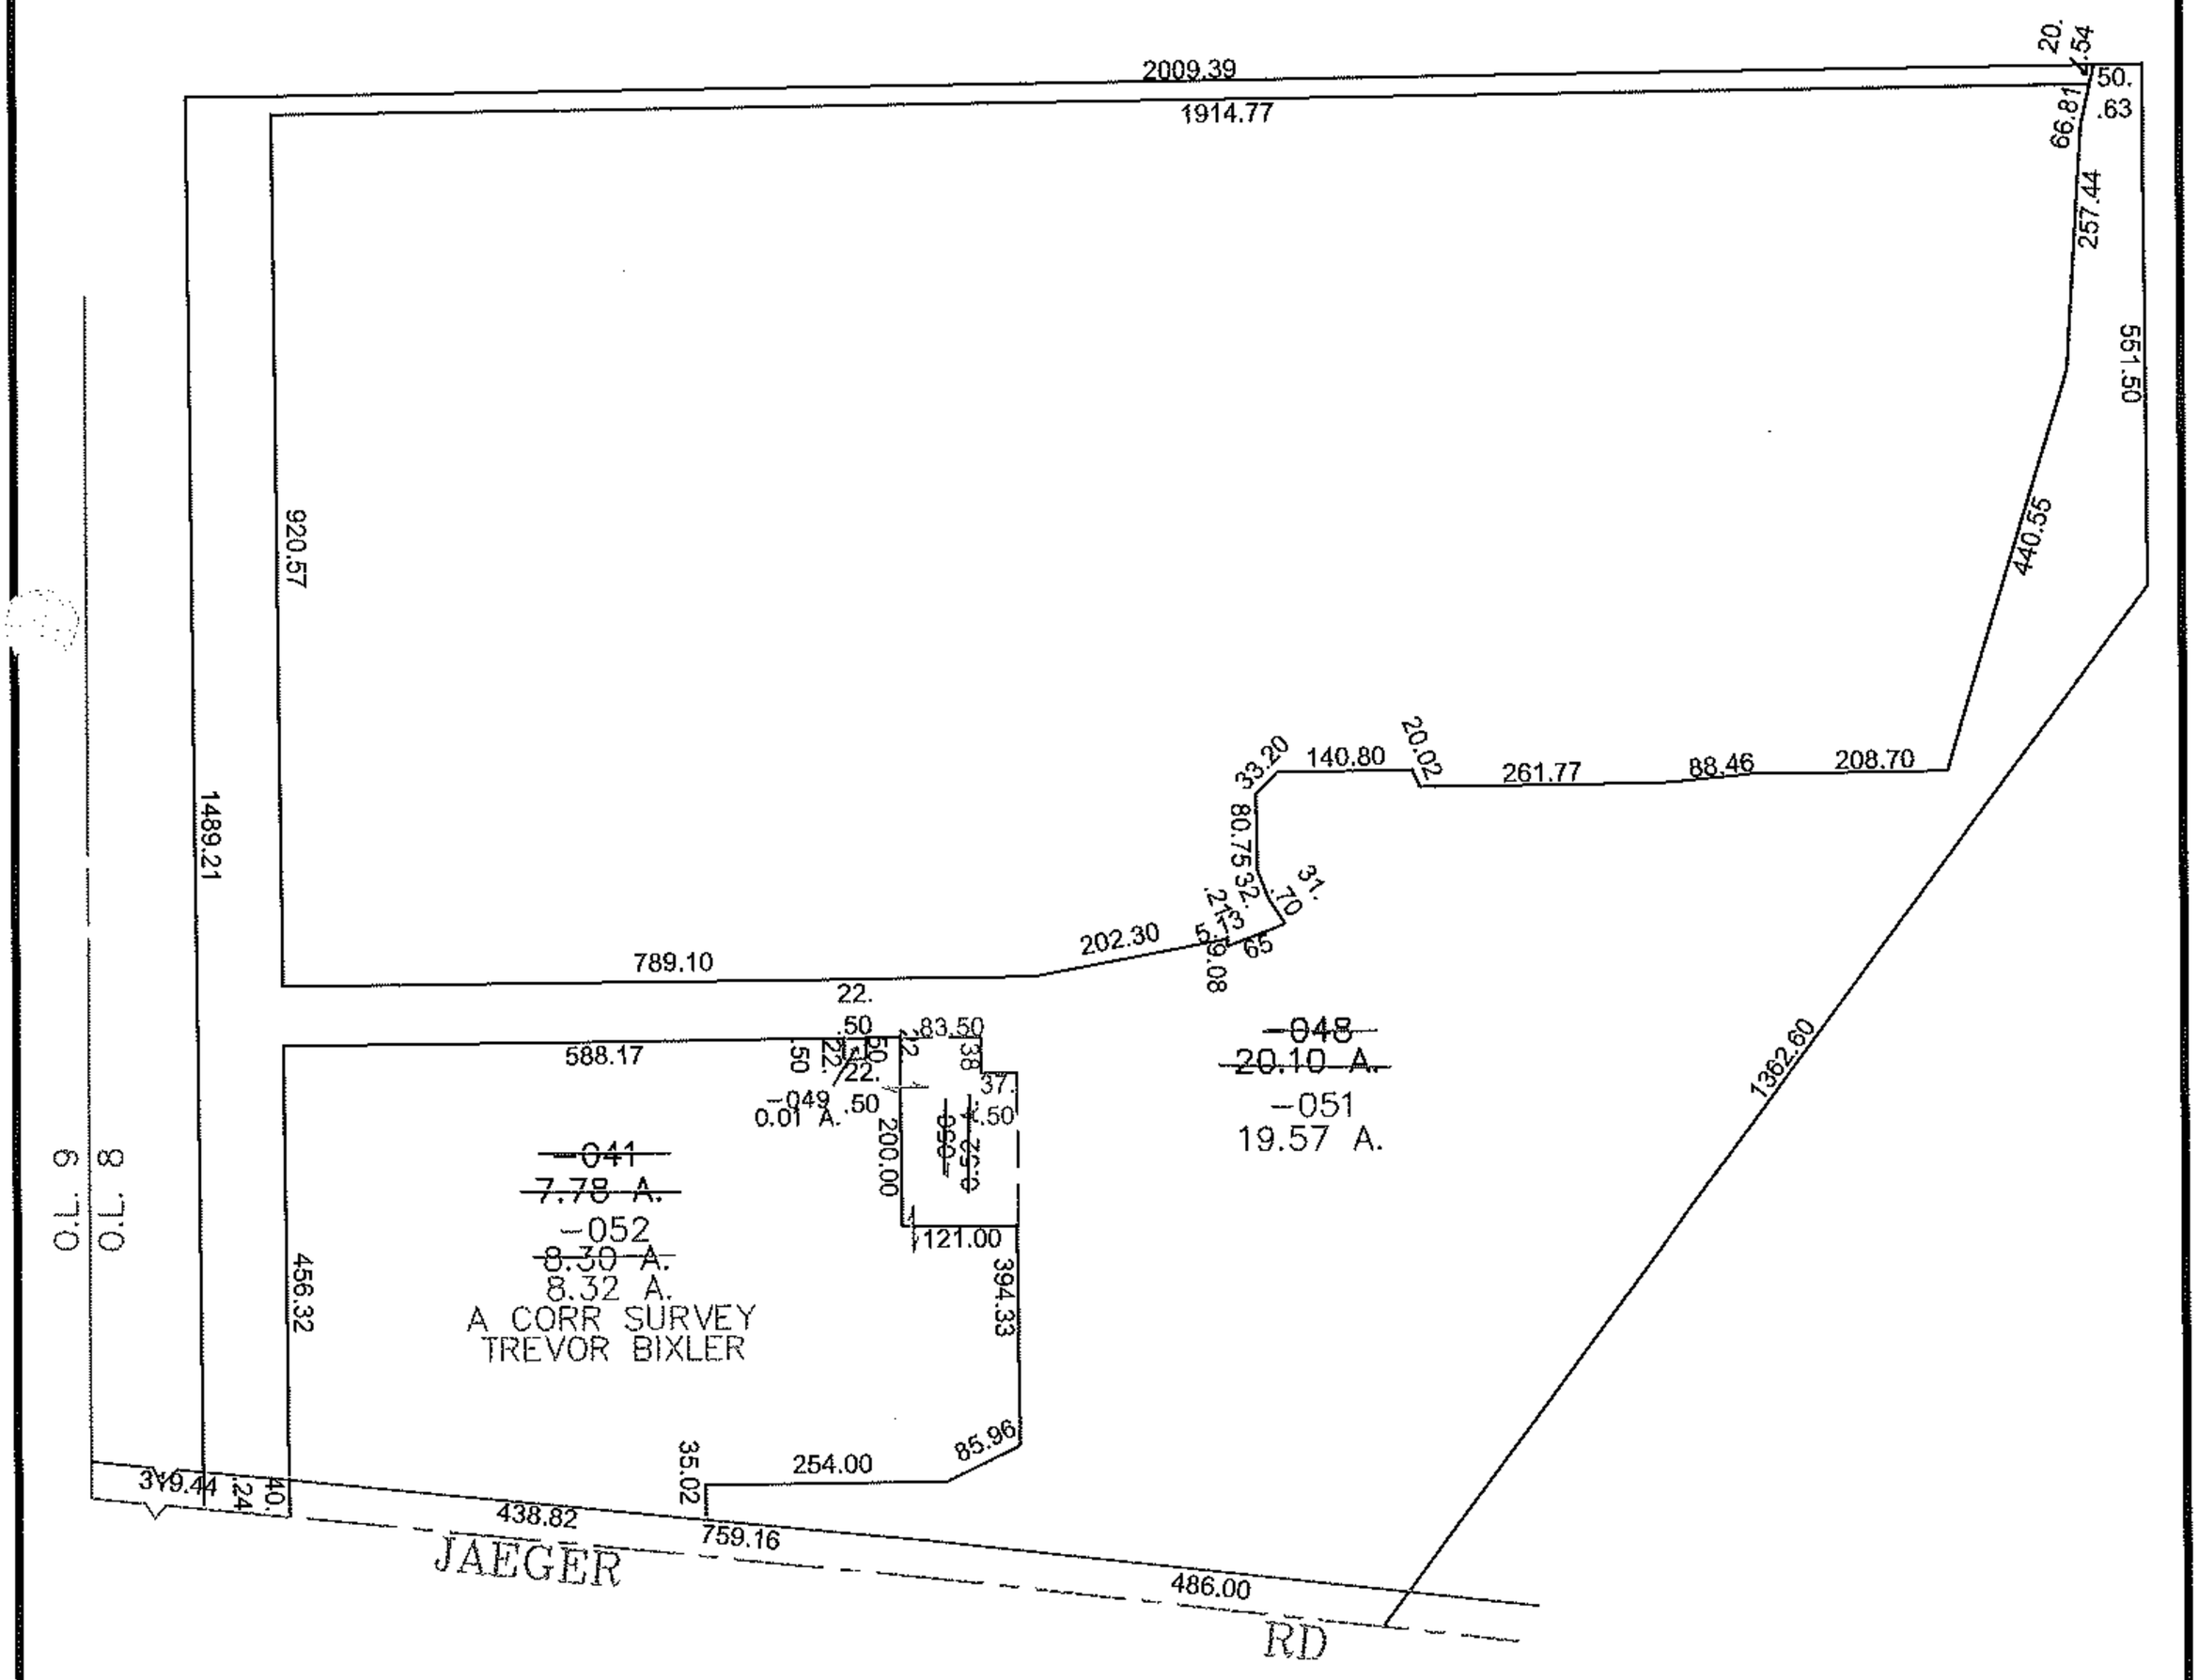

SPLITS/DEEDS PROCESSED

LORAIN COUNTY TAX MAP DEPARTMENT
226 MIDDLE AVE. ELYRIA, OHIO

SURVEYED BY: TREVOR BIXLER

CLOSURE: 0.00 : 10,000

MAP PAGE(S): 02-02-008-A, B

APPROVED BY: JAH DATE: 3-10-09

SCALE: 1"= 300 PRIOR INSTRUMENT: 20080246575