RASTER

PARENT PARCEL: 03-00-104-101-001 03-00-099-113-001 03-00-105-105-001

CHILD PARCEL: *SEE BELOW

STARTING POINT: CL OF CLINTON AVE & SOUTHERLY LINE OF OAKWOOD ACRES SUND NO 4

09-02689

* 03-00-104-101-041
03-00-105-105-002
03-00-099-113-003
03-00-100-114-039
03-00-104-101-042
03-00-105-105-003

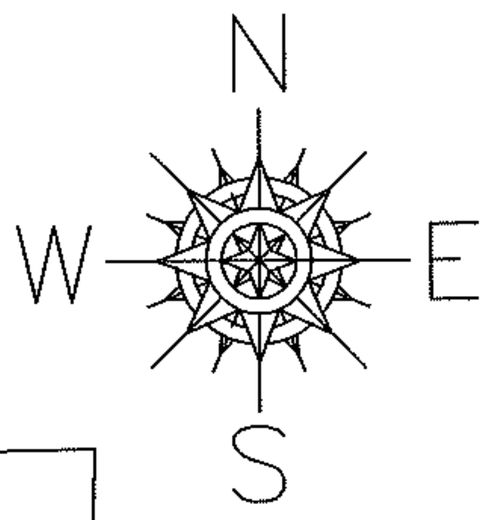

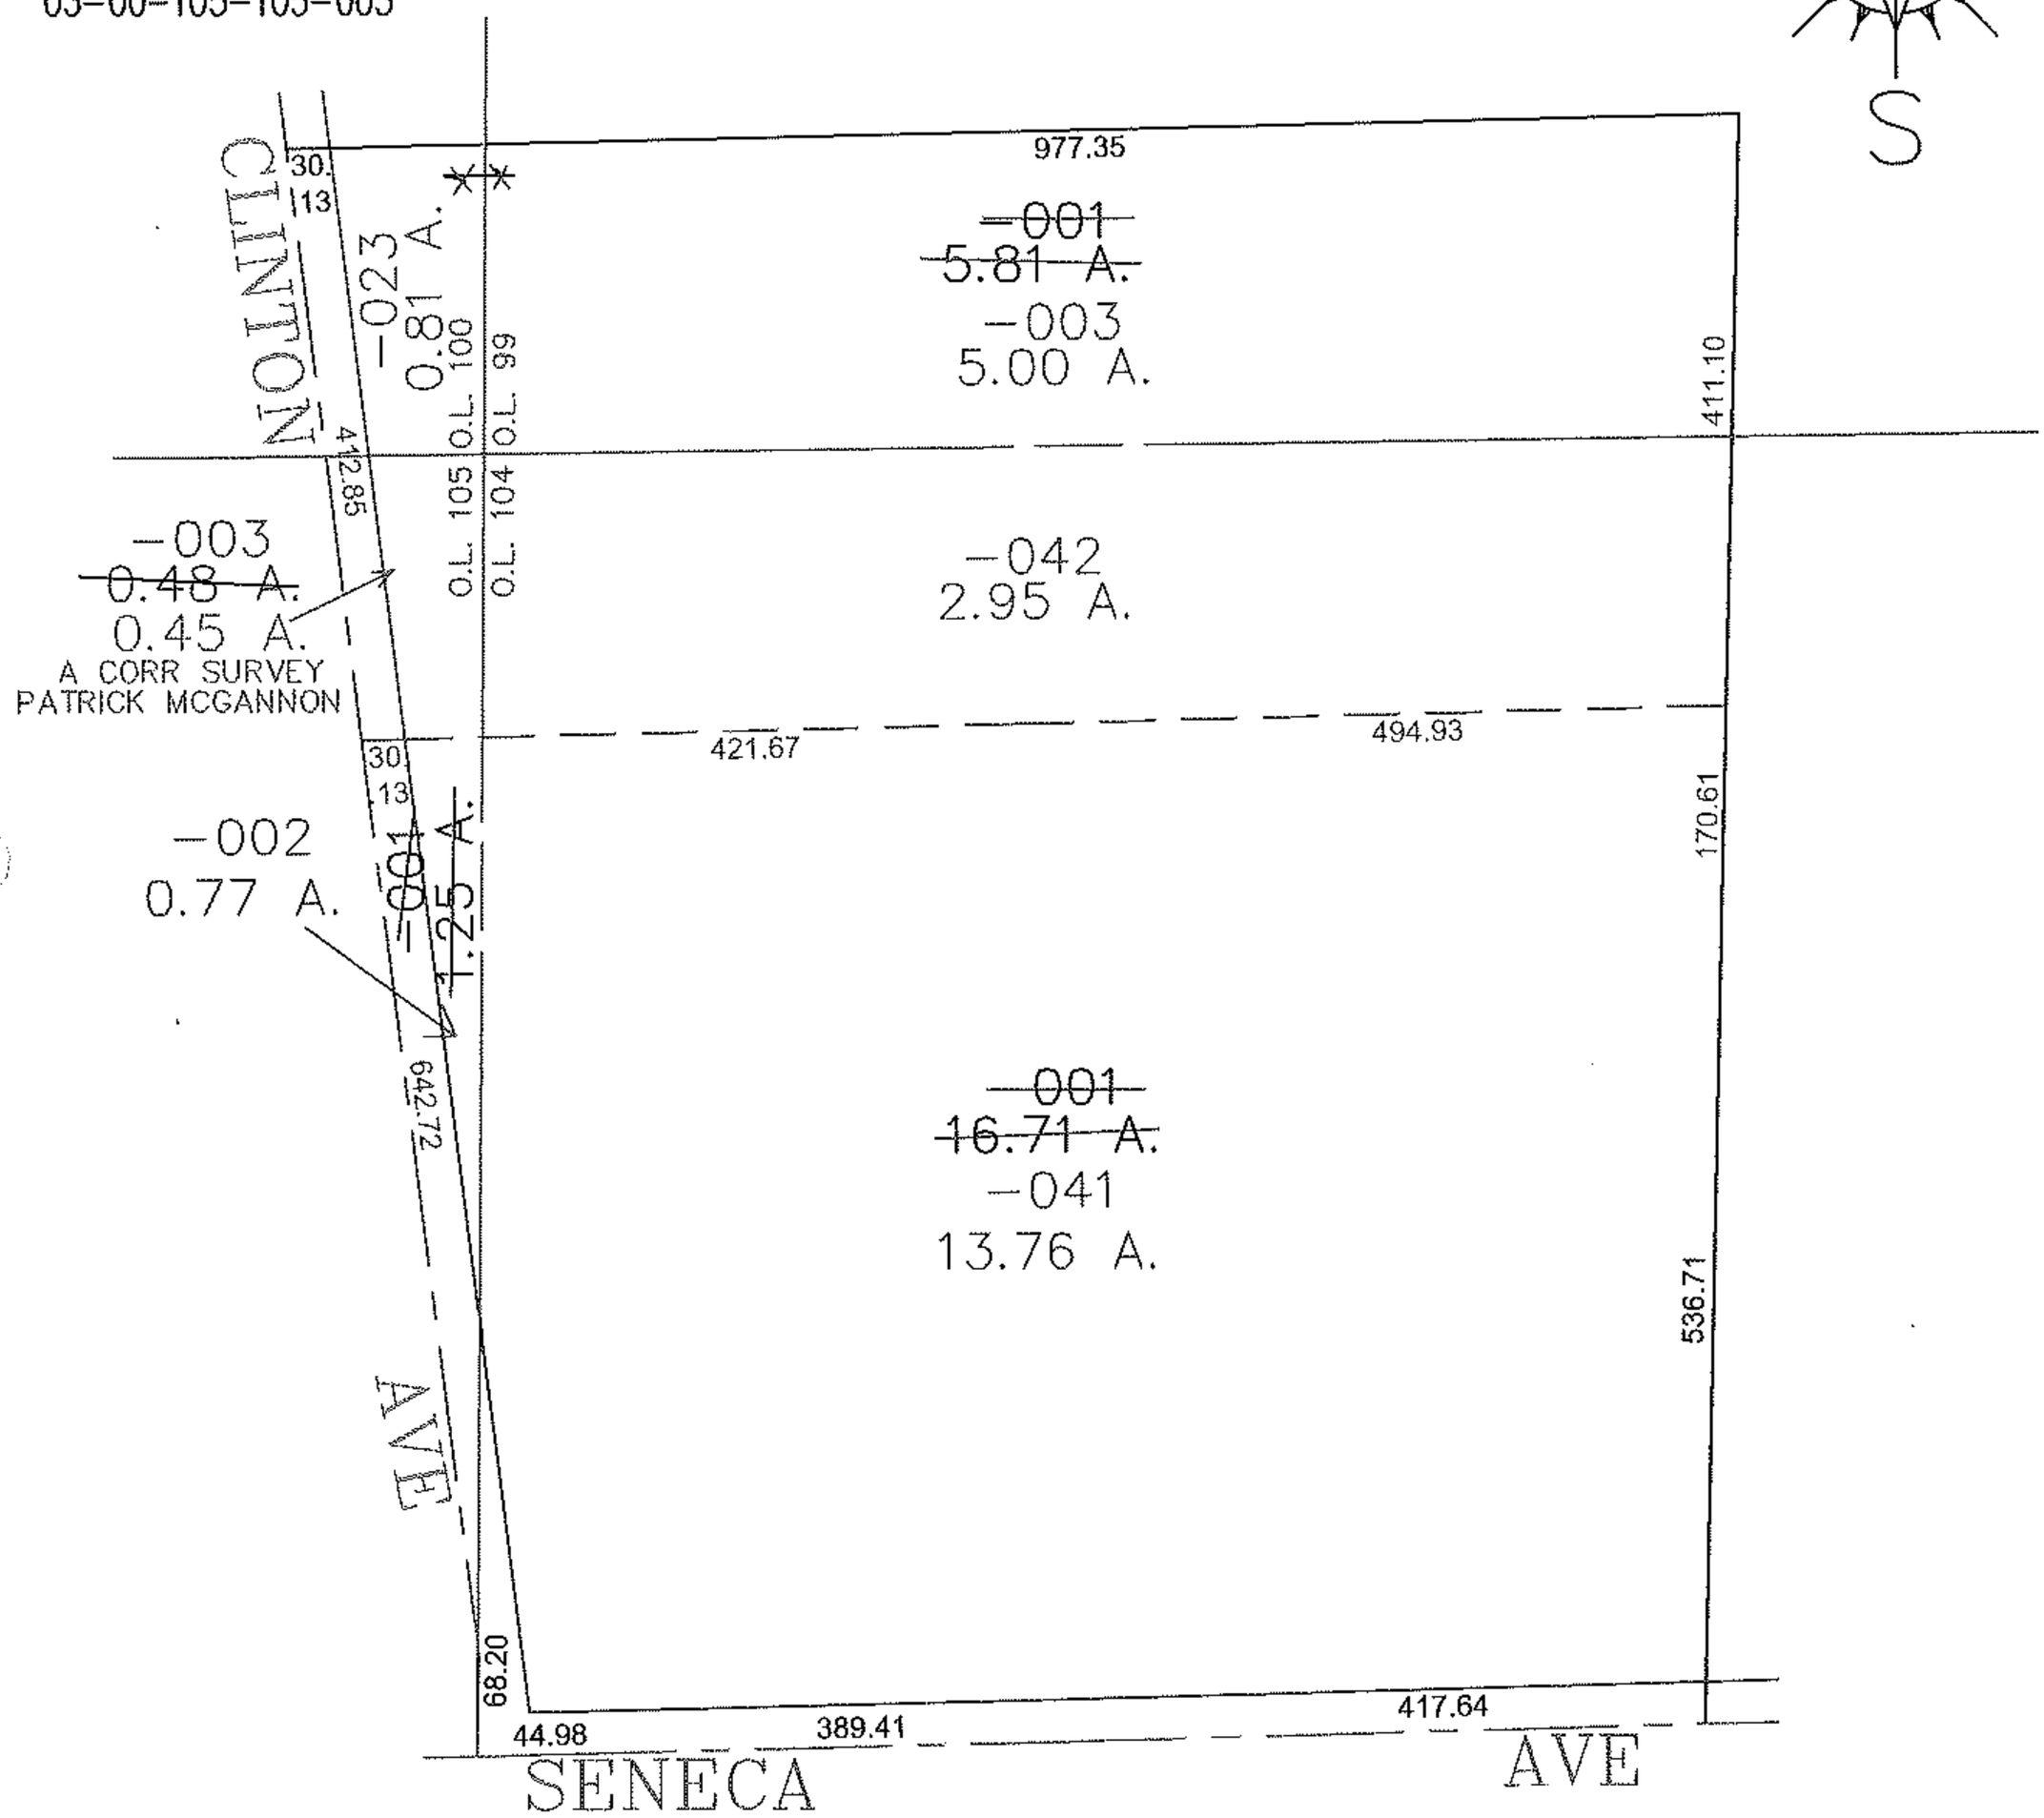

SPLITS/DEEDS PROCESSED

LORAIN COUNTY TAX MAP DEPARTMENT
226 MIDDLE AVE. ELYRIA, OHIO

SURVEYED BY: PATRICK MCGANNON
CLOSURE: 0.00 : 10,000
MAP PAGE(S): 03-00-104-A
APPROVED BY: JAH DATE: 4-28-09
SCALE: 1"= 200 PRIOR INSTRUMENT: 20090292037