RASTER

PARENT PARCEL: 08-12-012-000-051

CHILD PARCEL: 08-12-012-000-058, -059

STARTING POINT: CENTERLINE OF GORE ORPHANAGE RD & BECKER RD

09-02697

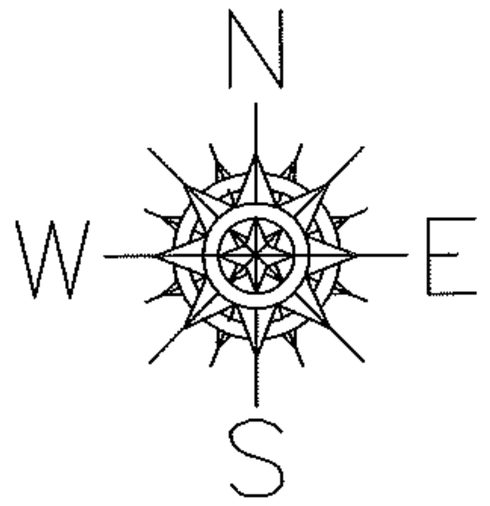

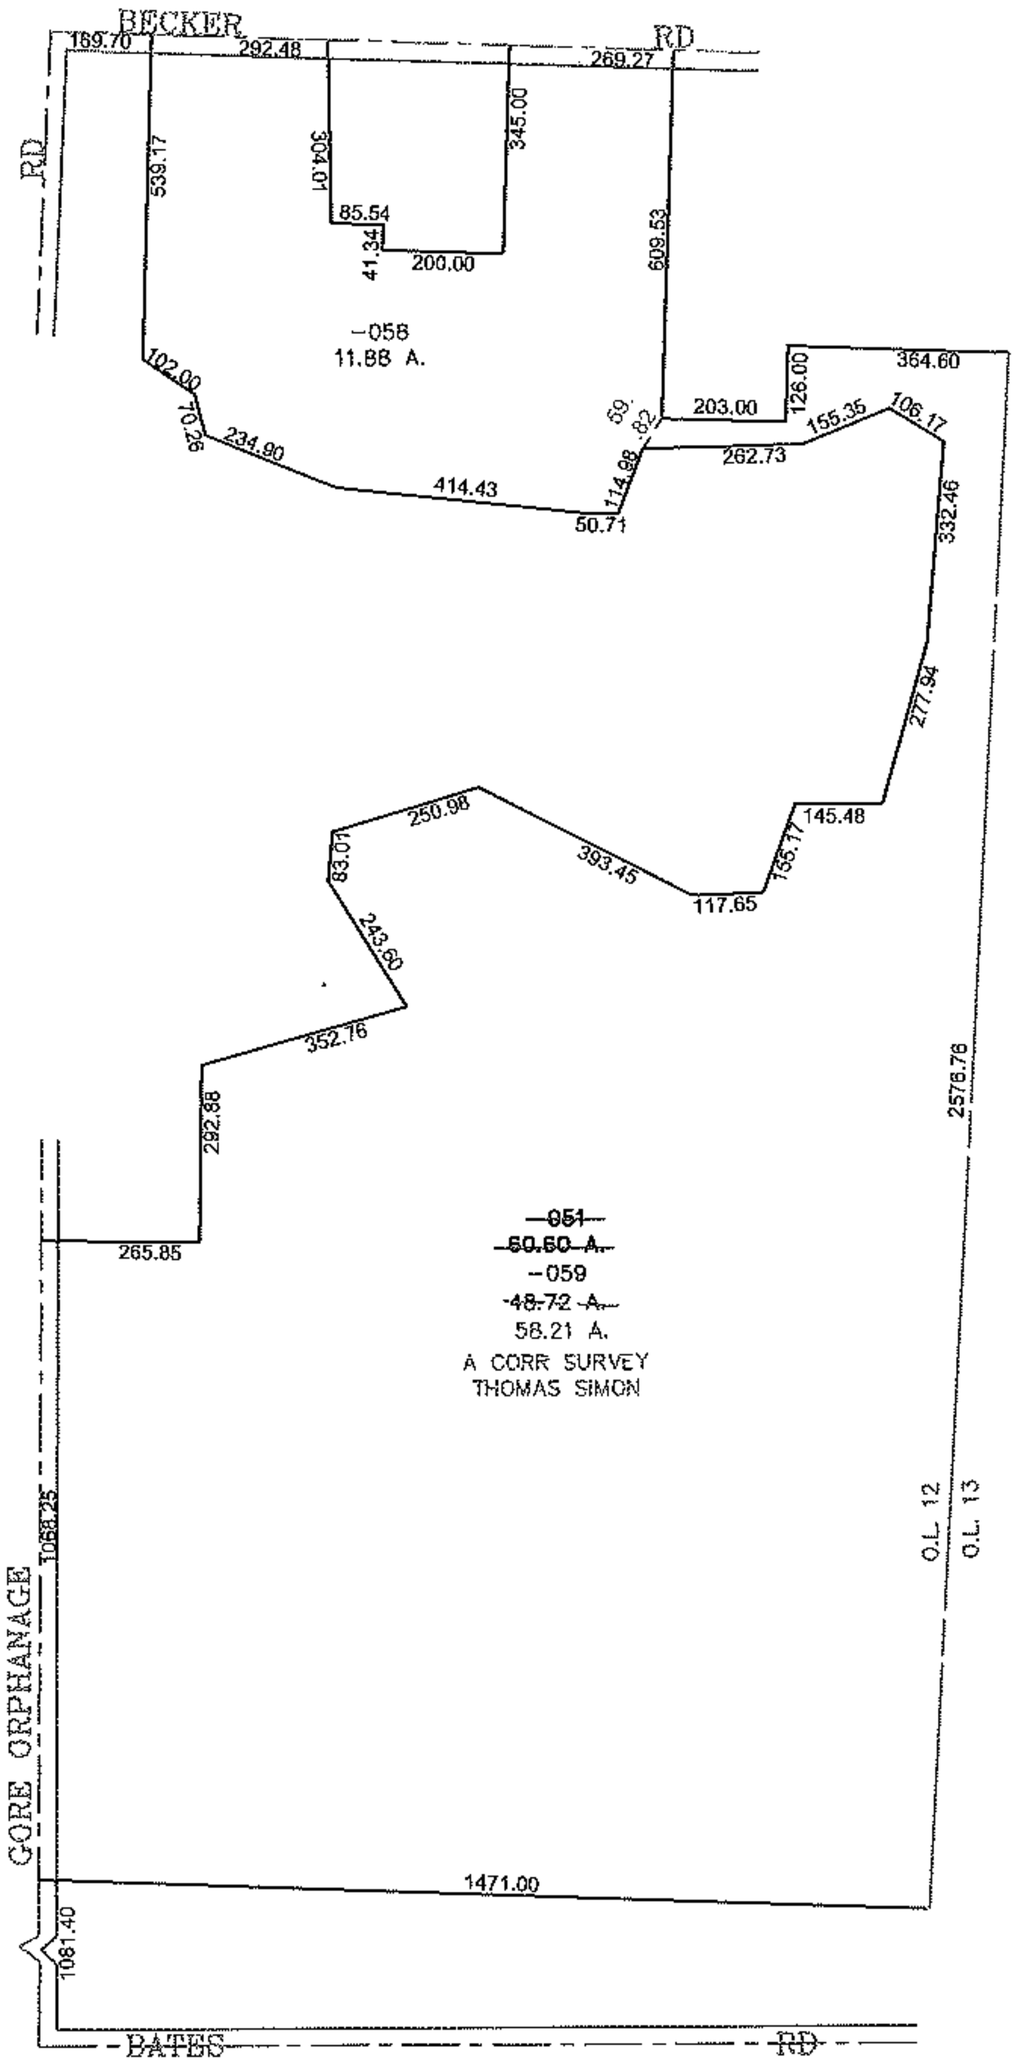

SPLITS/DEEDS PROCESSED

LORAIN COUNTY TAX MAP DEPARTMENT
226 MIDDLE AVE. ELYRIA, OHIO

SURVEYED BY: THOMAS SIMON

CLOSURE: 0.00 : 10,000

MAP PAGE(S): 8-E

APPROVED BY: JAH DATE: 5-6-09

SCALE: 1"= 500 PRIOR INSTRUMENT: OR 718/475