RASTER

PARENT PARCEL: 06-23-010-101-041 & 06-23-010-102-024
CHILD PARCEL: 06-23-010-101-050, -051, -052 & 06-23-010-102-025, -026
STARTING POINT: SW CORNER OF O.L. 10

09-02717

N
W E
S

AC. CORR.
PER SURVEY
T. SIMON

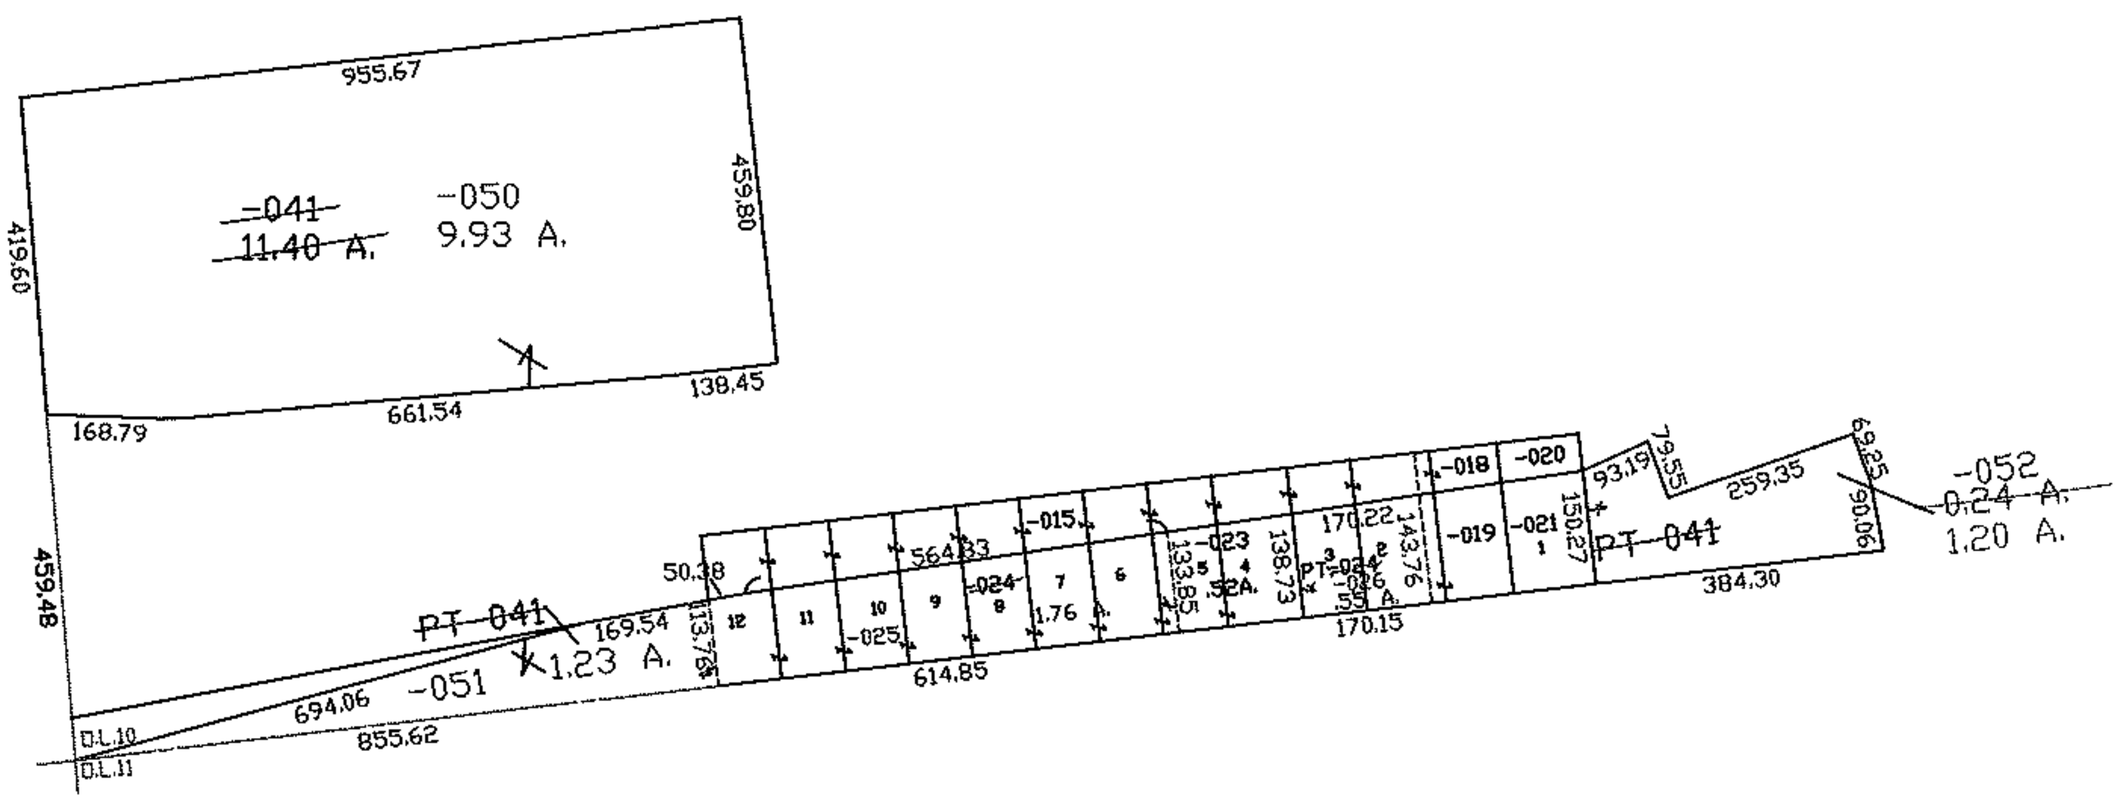

SPLITS/DEEDS PROCESSED
LORAIN COUNTY TAX MAP DEPARTMENT
226 MIDDLE AVE. ELYRIA, OHIO

SURVEYED BY: THOMAS A. SIMON
CLOSURE: 1:10,000
MAP PAGE(S): 06-24
APPROVED BY: DRH DATE: 7/13/2009
SCALE: 1"= 400 PRIOR INSTRUMENT: