RASTER

PARENT PARCEL: 04-00-017-102-017, 056

CHILD PARCEL: 04-00-017-102-220

STARTING POINT: INT OF C/L OF AVON BELDEN RD. AND ALBION DR.

09-02720

N

W E

S

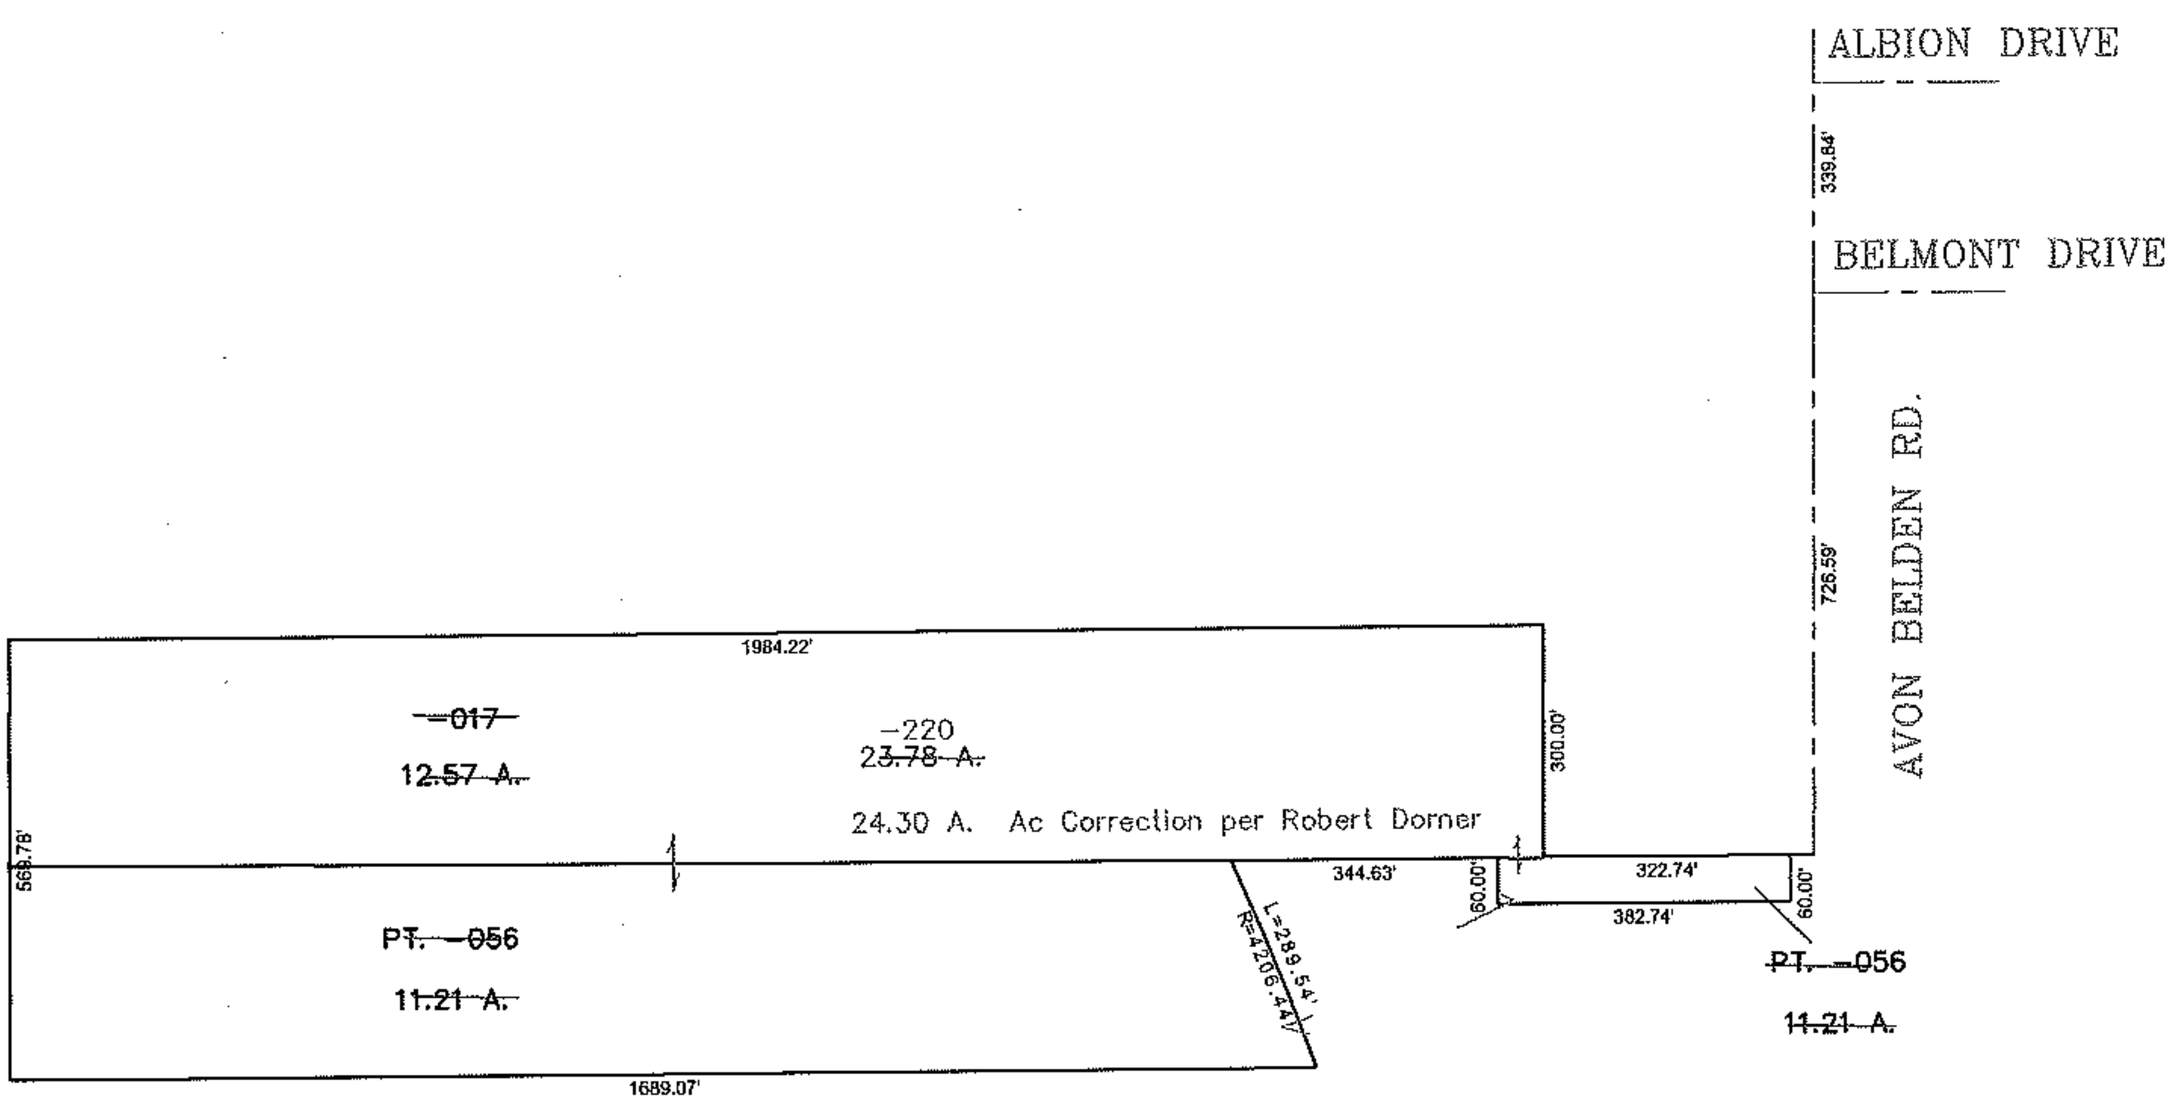

SPLITS/DEEDS PROCESSED

LORAIN COUNTY TAX MAP DEPARTMENT
226 MIDDLE AVE. ELYRIA, OHIO

SURVEYED BY: ROBERT A. DORNER

CLOSURE: 1:10,000

MAP PAGE(S): 04-00-017-F

APPROVED BY: MBK DATE: 7/14/2009

SCALE: 1"= 400 PRIOR INST.: 19940309137