PARENT PARCEL: 01-00-004-109-002

CHILD PARCEL: XX-XX-XXX-XXX-XXX

STARTING POINT: INT. OF WEST LINE OF O.L. 4 & OLD CL OF LIBERTY AVE.

13-02729-C

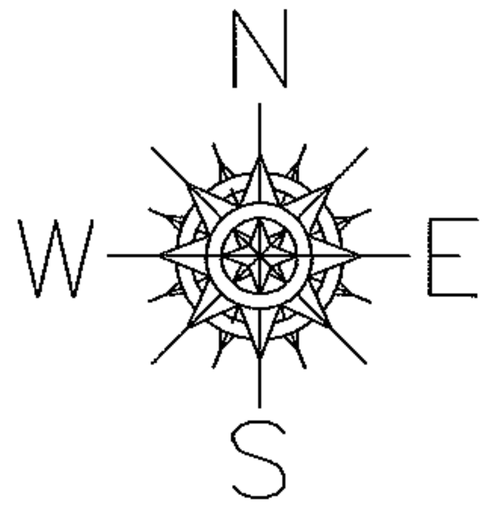


MAP CORRECTION/ ADD TO DUP.

01-00-004-109-002

0.25 A.

15' WIDE FROM OLD CL OF LIBERTY

TO THE SOUTH LINE OF NORFOLK & SOUTHERN R.R.

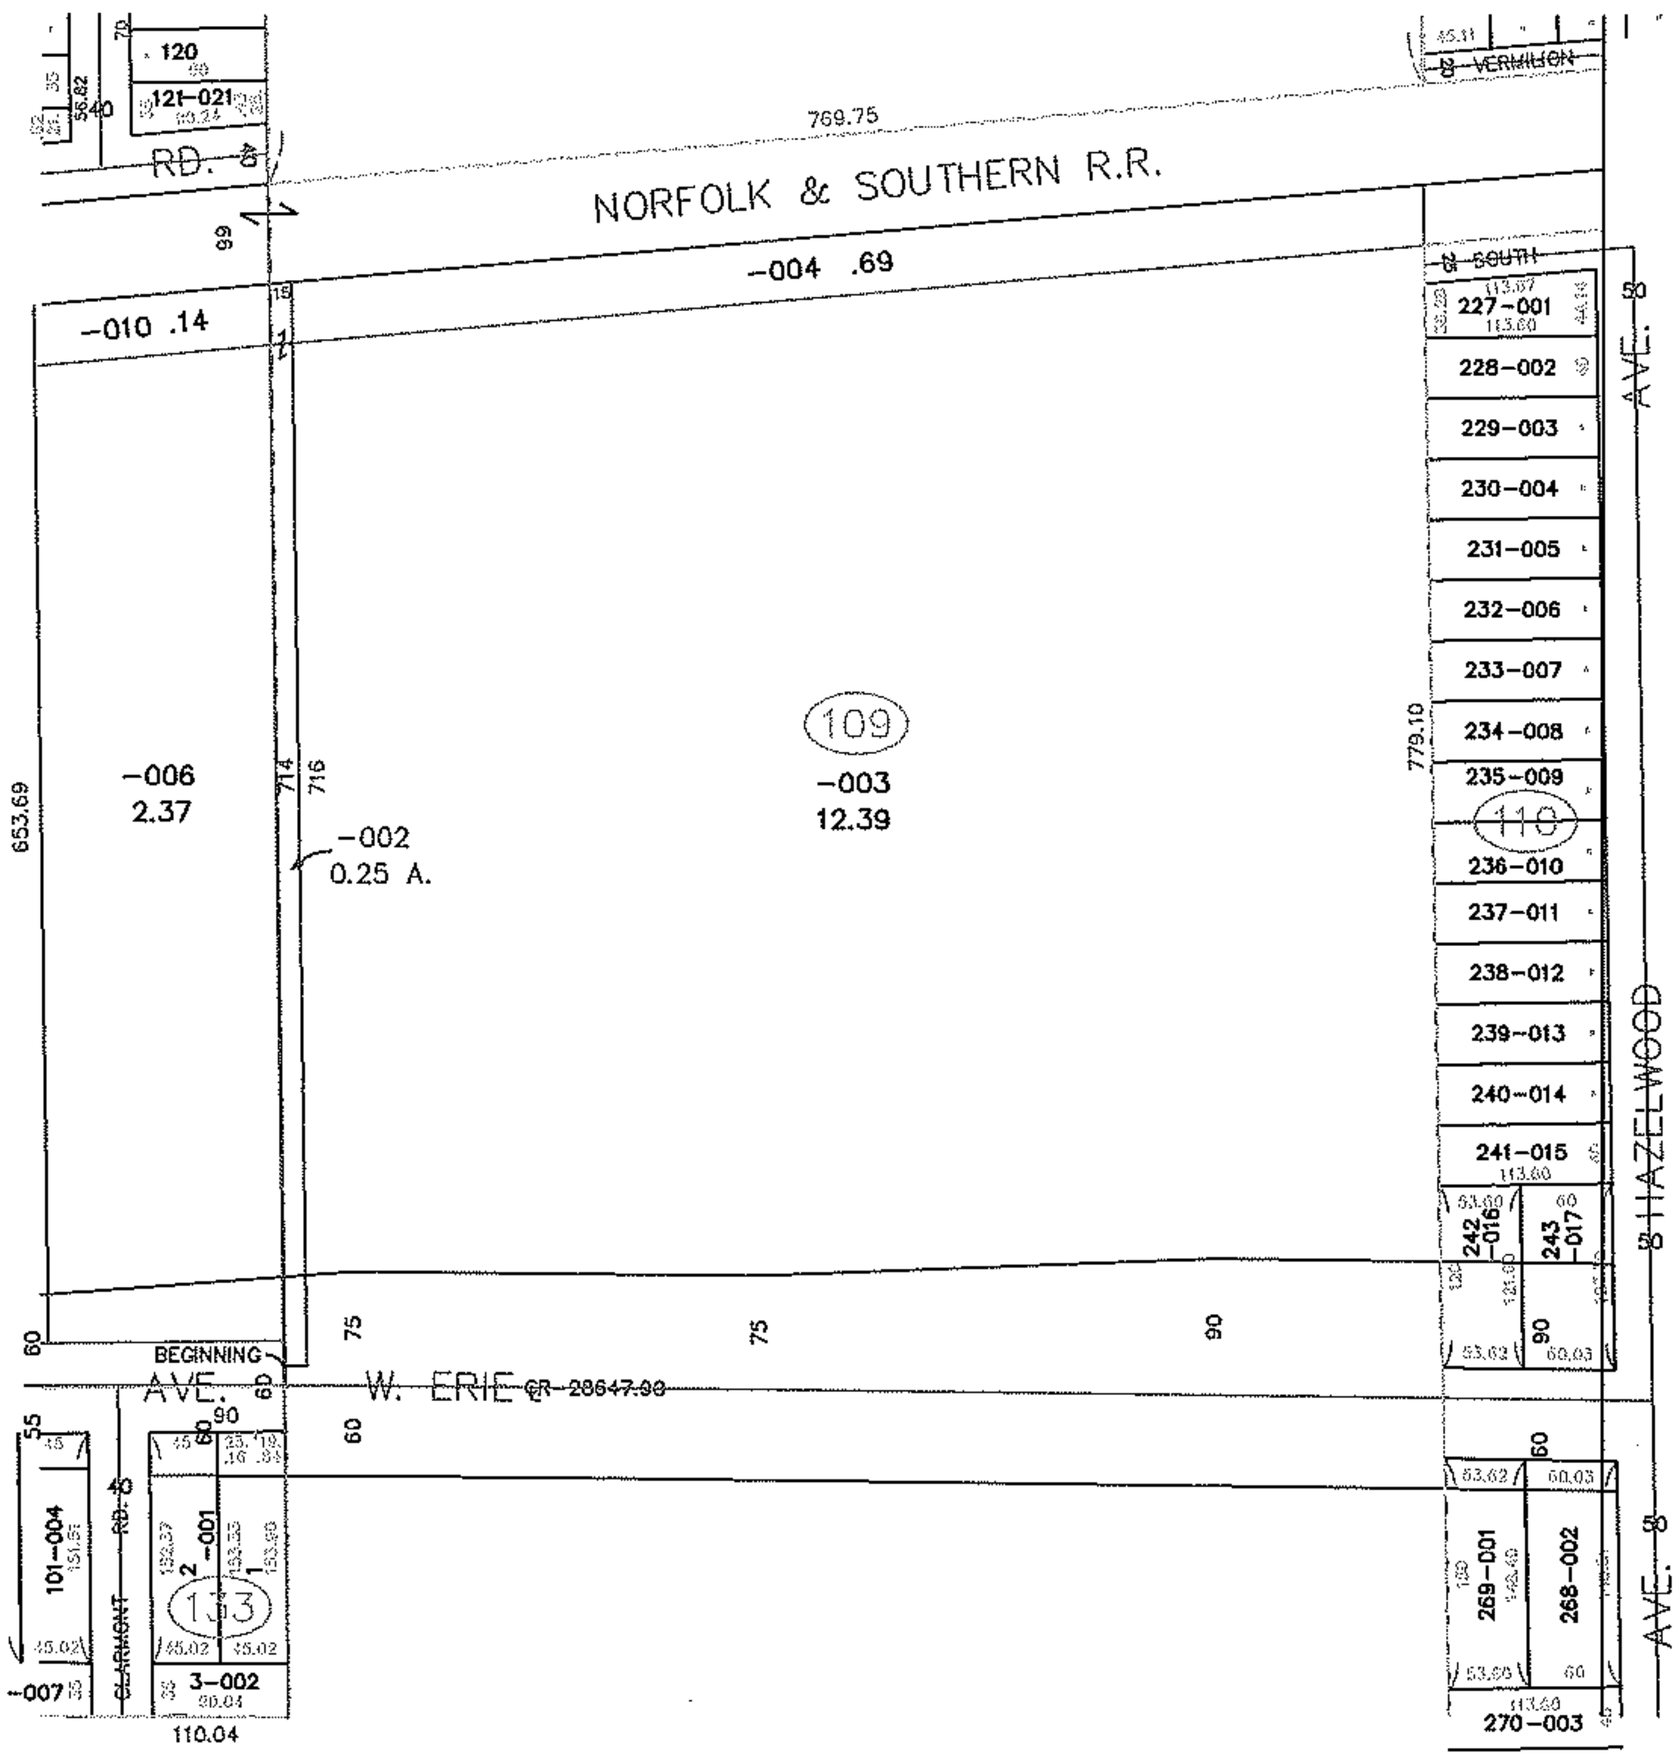


SPLITS/DEEDS PROCESSED

LORAIN COUNTY TAX MAP DEPARTMENT

226 MIDDLE AVE. ELYRIA, OHIO

SURVEYED BY: NONE

CLOSURE: NA

MAP PAGE(S): 1-00-004-A

APPROVED BY: TJS DATE: 5/13/13

SCALE: 1"= 200 PRIOR INST.: DV 938/183