PARENT PARCEL: 01-00-004-109-003 & -004

CHILD PARCEL: 01-00-004-109-005

STARTING POINT: INT. OF WEST LINE OF O.L. 4 & OLD CL OF LIBERTY AVE.

13-02735-C

N
W E
S

NAME CORRECTION

01-00-004-109-004
0.69 A.
FROM: ROBERT F. KAYLE
TO: GERMAN'S VILLA ON THE LAKE INC.
PER D.V. 1337/12 & O.R. 388/379

COMBINATION

~~01-00-004-109-003~~
~~12.39 A.~~
&
~~01-00-004-109-004~~
~~0.69 A.~~

01-00-004-109-005
13.08 A.
PER O.R. 388/379

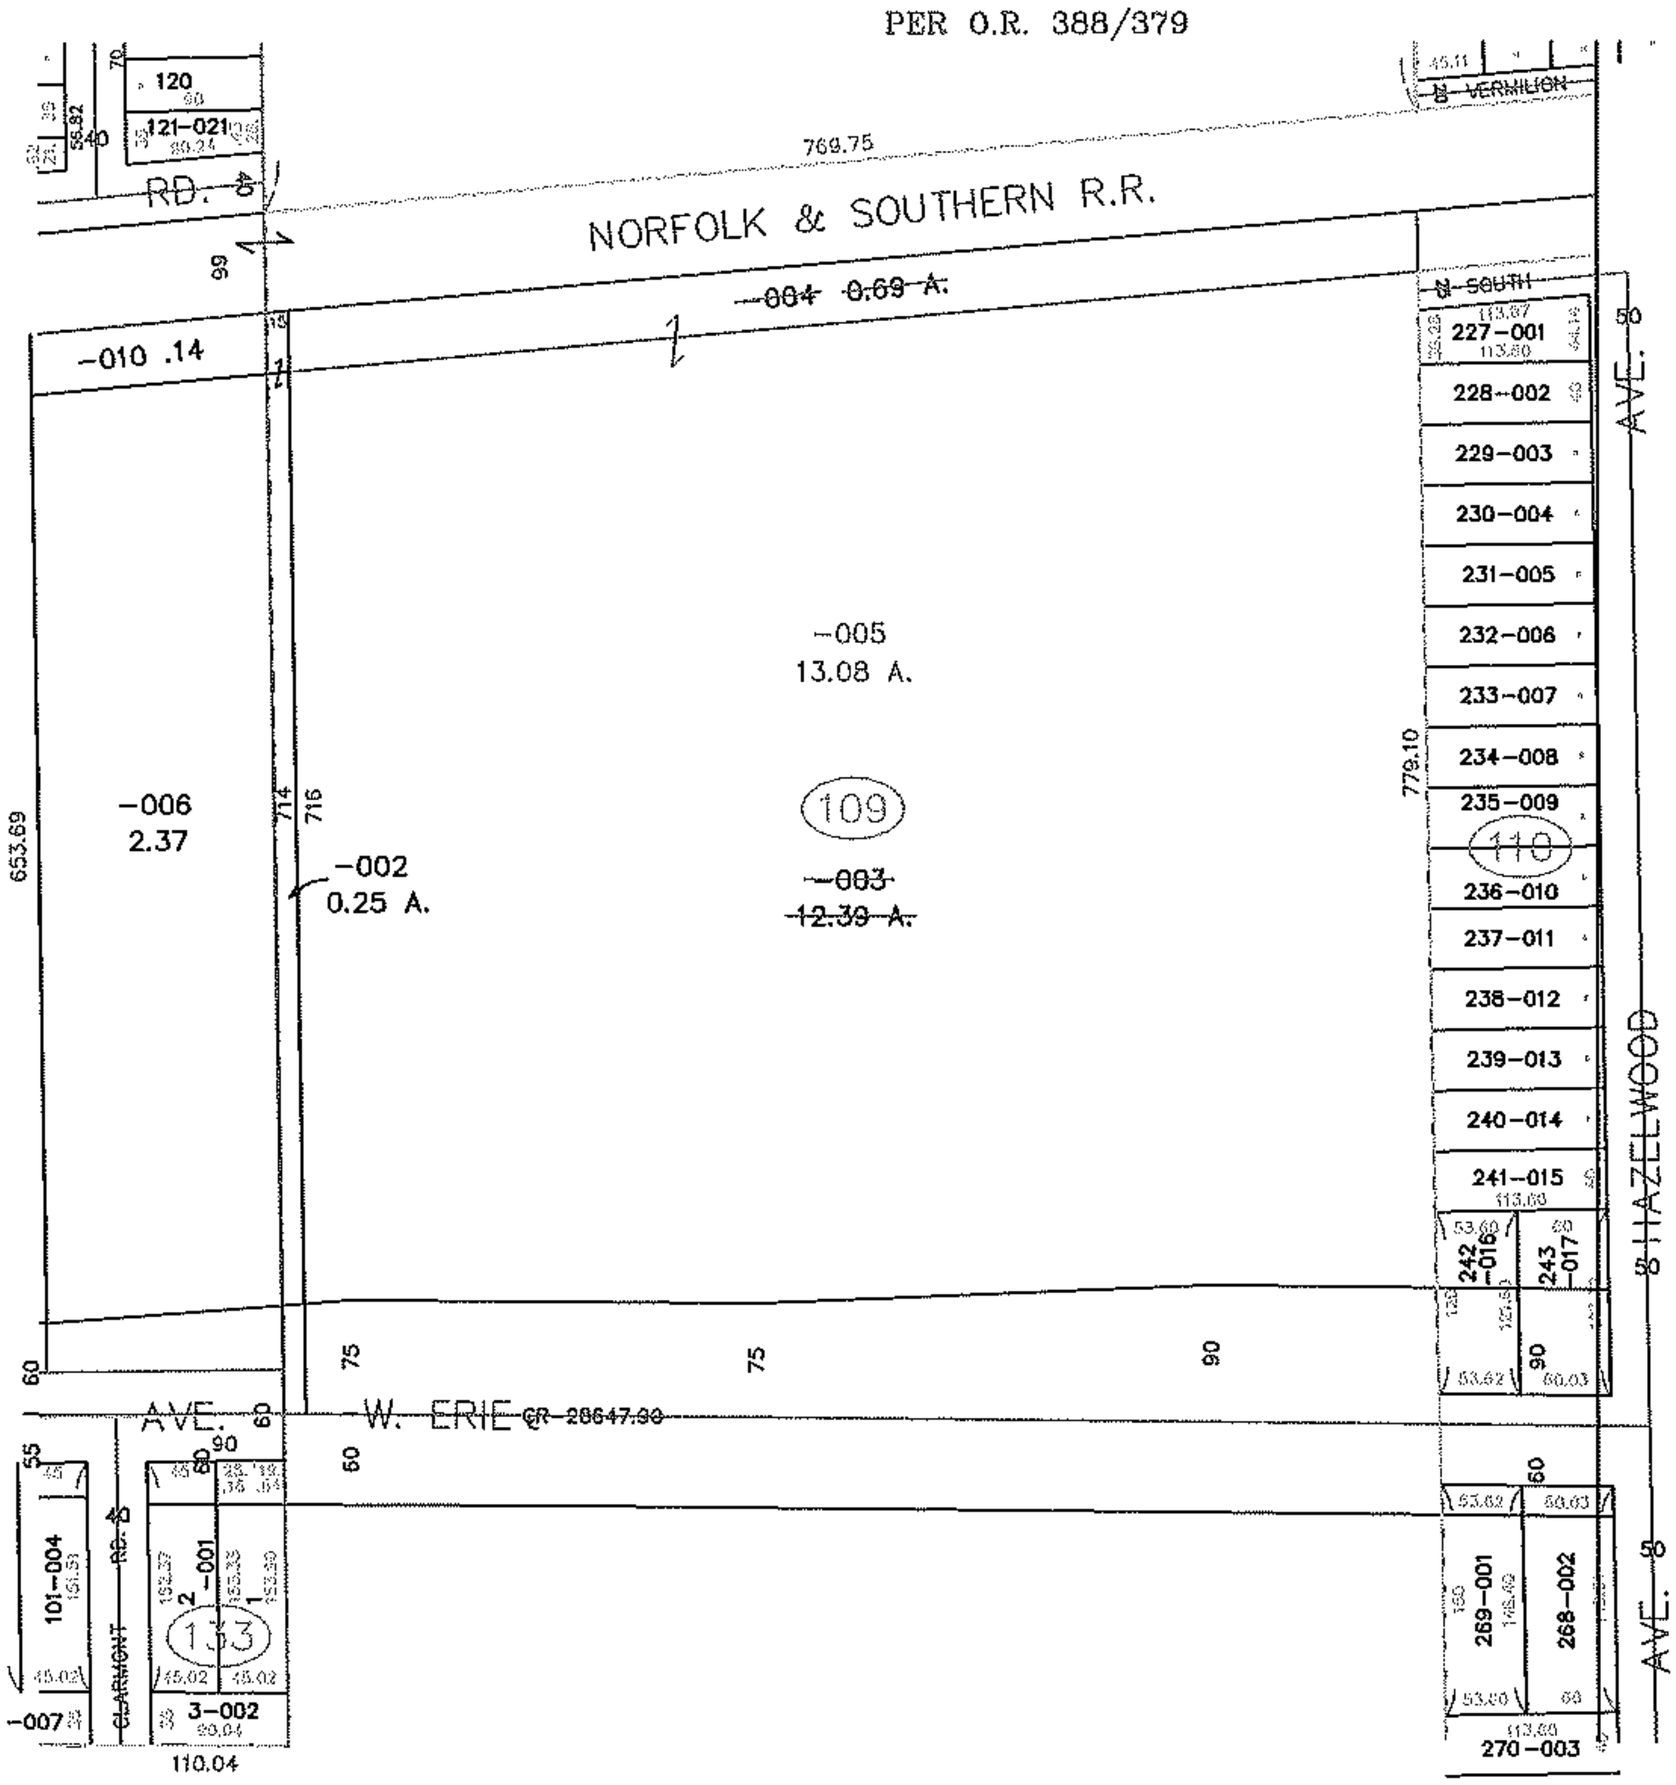

SPLITS/DEEDS PROCESSED

LORAIN COUNTY TAX MAP DEPARTMENT
226 MIDDLE AVE. ELYRIA, OHIO

SURVEYED BY: NONE

CLOSURE: NA

MAP PAGE(S): 1-00-004-A

APPROVED BY: TJS DATE: 5/28/13

SCALE: 1"= 200 PRIOR INST.: OR 388/379