RASTER

RASTER

PARENT PARCEL: 01-20-026-000-015, 01-00-064-000-34 036 076 *SEE BELOW

CHILD PARCEL: 01-00-064-000-077 THRU 079 01-00-065-000-029 THRU -031

STARTING POINT: CENTERLINE OF NORTH RIDGE RD & TRINTER RD

09-02742

* 01-00-065-000-002, 009, 026, 003

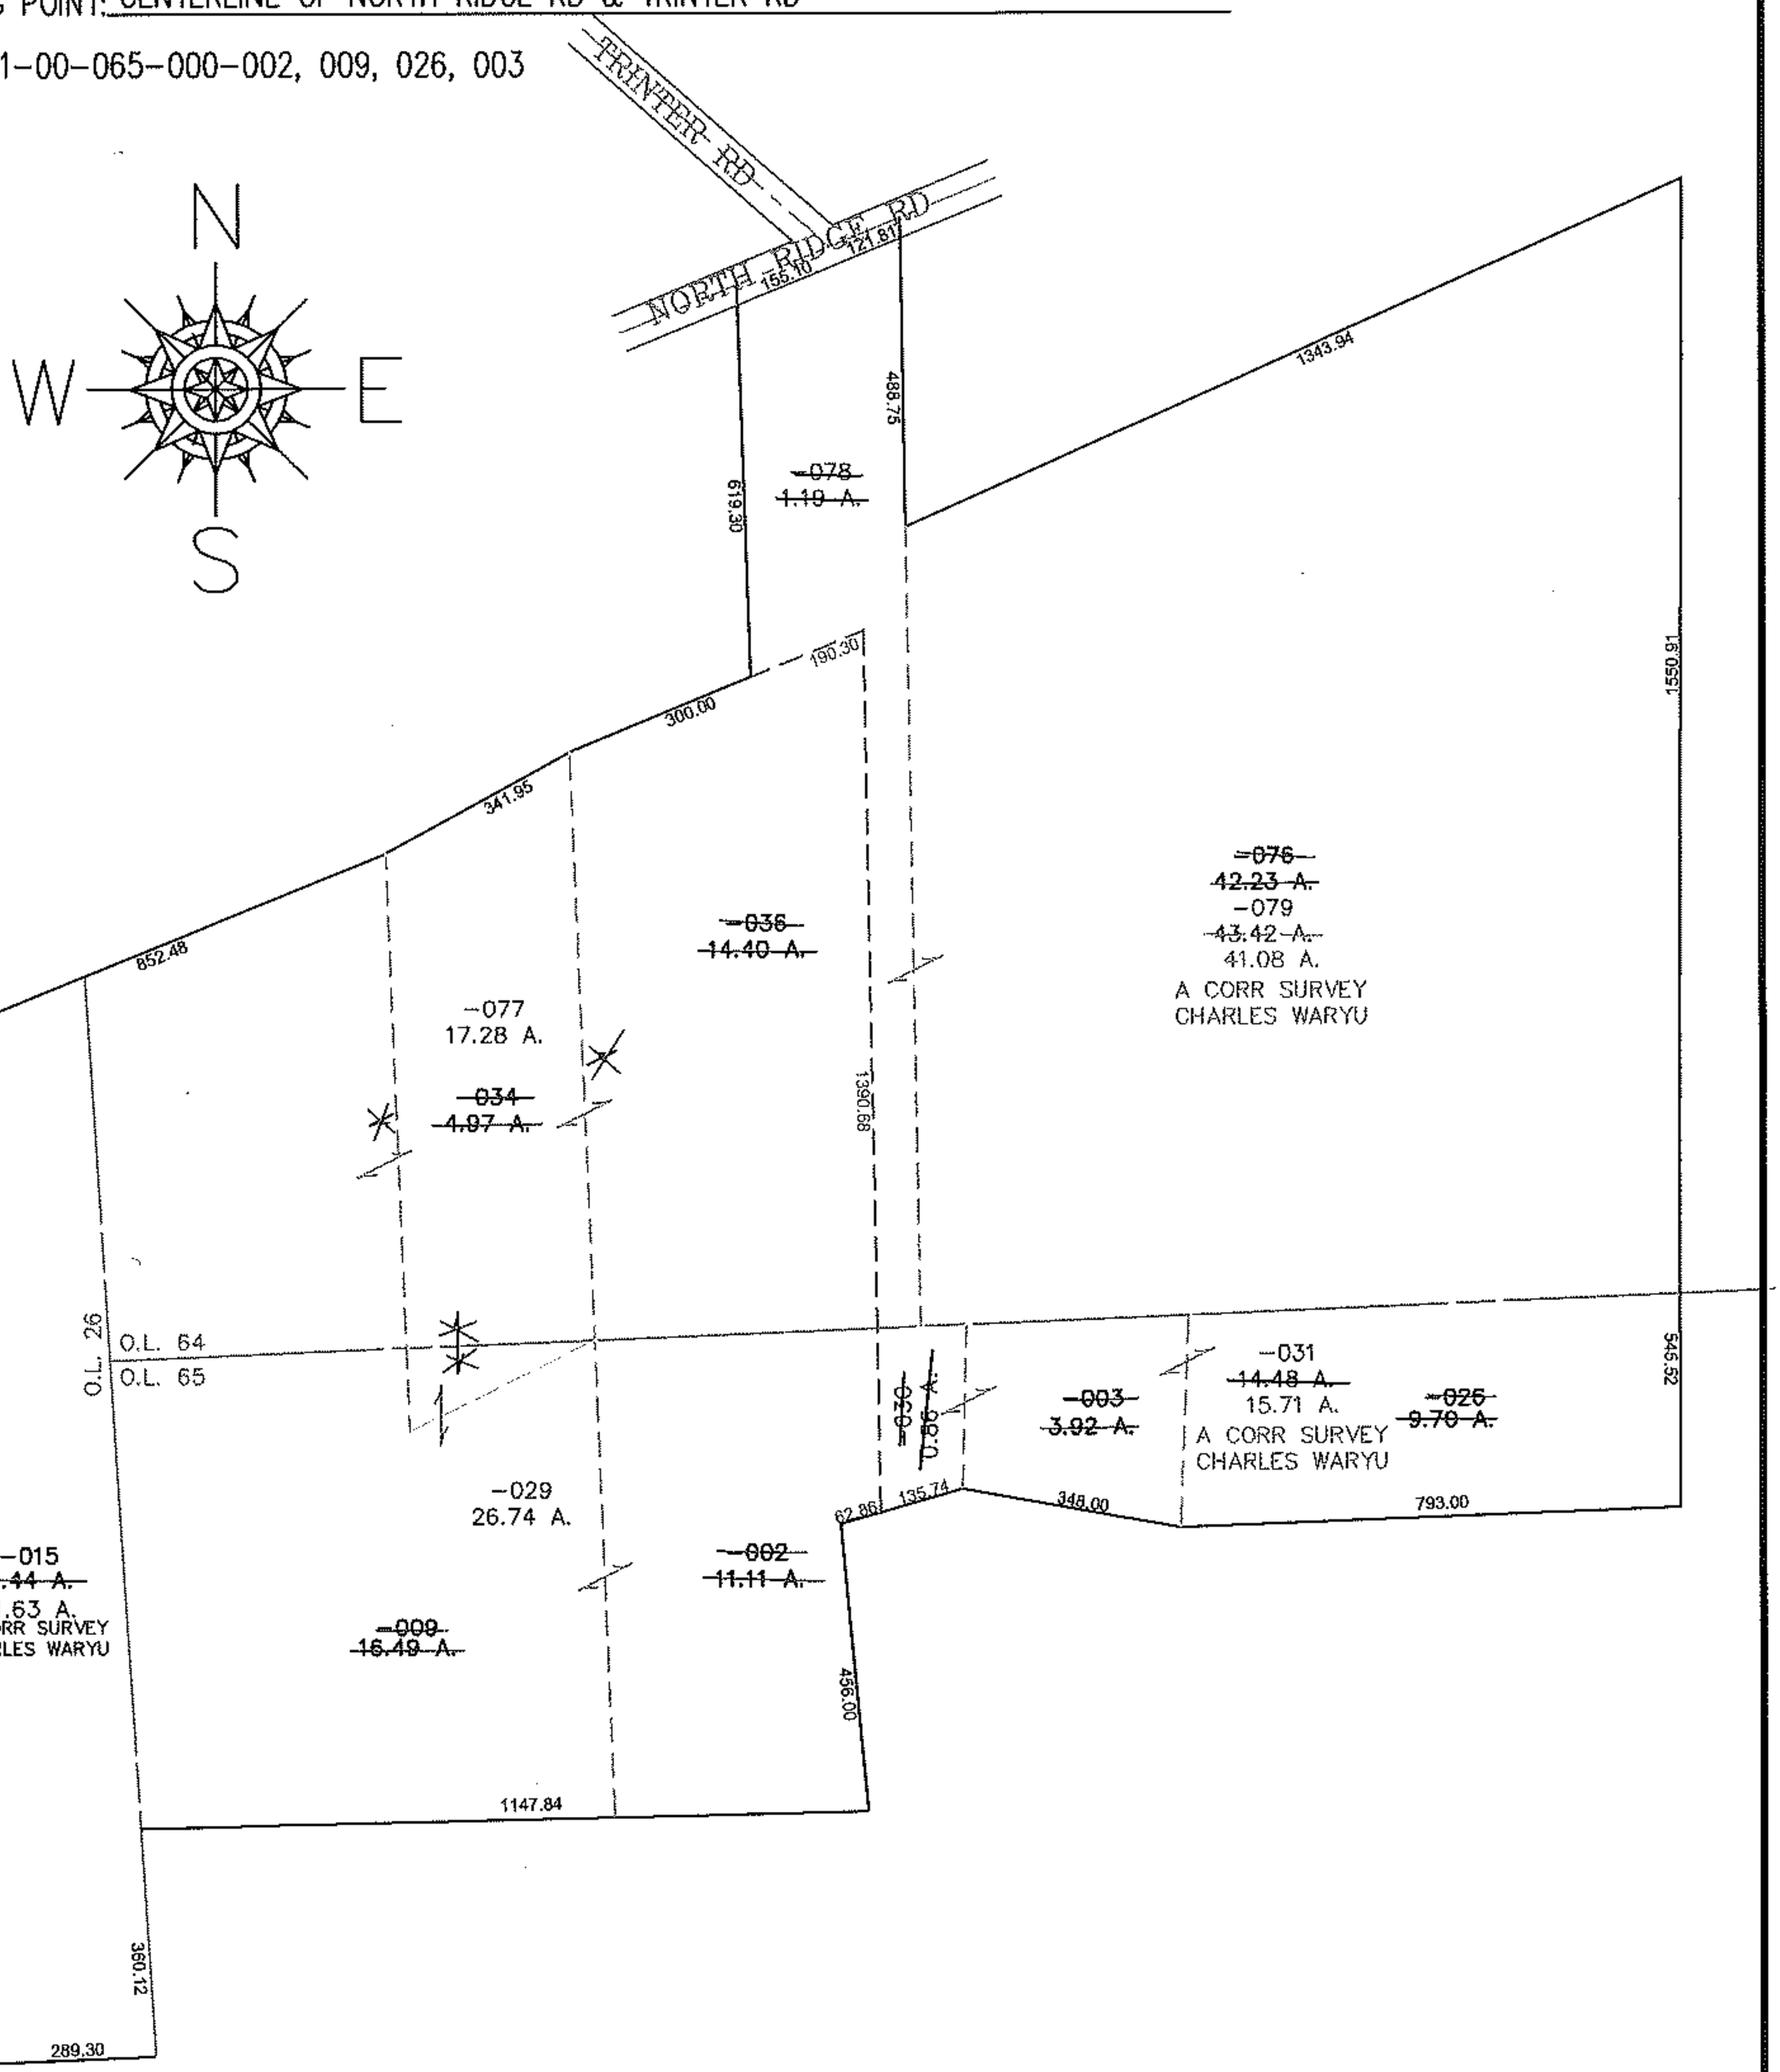

SPLITS/DEEDS PROCESSED

LORAIN COUNTY TAX MAP DEPARTMENT
226 MIDDLE AVE. ELYRIA, OHIO

SURVEYED BY: CHARLES WARYU

CLOSURE: 0.10 : 10,000

MAP PAGE(S): 1-1

APPROVED BY: JAH DATE: 9-24-09

SCALE: 1"= 400 PRIOR INSTRUMENT: 20050108716