PARENT PARCEL: 06-24-022-000-026, 06-24-023-101-012

CHILD PARCEL: 06-24-022-000-033, -034, 06-24-023-101-013, -014

STARTING POINT: CENTERLINE OF MURRAY RIDGE RD & ST RT 113

09-02786

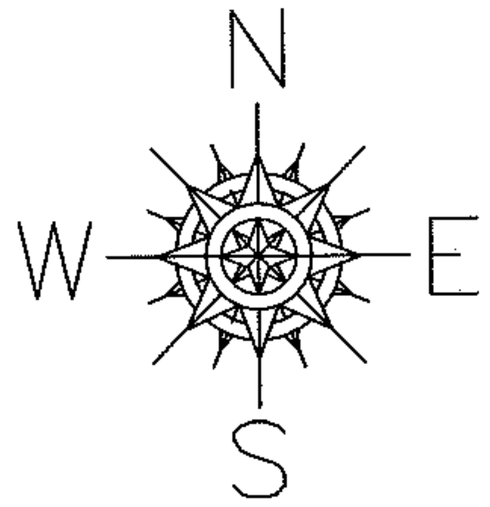

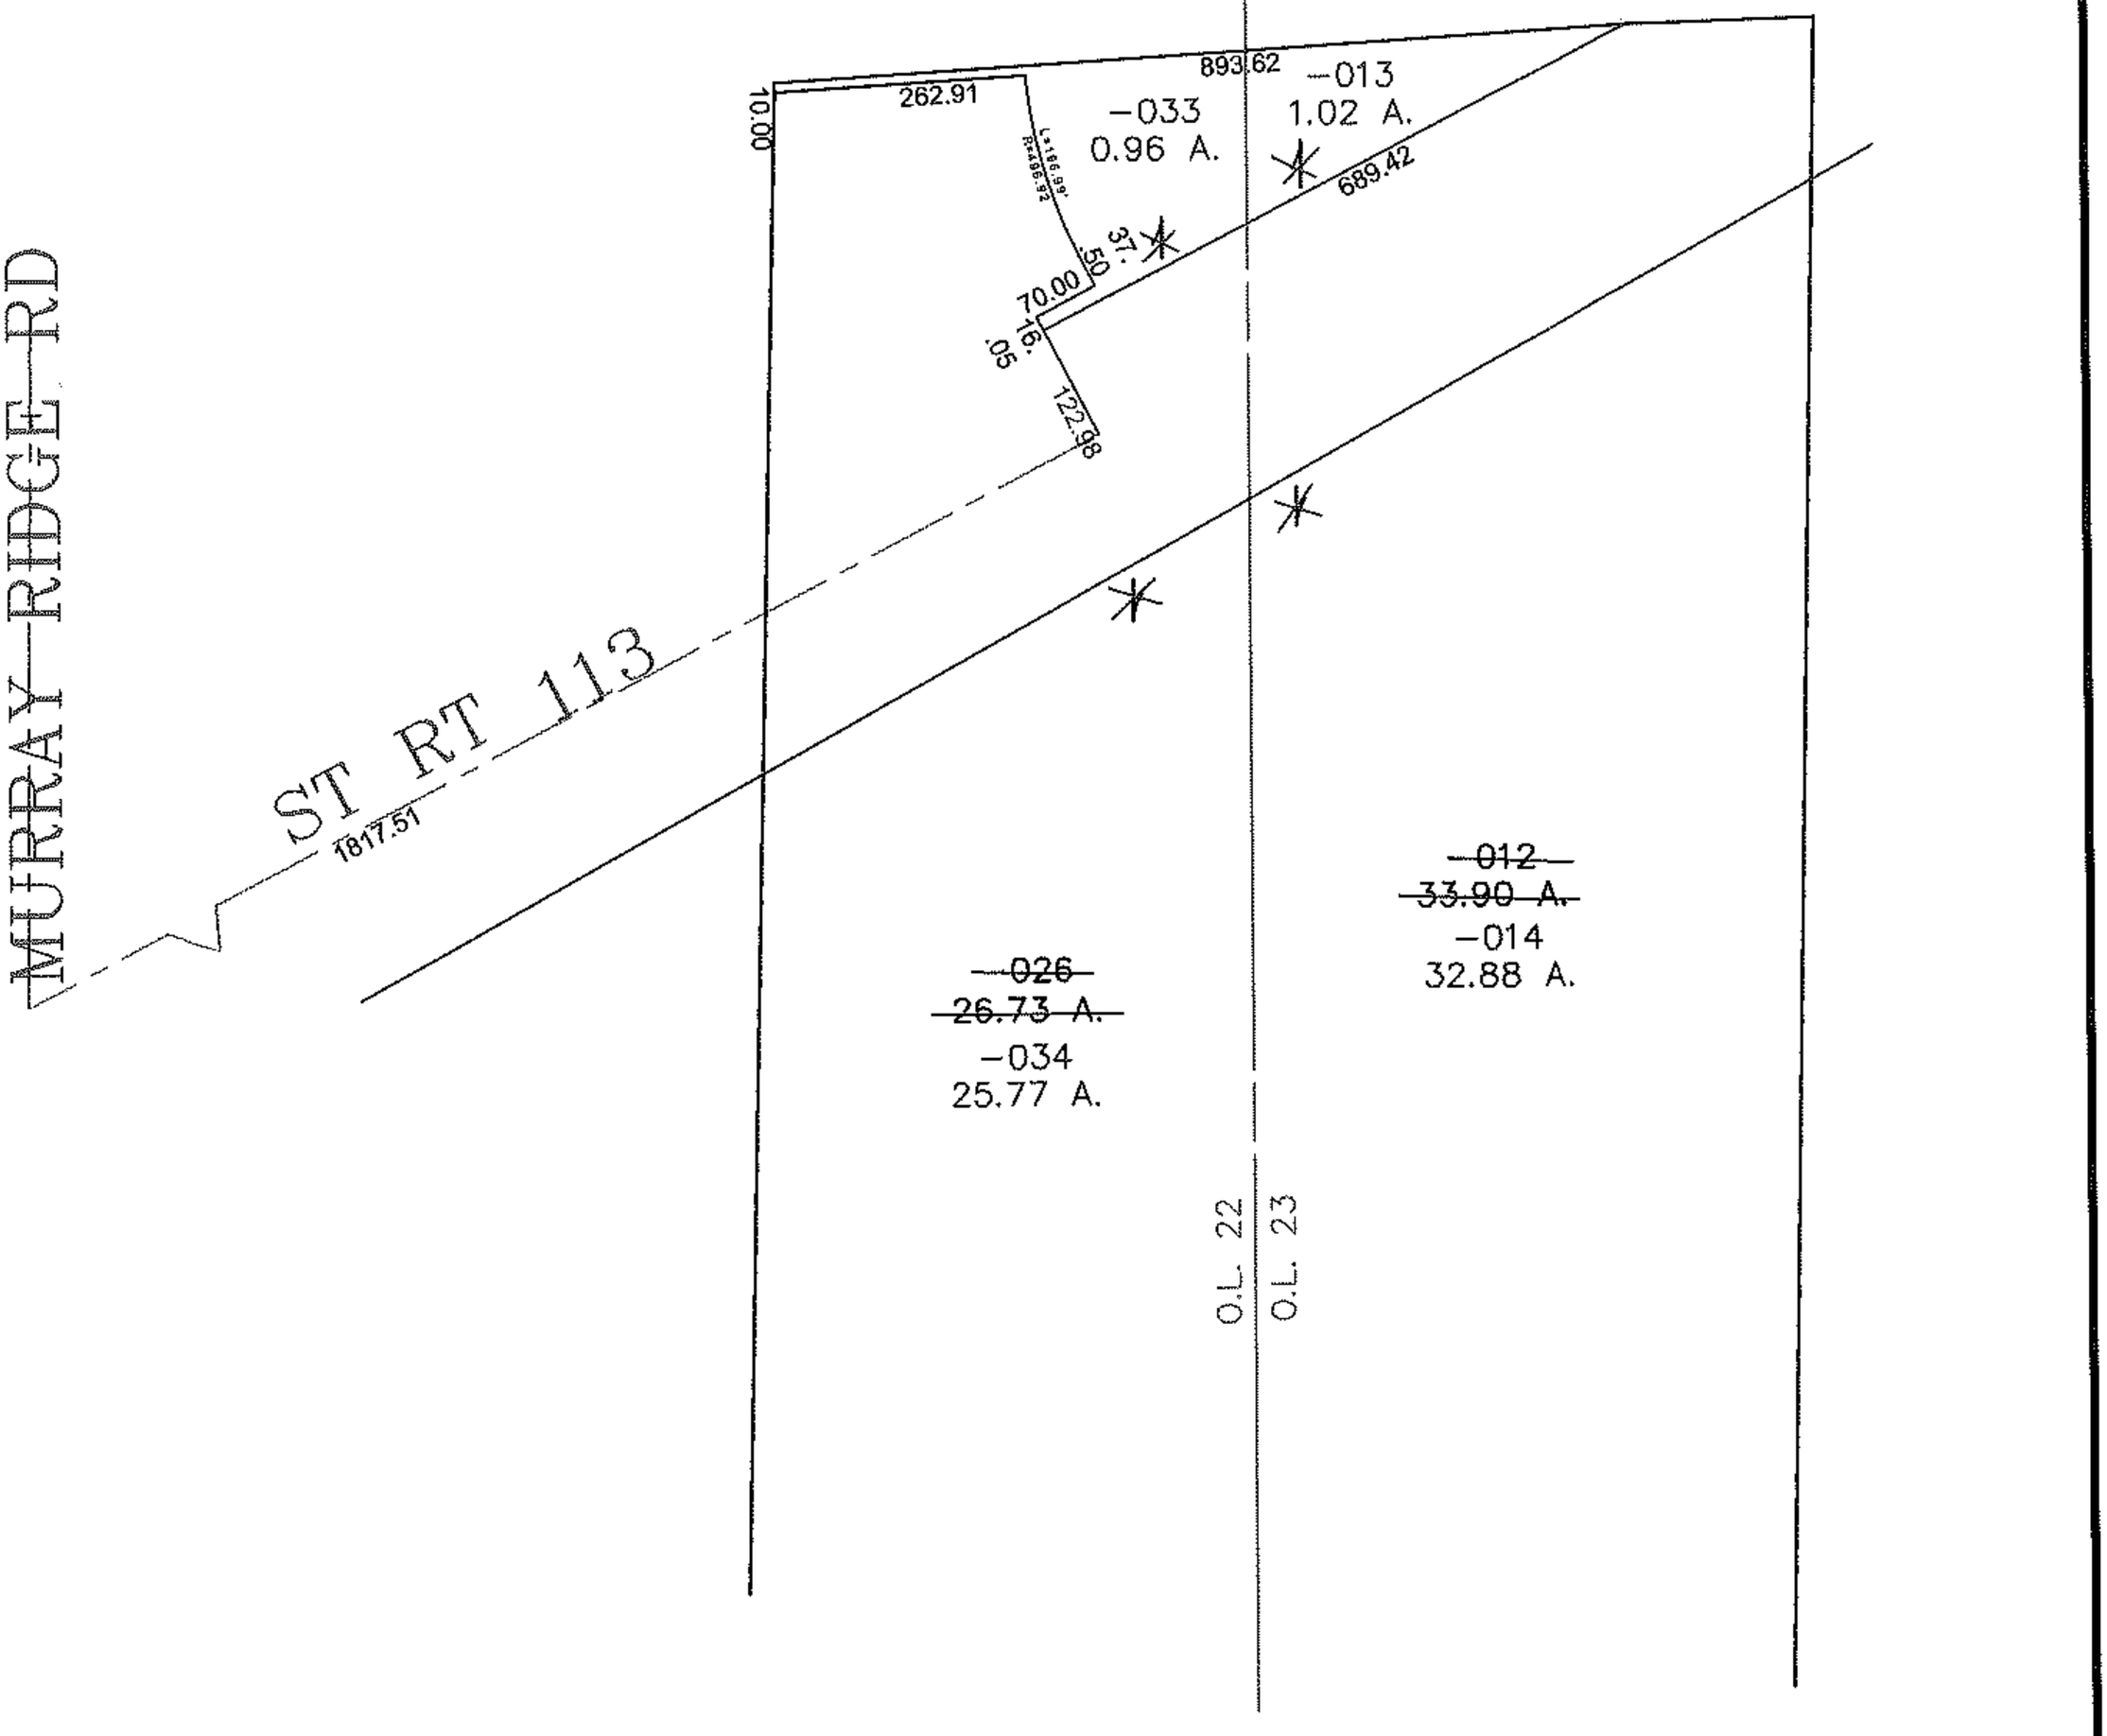

SPLITS/DEEDS PROCESSED

LORAIN COUNTY TAX MAP DEPARTMENT
226 MIDDLE AVE. ELYRIA, OHIO

SURVEYED BY: THOMAS SIMON

CLOSURE: 0.00 : 10,000

MAP PAGE(S): 6-76, 6-77

APPROVED BY: JAH DATE: 12-17-09

SCALE: 1"= 300 PRIOR INSTRUMENT: DV 1316/118