See Survey Image 40556

PARENT PARCEL: 12-00-033-000-001 & -060, 12-00-048-000-028

CHILD PARCEL: 12-00-033-000-065, 12-00-048-000-040 & -041

STARTING POINT: CENTERLINE OF COLUMBIA-MALLET RD. & O.L. 33

NO. 09-02791

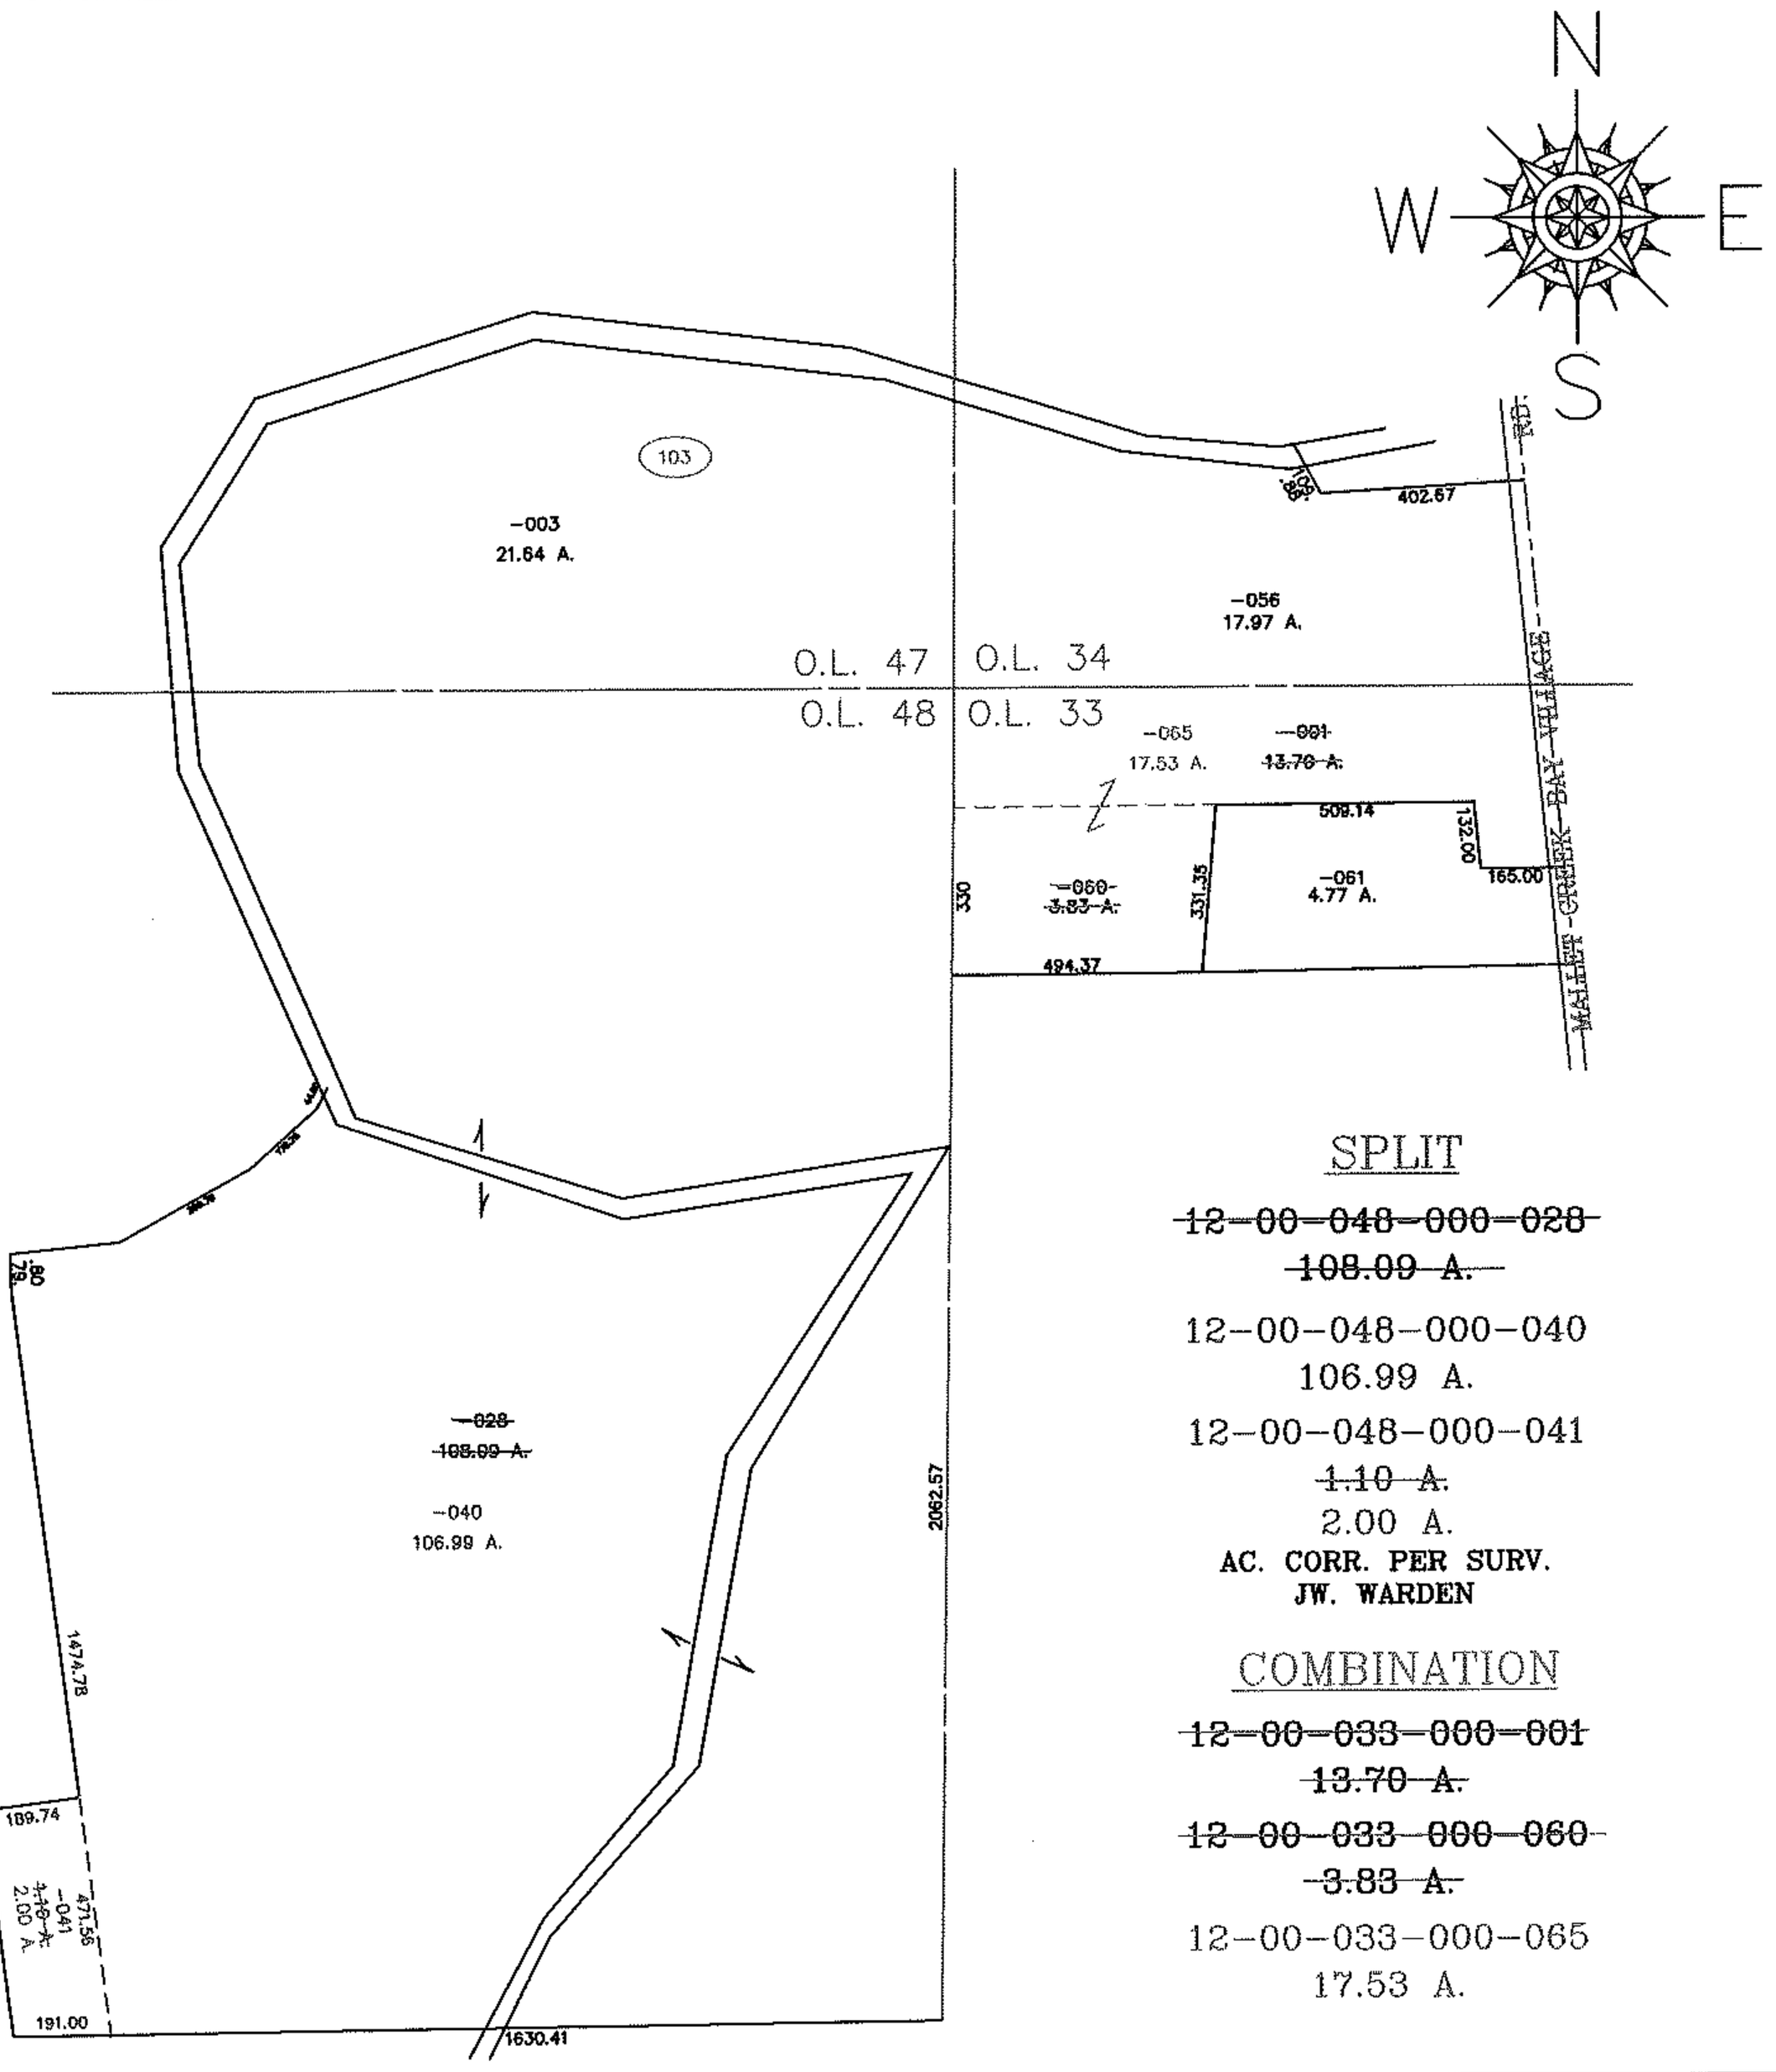


## SPLIT

~~12-00-048-000-028~~
~~108.09 A.~~

12-00-048-000-040
106.99 A.

12-00-048-000-041
~~1.10 A.~~
2.00 A.

**AC. CORR. PER SURV.**
**JW. WARDEN**

## COMBINATION

~~12-00-033-000-001~~
~~13.70 A.~~

~~12-00-033-000-060~~
~~3.83 A.~~

12-00-033-000-065
17.53 A.

## SPLITS/DEEDS PROCESSED

LORAIN COUNTY TAX MAP DEPARTMENT
226 MIDDLE AVE. ELYRIA, OHIO

SURVEYED BY: J.W. WARDEN
CLOSURE: NO CLOSURE
MAP PAGE(S): 12-G
APPROVED BY: TJS DATE: 12/28/09
SCALE: 1"= 500 PRIOR INSTRUMENT: 20017464271703