PARENT PARCEL: 12-00-024-000-023

CHILD PARCEL: 12-00-024-000-040, 12-00-025-000-068, 12-00-037-000-068

STARTING POINT: SOUTHWEST CORNER OF EAGLE POINT SUB.(VOL.90 PG.14)

13-02803-D

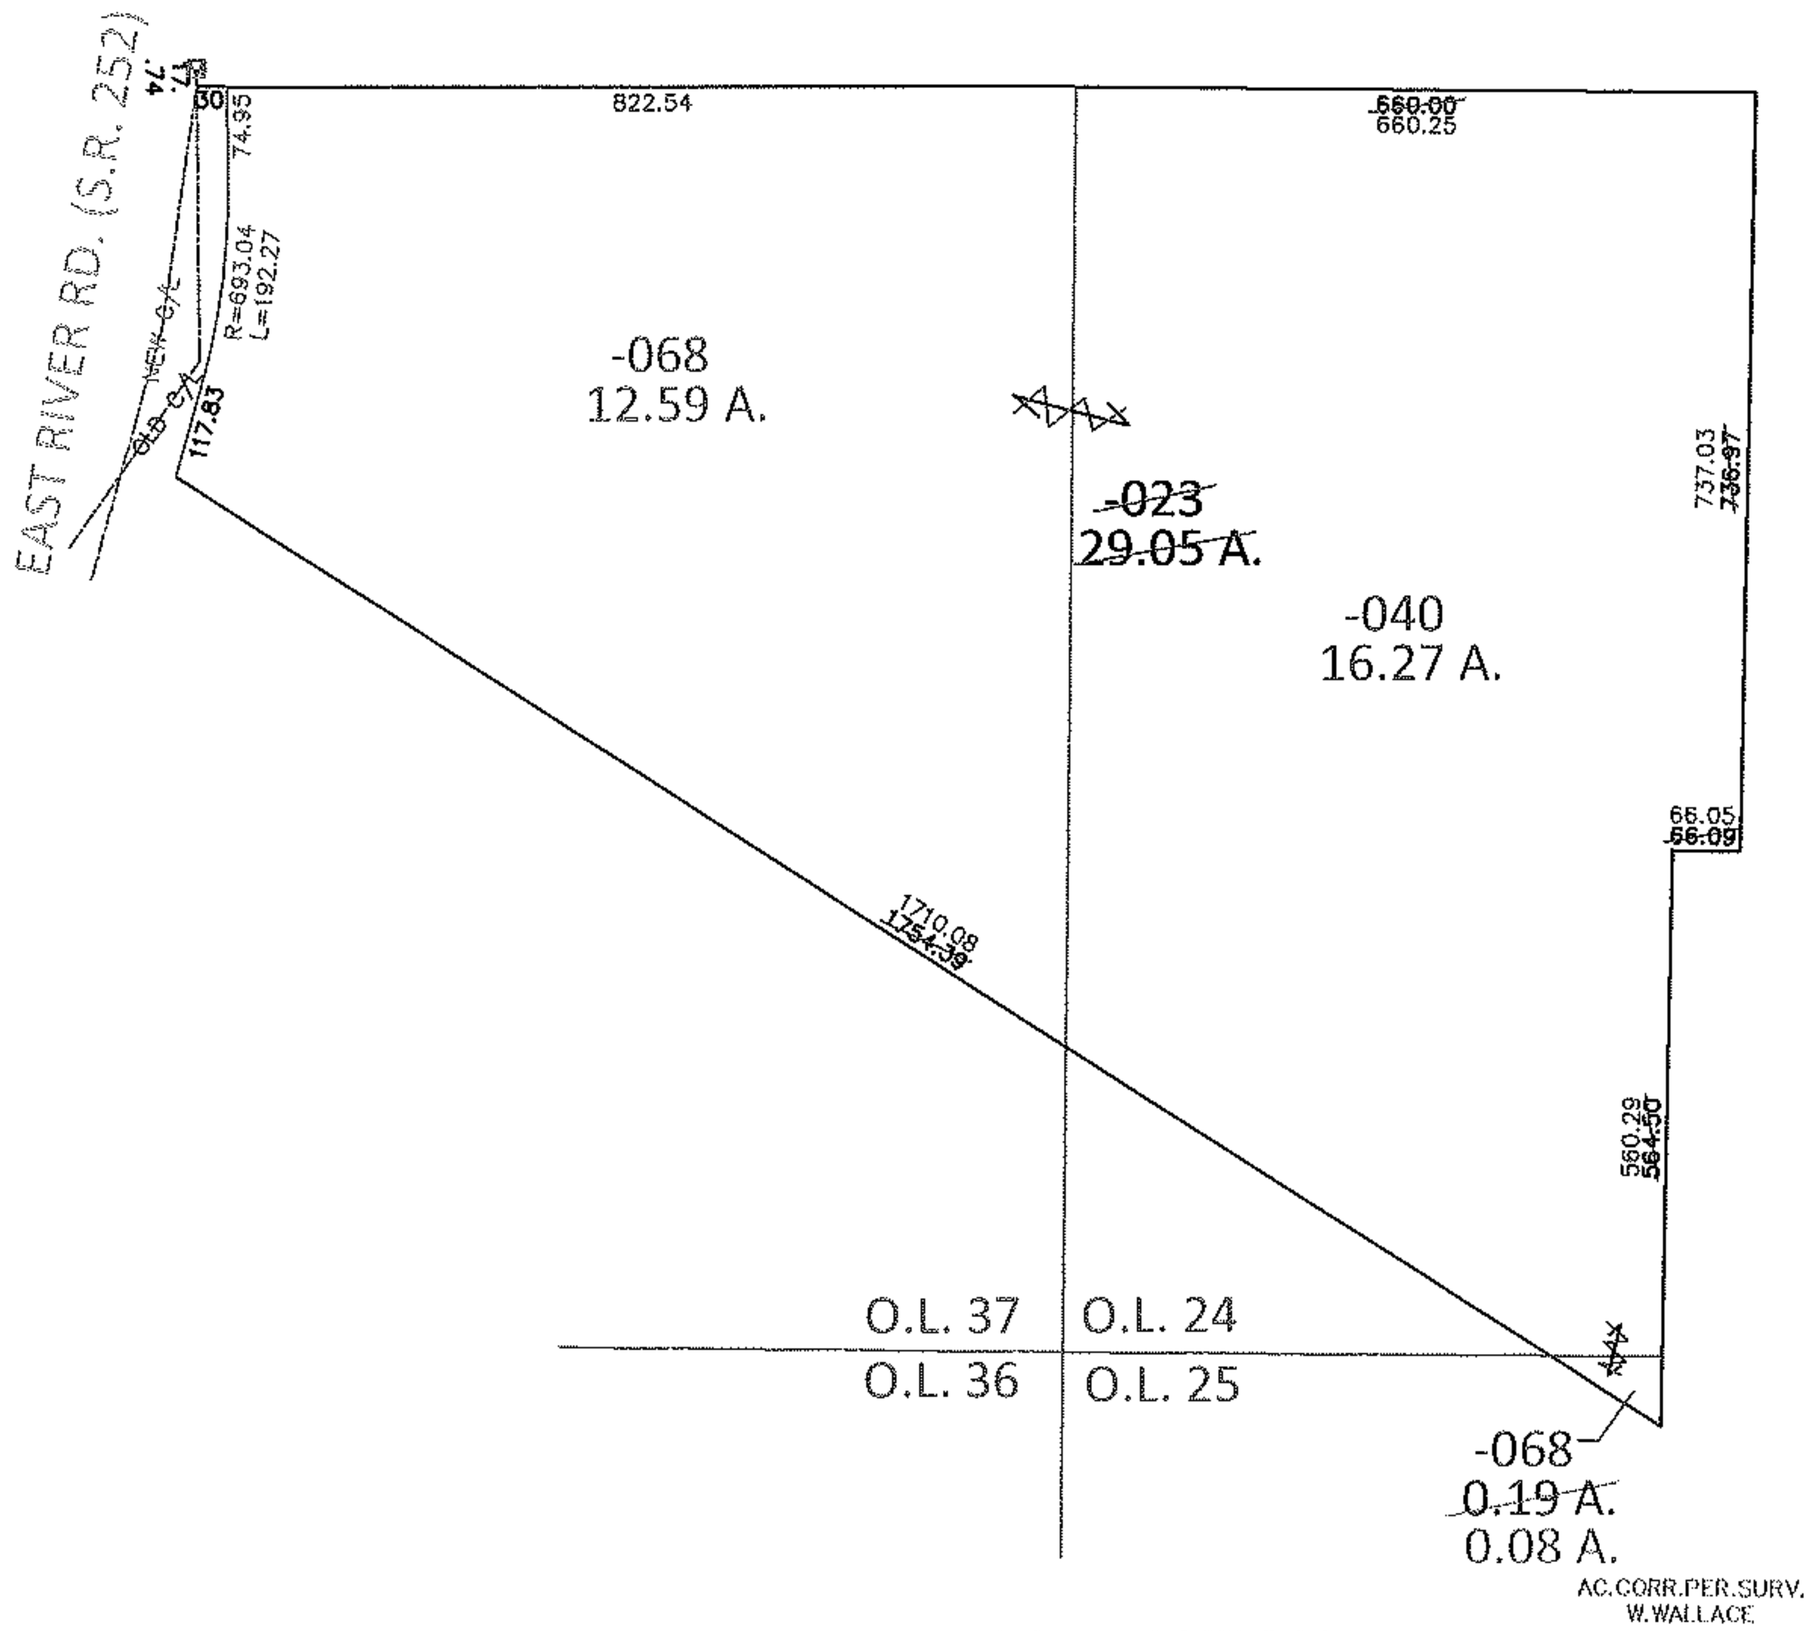

PARCEL NUMBER CORRECTION

TO REFLECT ACREAGE BREAKDOWN BETWEEN ORIGINAL LOTS
PER SURVEY BY WILLIAM R. WALLACE

SPLITS/DEEDS PROCESSED

LORAIN COUNTY TAX MAP DEPARTMENT
226 MIDDLE AVE. ELYRIA, OHIO

SURVEYED BY: WILLIAM R. WALLACE

CLOSURE: .01:10,000

MAP PAGE(S): 12-00-024-A, 12-00-037-B

APPROVED BY: RRM DATE: 9-18-13

SCALE: 1"= 300 PRIOR INST.: 20100327415