PARENT PARCEL: 10-00-007-900-001

CHILD PARCEL: 10-00-007-900-002, & 10-00-007-106-069 & -070,

STARTING POINT: CL OF INDIAN HOLLOW RD. & CL OF BUTTERNUT RIDGE RD.

10-02812

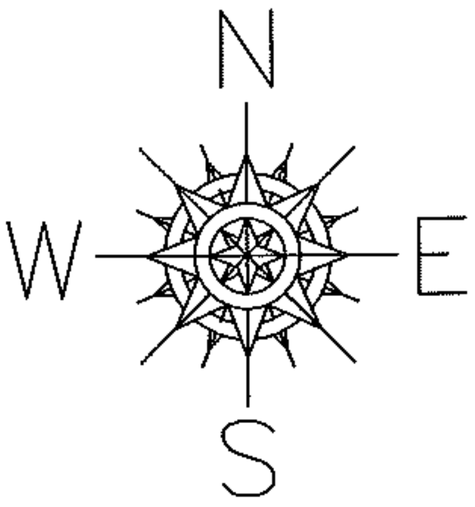

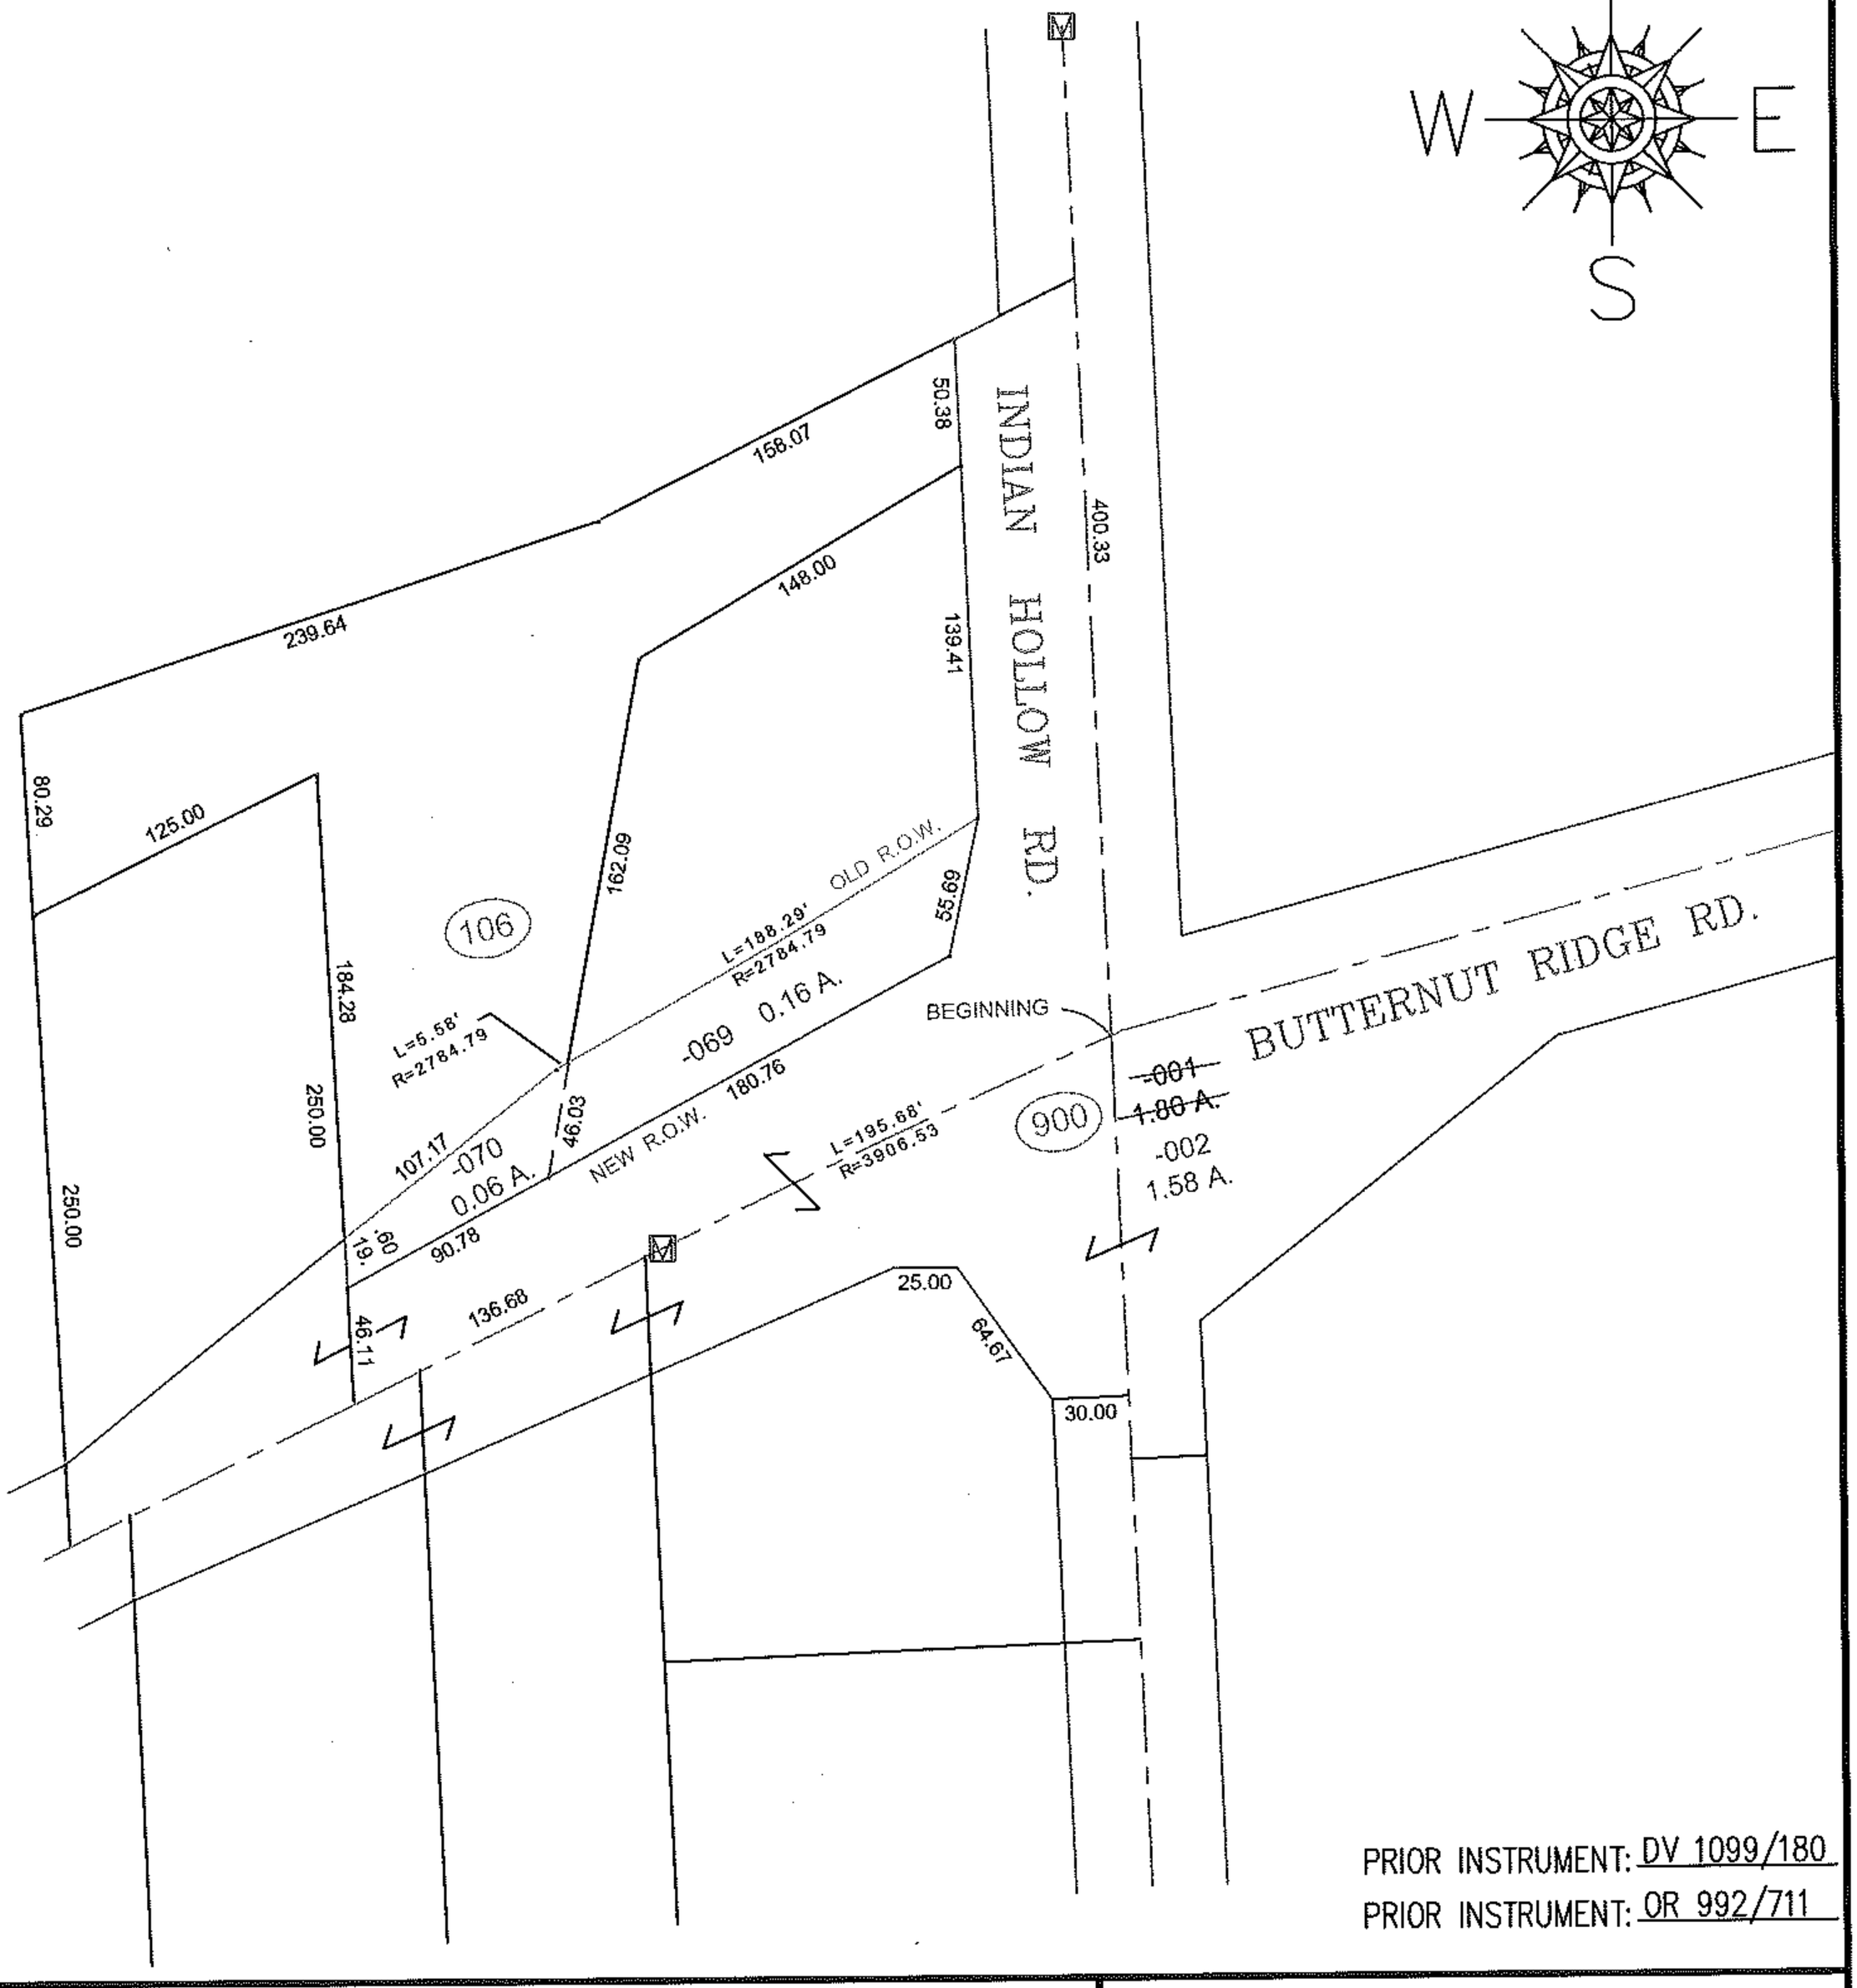

PRIOR INSTRUMENT: DV 1099/180

PRIOR INSTRUMENT: OR 992/711

SPLITS/DEEDS PROCESSED

LORAIN COUNTY TAX MAP DEPARTMENT
226 MIDDLE AVE. ELYRIA, OHIO

SURVEYED BY: RIDHARD D. CARLSON

CLOSURE: 0.08 : 10,000

MAP PAGE(S): 10-00-007-H

APPROVED BY: TJS DATE: 5/7/10

SCALE: 1"= 100