PARENT PARCEL: 14-00-057-000-001, -013

CHILD PARCEL: 14-00-057-000-016 THRU -021

STARTING POINT: CENTERLINE OF HUGHES RD & HALLAUER RD

10-02815

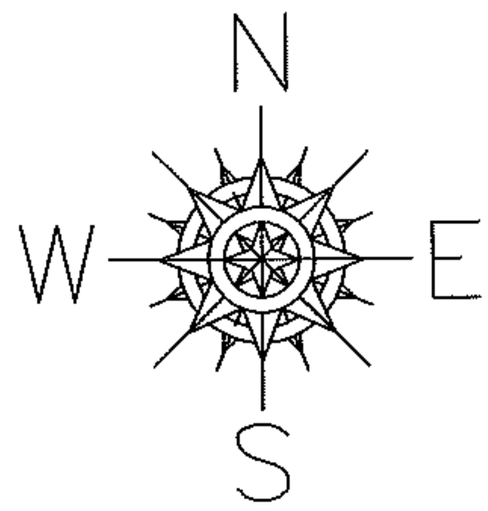

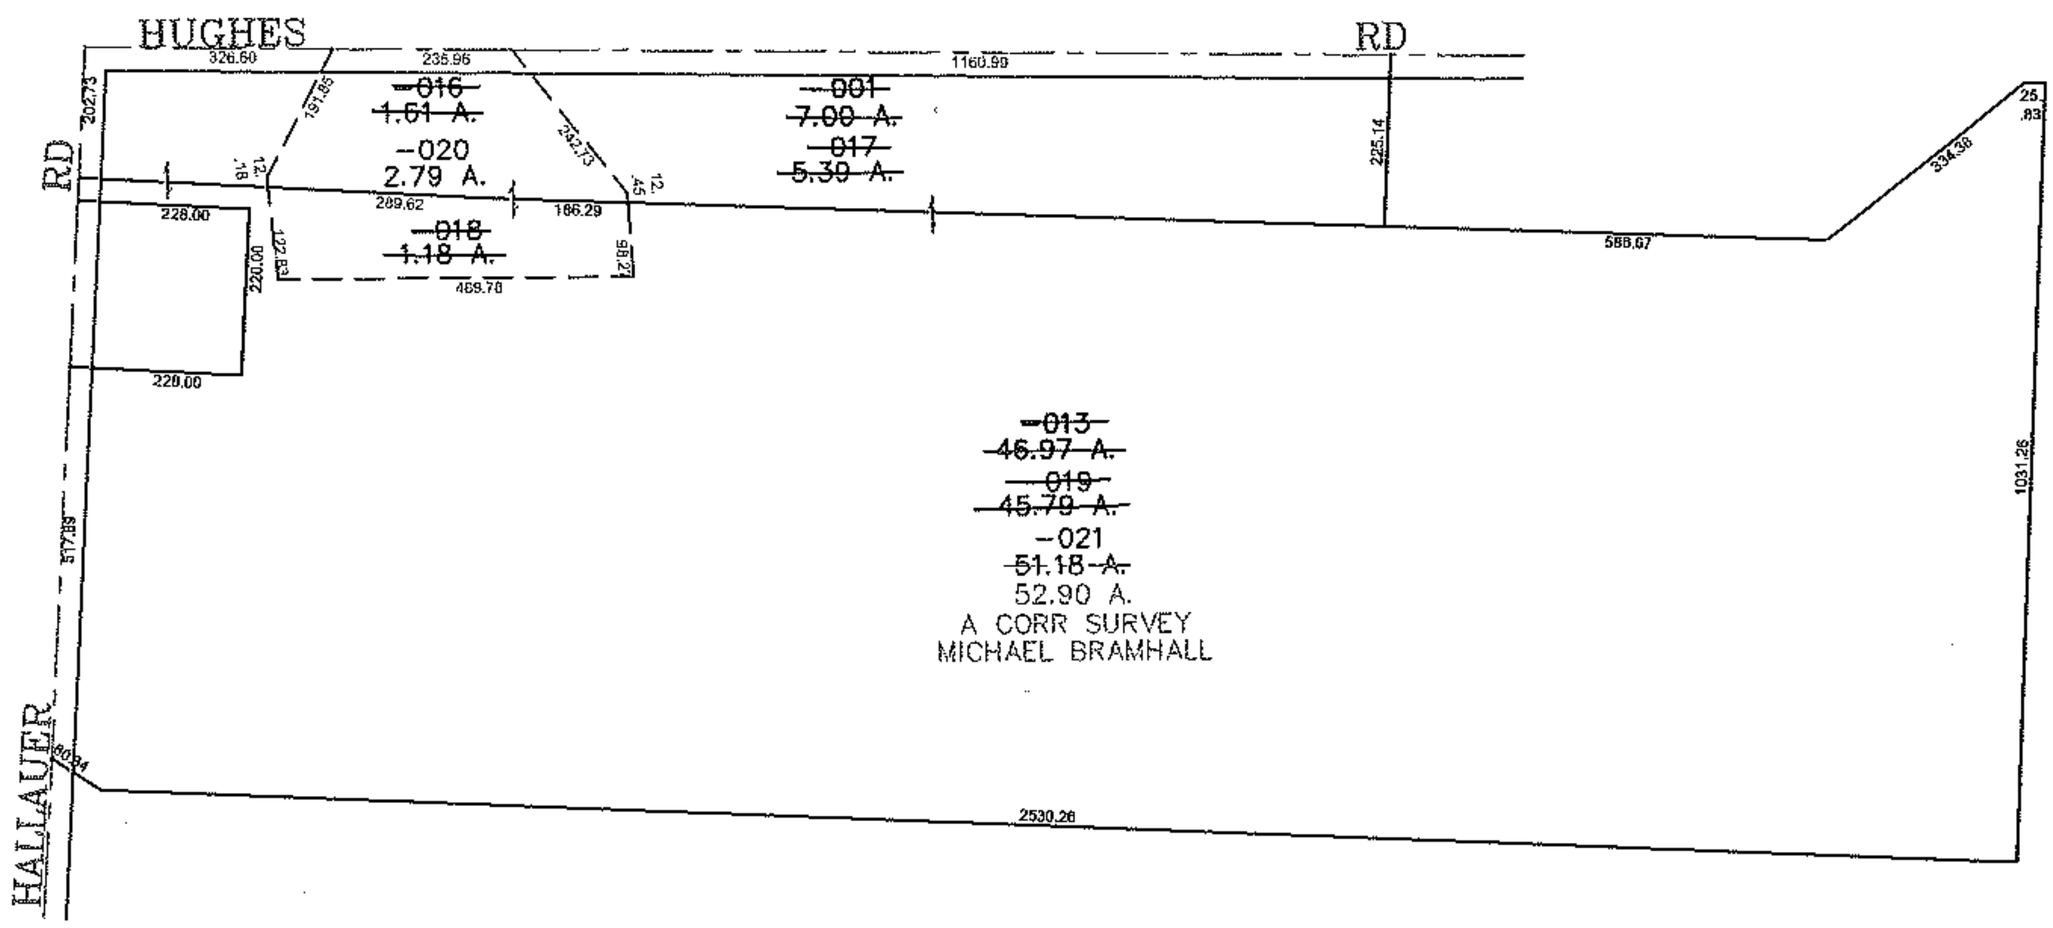

SPLITS/DEEDS PROCESSED

LORAIN COUNTY TAX MAP DEPARTMENT
226 MIDDLE AVE. ELYRIA, OHIO

SURVEYED BY: MICHAEL BRAMHALL

CLOSURE: 0.00 : 10,000

MAP PAGE(S): 14-C

APPROVED BY: JAH DATE: 3-23-10

SCALE: 1"= 400 PRIOR INST.: 2000069074

RASTER