PARENT PARCEL: 09-00-053-000-006, -026

CHILD PARCEL: 09-00-053-000-034

STARTING POINT: AT A R.R. SPIKE AT THE NORTHEAST CORNER OF O.L.53

13-02834-C

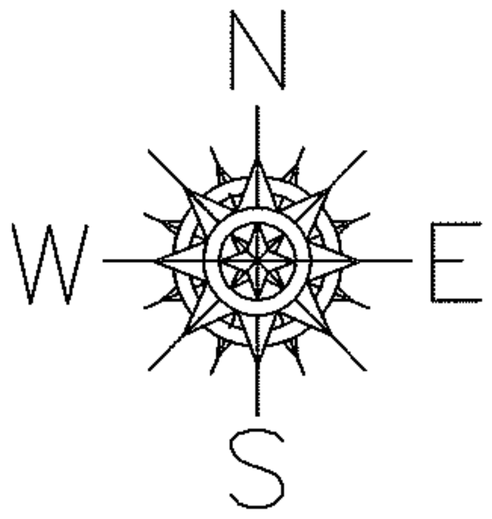

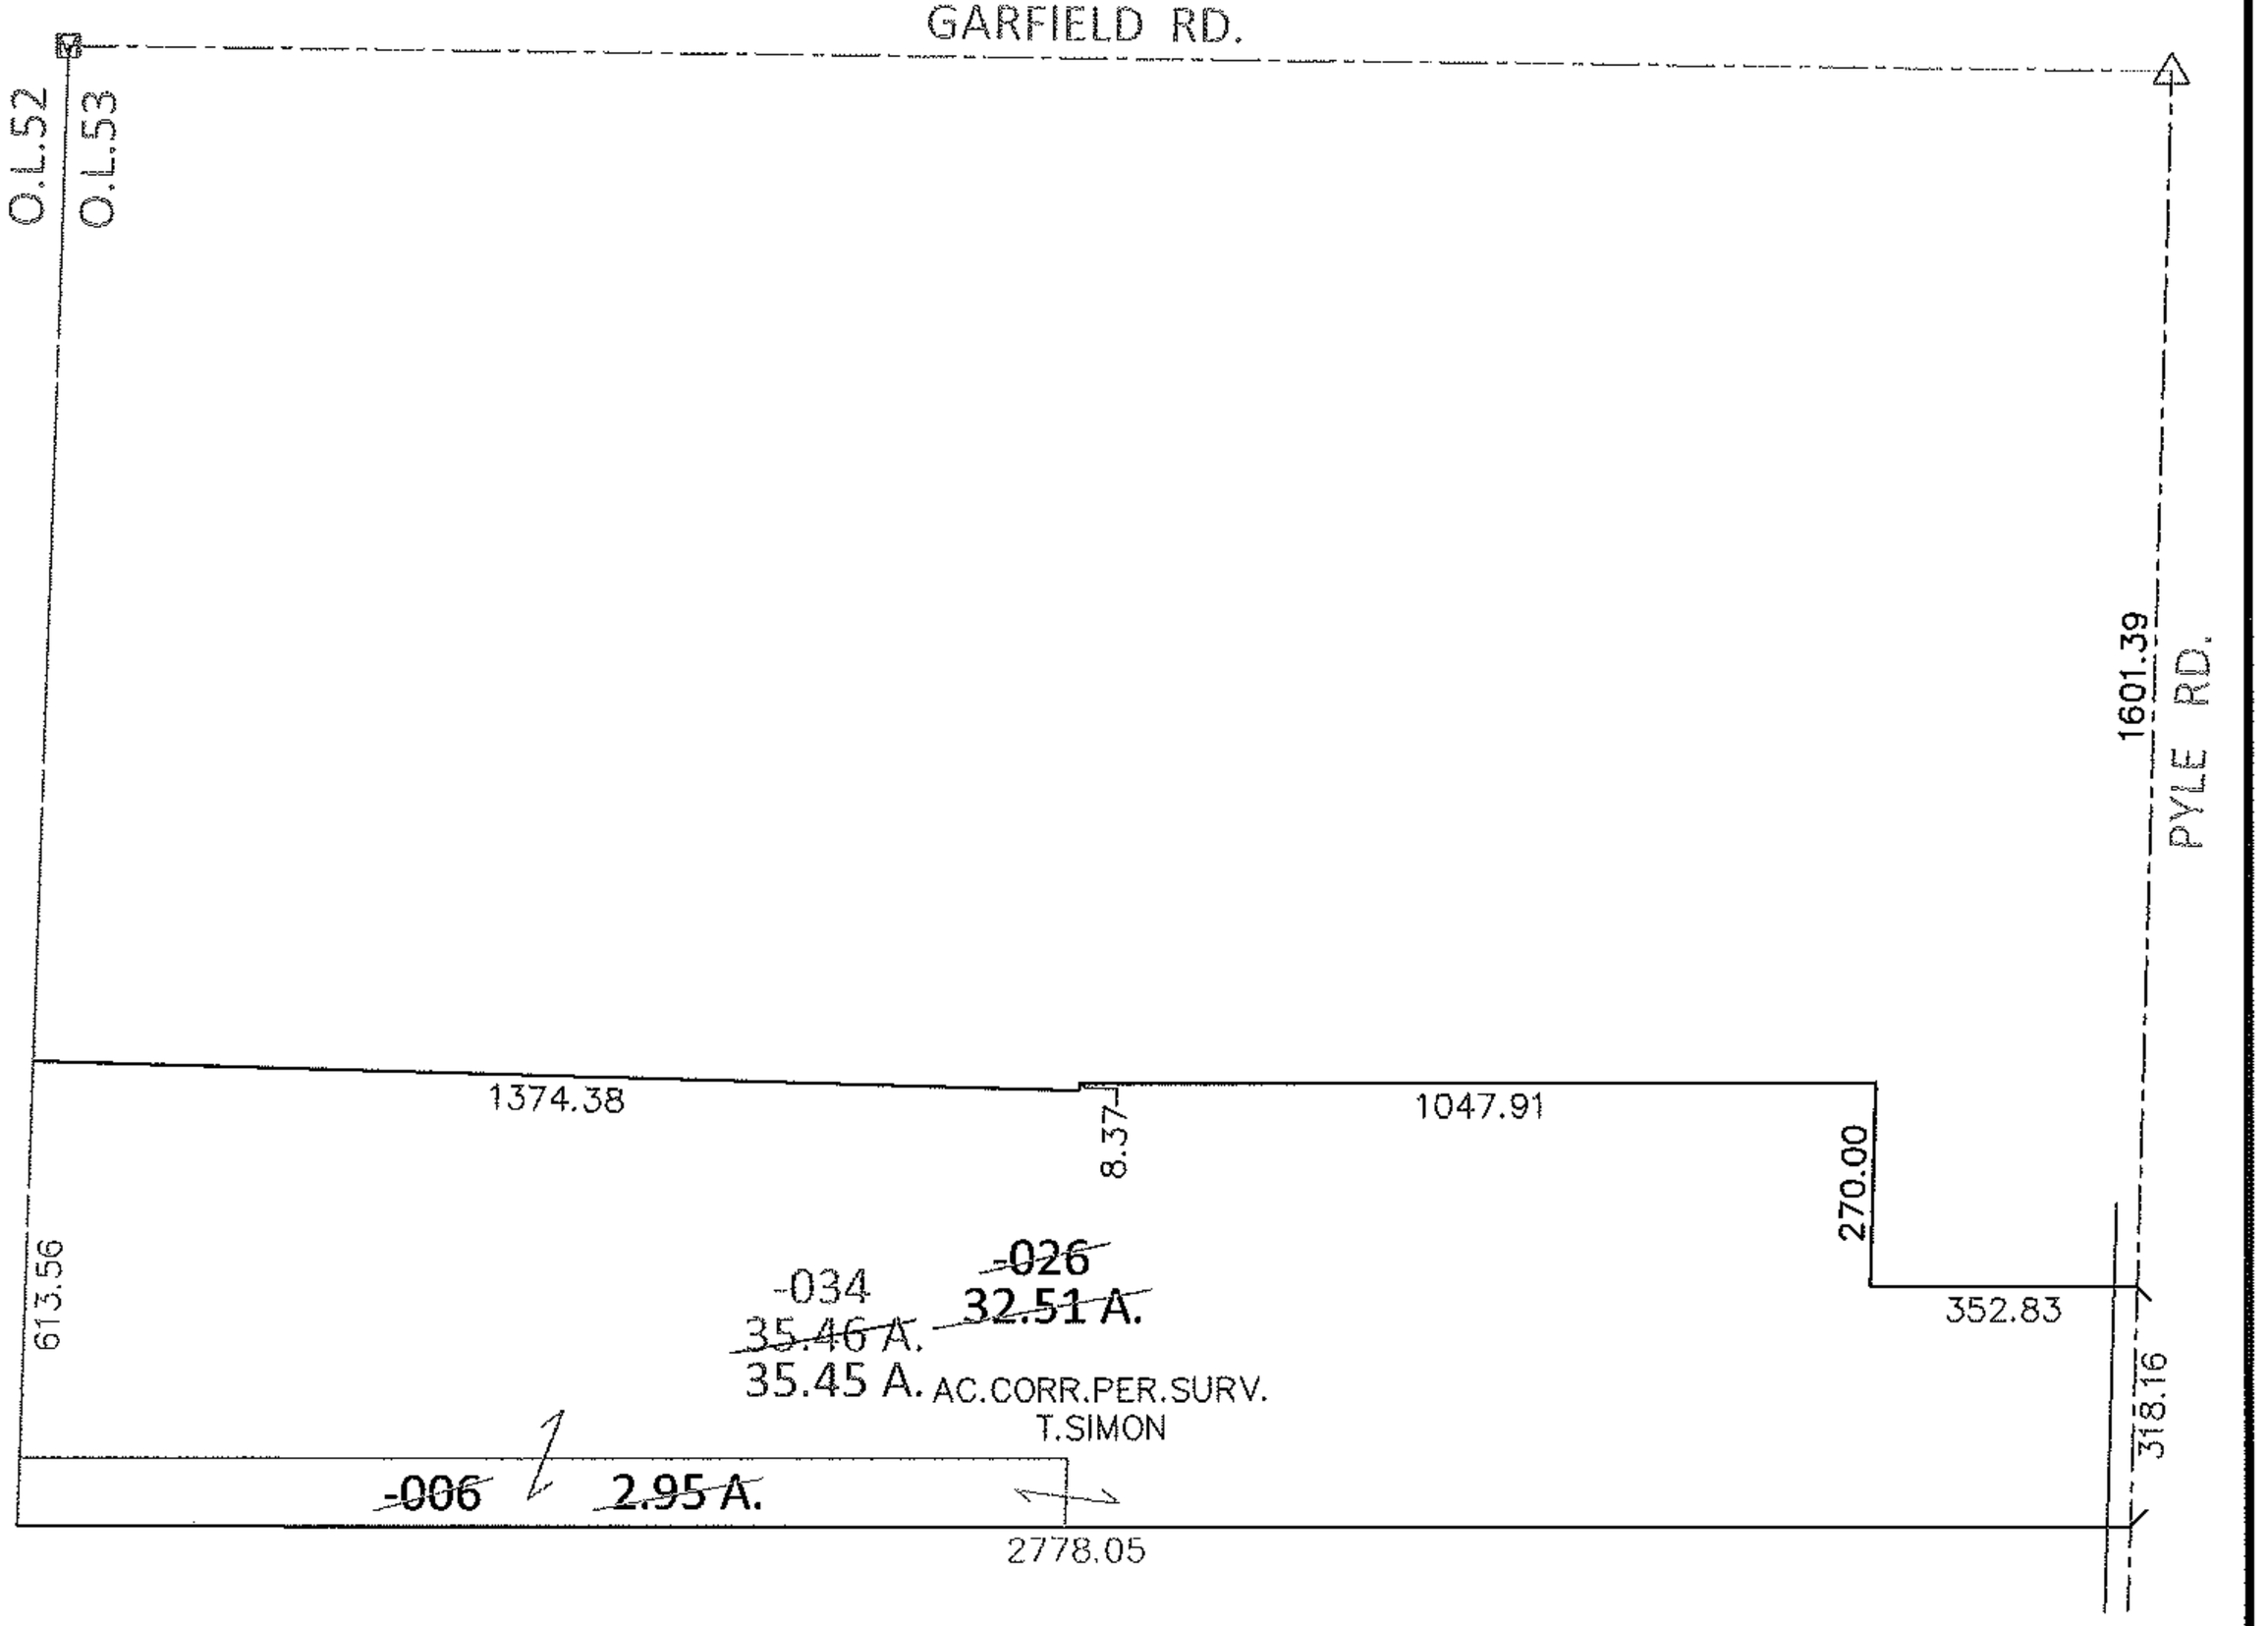

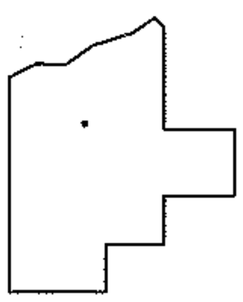

SPLITS/DEEDS PROCESSED

LORAIN COUNTY TAX MAP DEPARTMENT

226 MIDDLE AVE. ELYRIA, OHIO

SURVEYED BY: THOMAS A. SIMON

CLOSURE: .01:10,000

MAP PAGE(S): 9-E

APPROVED BY: RRM DATE: 10-28-13

SCALE: 1"= 400 PRIOR INST.: OR 452/871