PARENT PARCEL: 04-00-011-107-220, -063

CHILD PARCEL: 04-00-011-107-223 THRU -225

STARTING POINT: CENTERLINE OF STONEY RIDGE RD & HARRIMAN TRAIL

10-02849

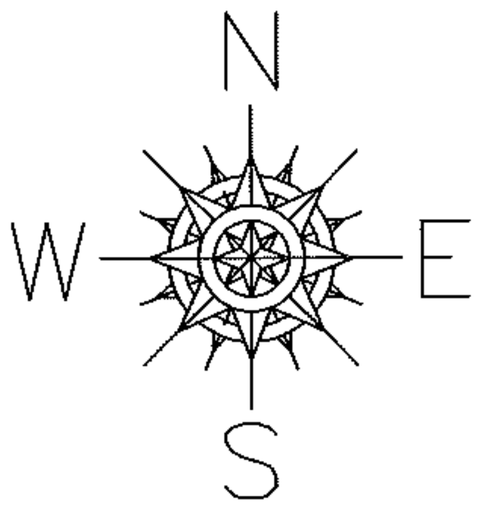

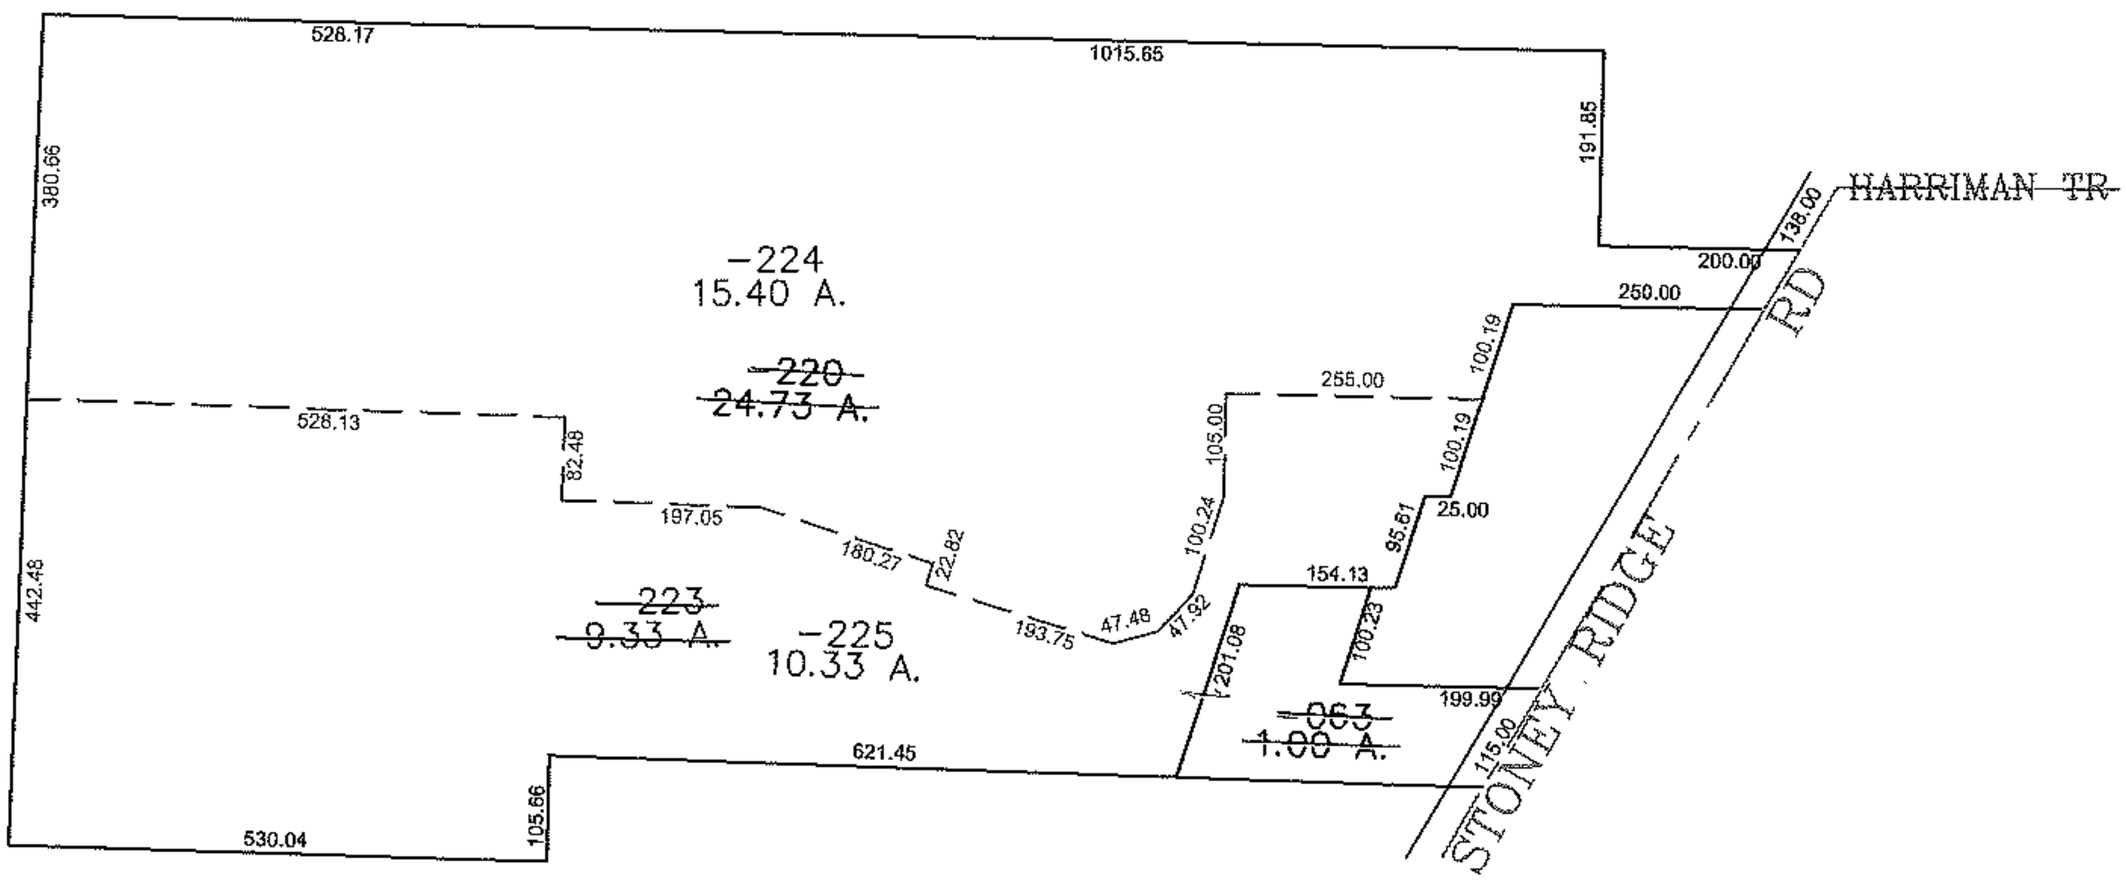

SPLITS/DEEDS PROCESSED

LORAIN COUNTY TAX MAP DEPARTMENT
226 MIDDLE AVE. ELYRIA, OHIO

SURVEYED BY: TREVOR A BIXLER

CLOSURE: 0.00 : 10,000

MAP PAGE(S): 04-00-011-G, F

APPROVED BY: JAH DATE: 8-2-2010

SCALE: 1"= 300 PRIOR INSTRUMENT: 20100328805