RASTER

PARENT PARCEL: 09-00-029-000-003,-009, 09-00-039-000-001,-002,-005

CHILD PARCEL: 09-00-029-000-010, 09-00-039-000-007

STARTING POINT: NORTHWEST CORNER OF O.L.29 ALSO BEING THE C/L OF RUSSIA RD.

10-02855

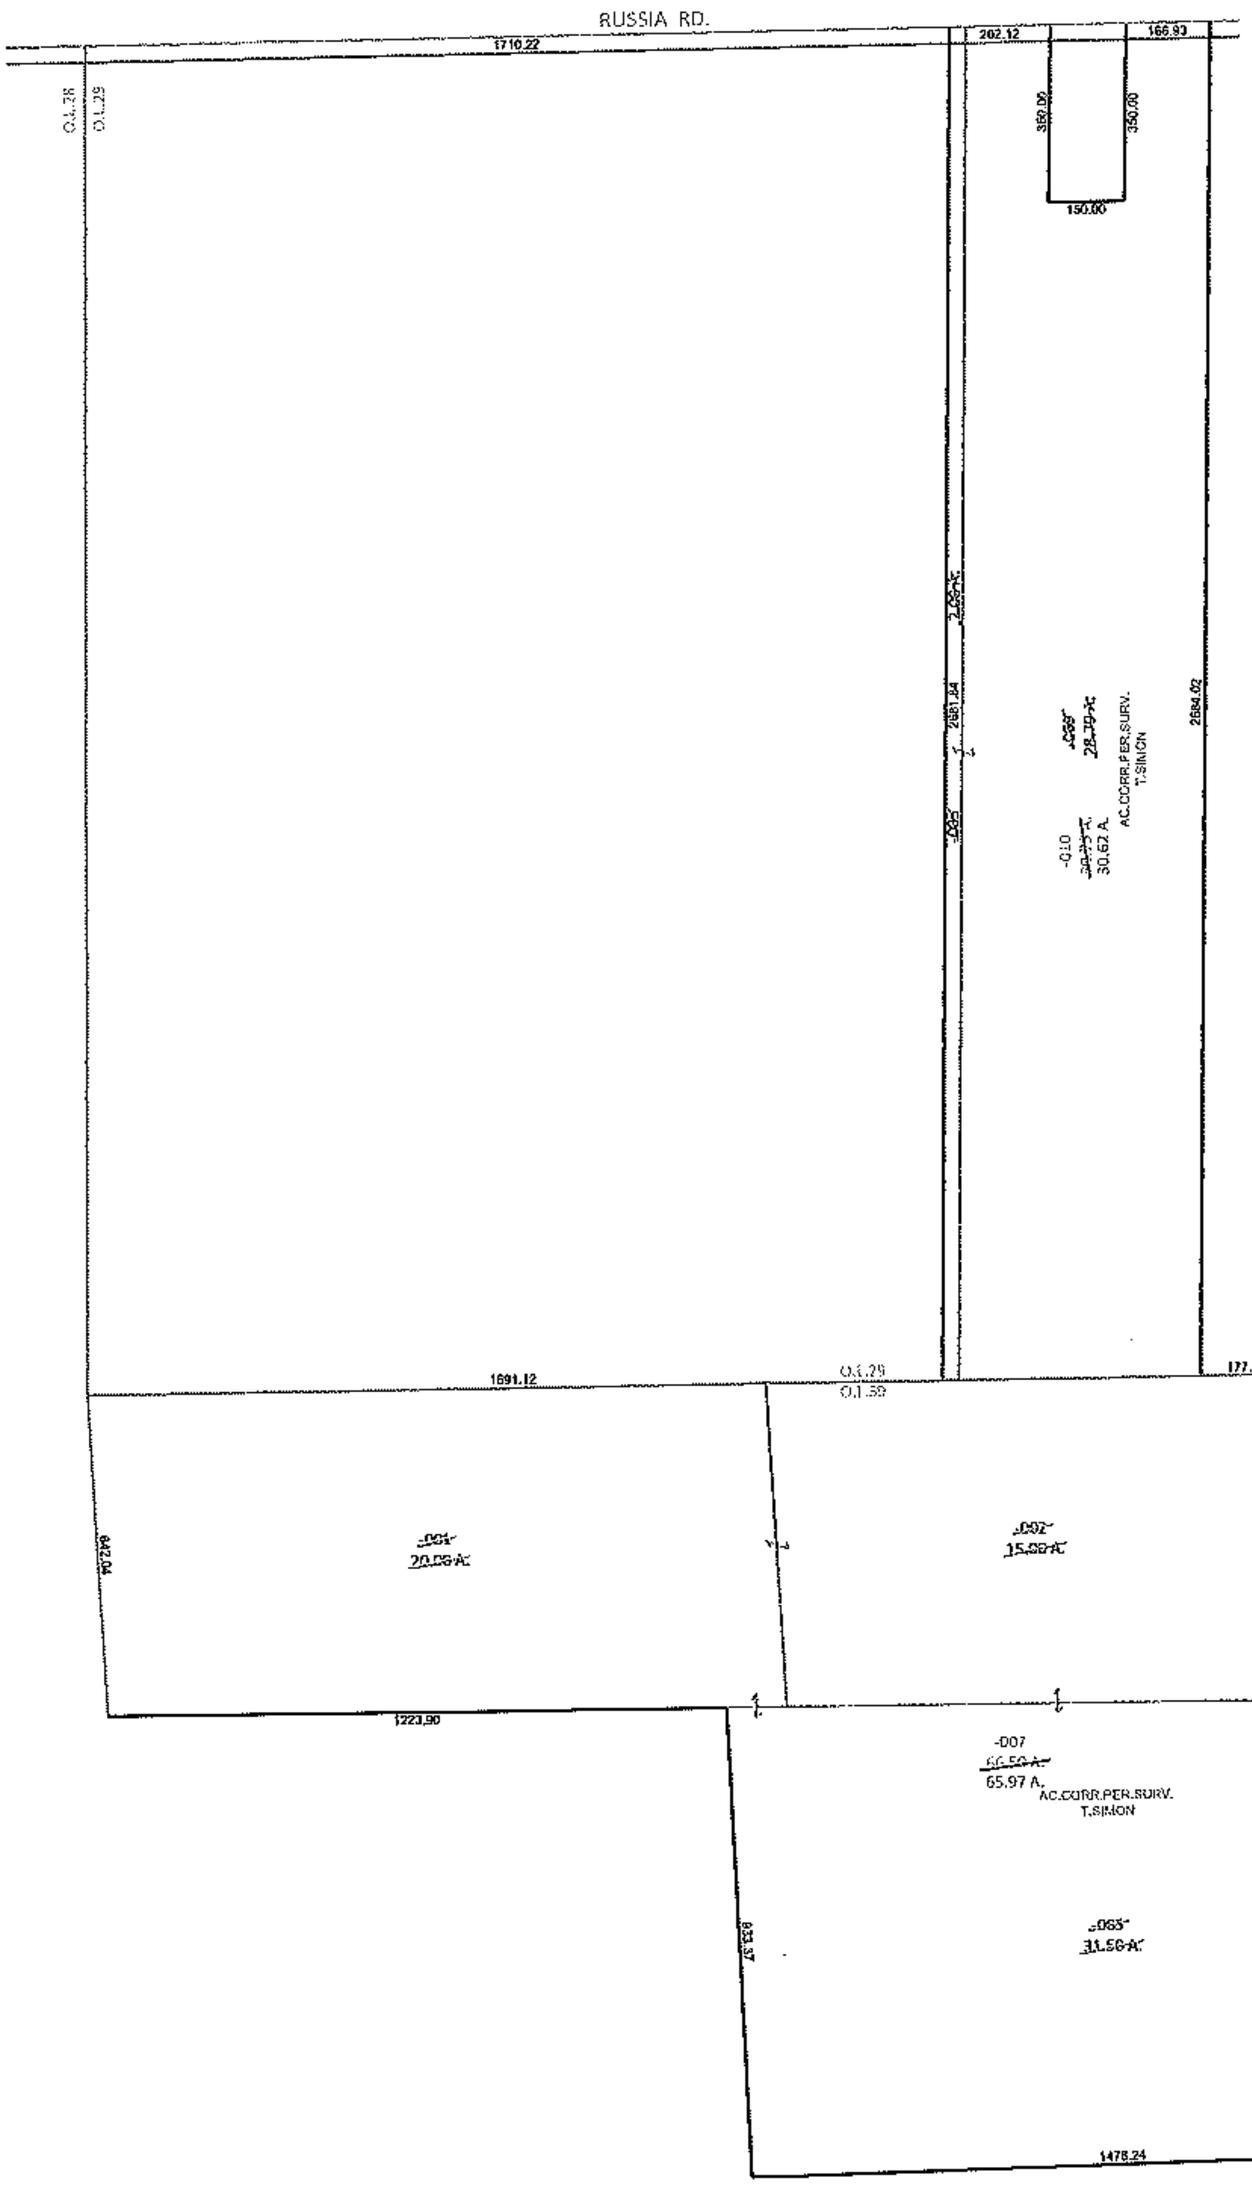

N

W E

S

SPLITS/DEEDS PROCESSED

LORAIN COUNTY TAX MAP DEPARTMENT

226 MIDDLE AVE. ELYRIA, OHIO

SURVEYED BY: THOMAS A. SIMON

CLOSURE: .01:10,000

MAP PAGE(S): 9-D

APPROVED BY: RRM DATE: 9-1-10

SCALE: 1"= 200 PRIOR INST.: 2005062911