PARENT PARCEL: 05-00-061-101-047

CHILD PARCEL:

STARTING POINT: I.P. MON. BOX, CENTERLINE OF COOPER FOSTER RD. & OBERLIN RD.

13-02857-C

N
W E
S

ACREAGE CORRECTION

05-00-061-101-047

~~6.87 A.~~

5.58 A.

A. CORR. PER SURV.
MICHAEL J. THORBAHN

PER INST. # 20010775097

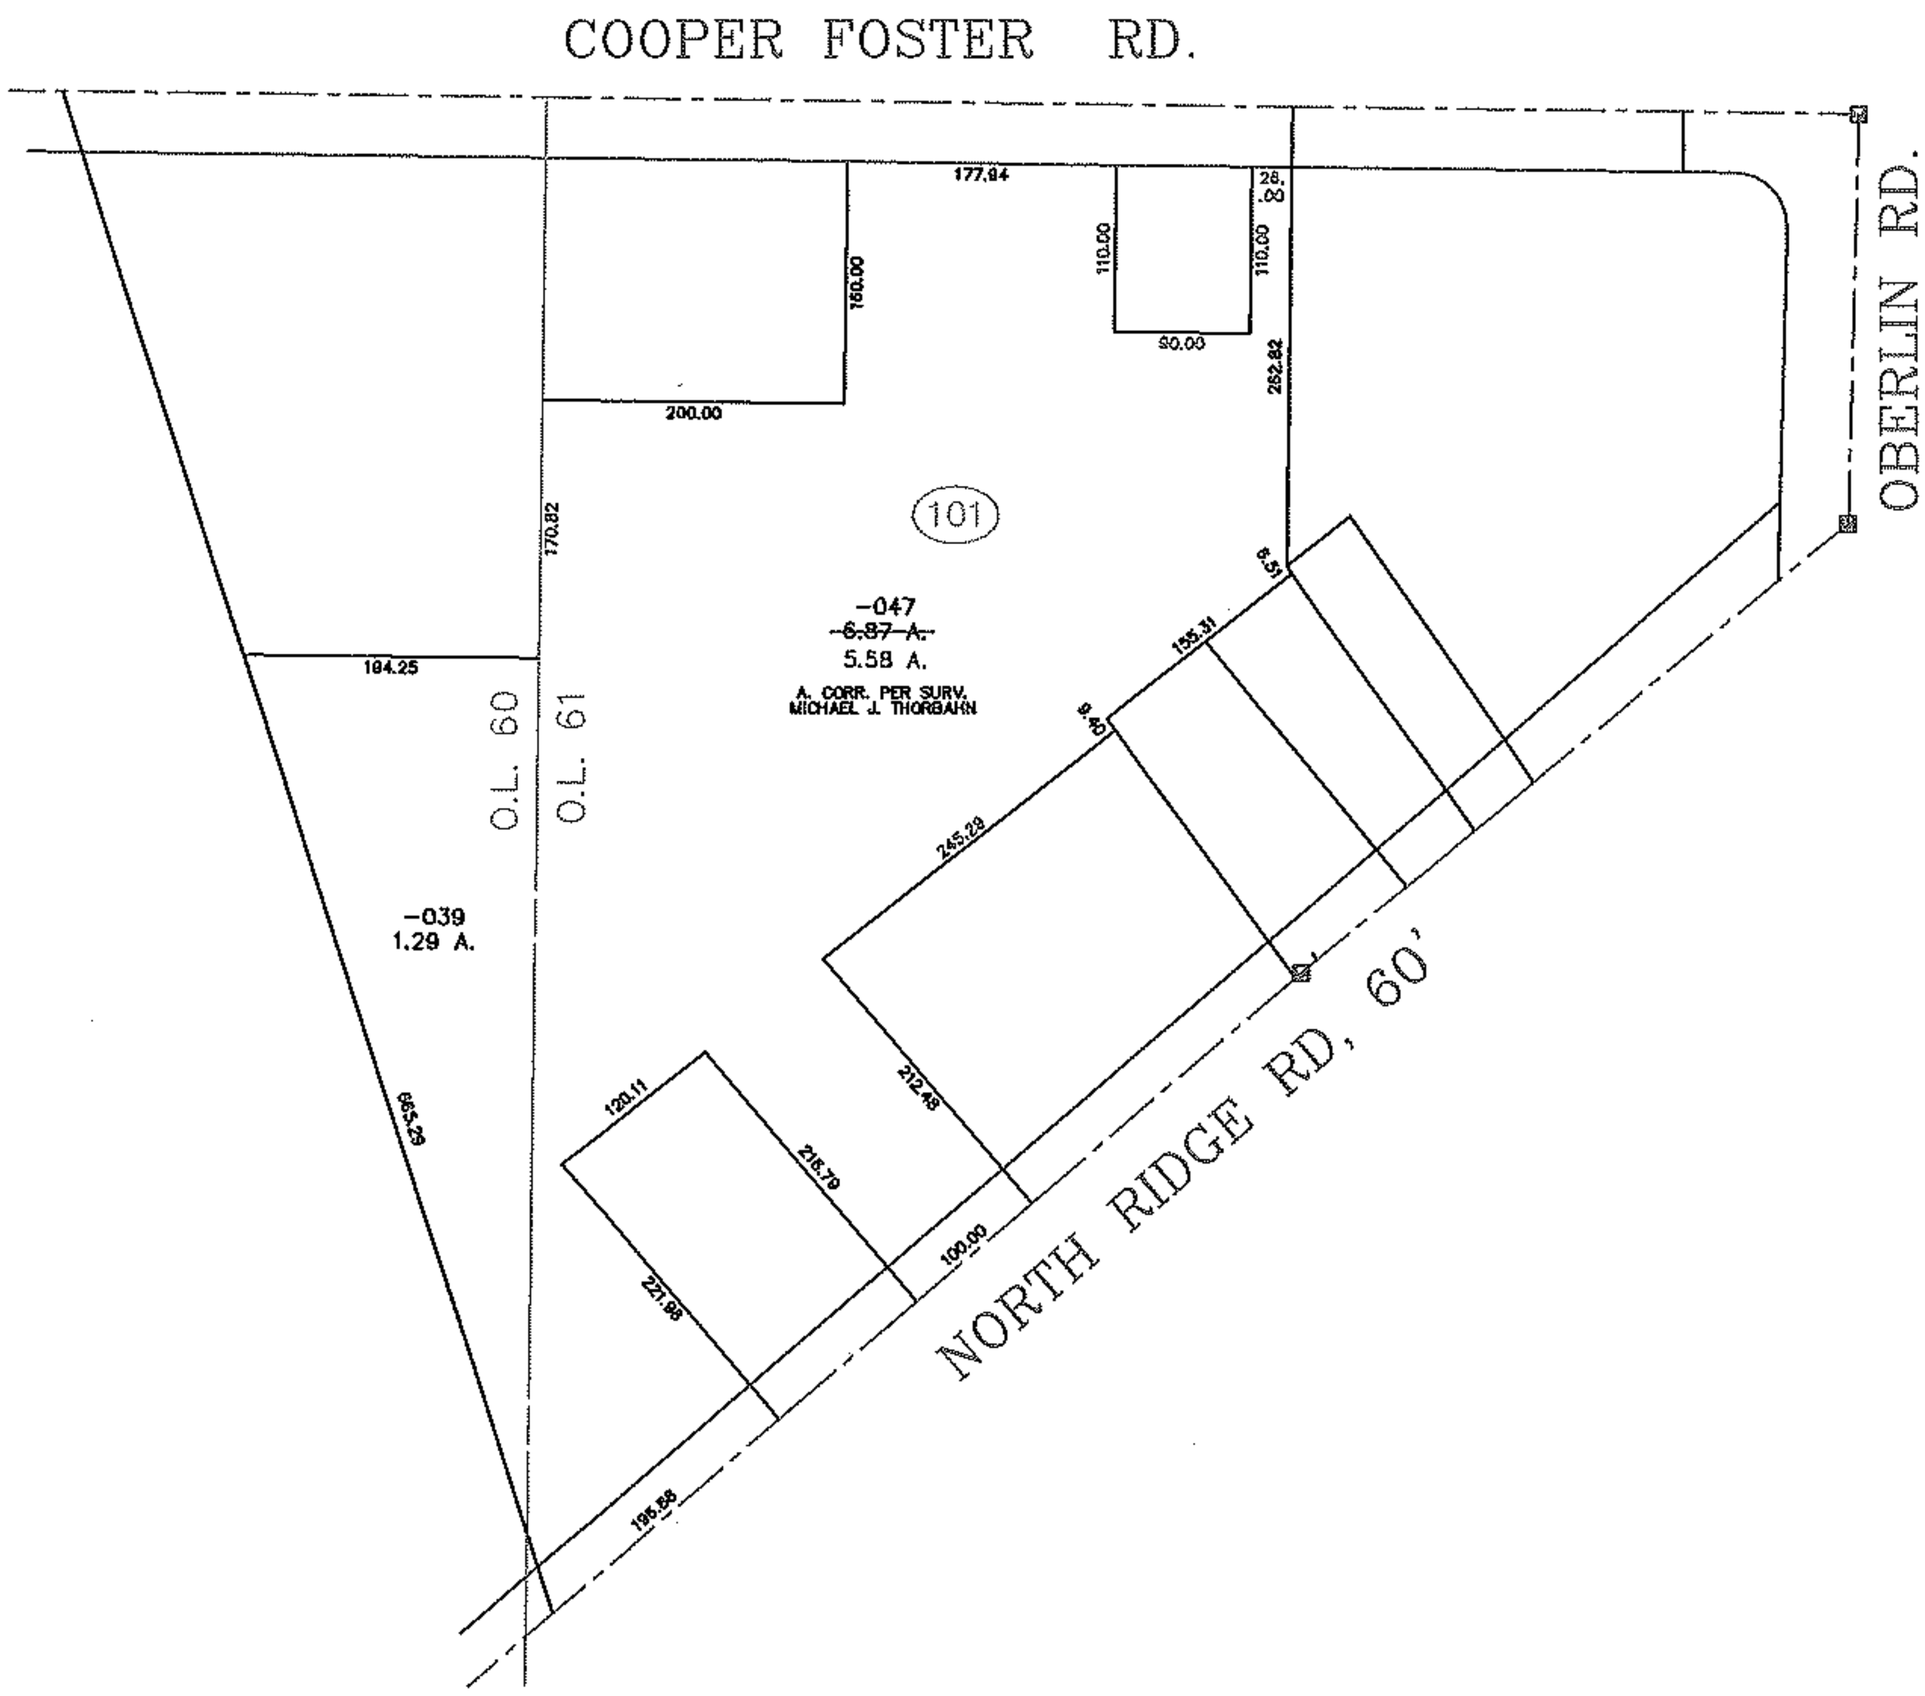

SPLITS/DEEDS PROCESSED

LORAIN COUNTY TAX MAP DEPARTMENT
226 MIDDLE AVE. ELYRIA, OHIO

SURVEYED BY: MICHAEL J. THORBAHN

CLOSURE: 0.00 : 10,000

MAP PAGE(S): 05-00-060-B, -061-A

APPROVED BY: TJS DATE: 12/14/13

SCALE: 1"= 200 PRIOR INSTRUMENT: DV 1380/143