PARENT PARCEL: 11-00-100-106-004

CHILD PARCEL: 11-00-100-106-006 & -007

STARTING POINT: CL OF ELYRIA - MEDINA RD. (S.R. 57) & CL OF PARSONS RD.

10-02861

SPLIT

~~11-00-100-106-004~~
~~1.12 A.~~

11-00-100-106-006
1.01 A.

REMAINDER

11-00-100-106-007
~~0.11 A.~~
0.14 A.

AC. CORR. PER SURV.
M. BRAMHALL

STRAIGHT TRANS.

16-00-001-101-014
~~0.04 A.~~
0.05 A.

AC. CORR. PER SURV.
M. BRAMHALL

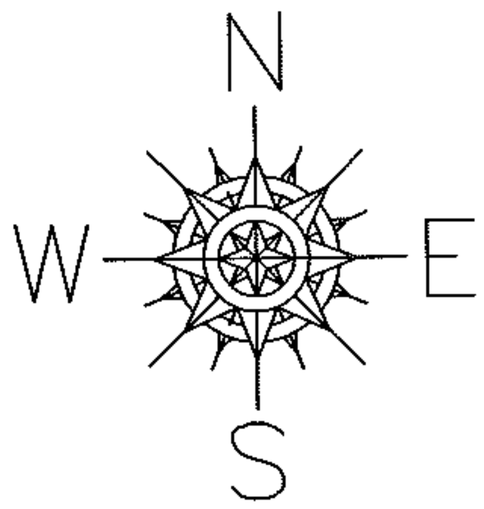

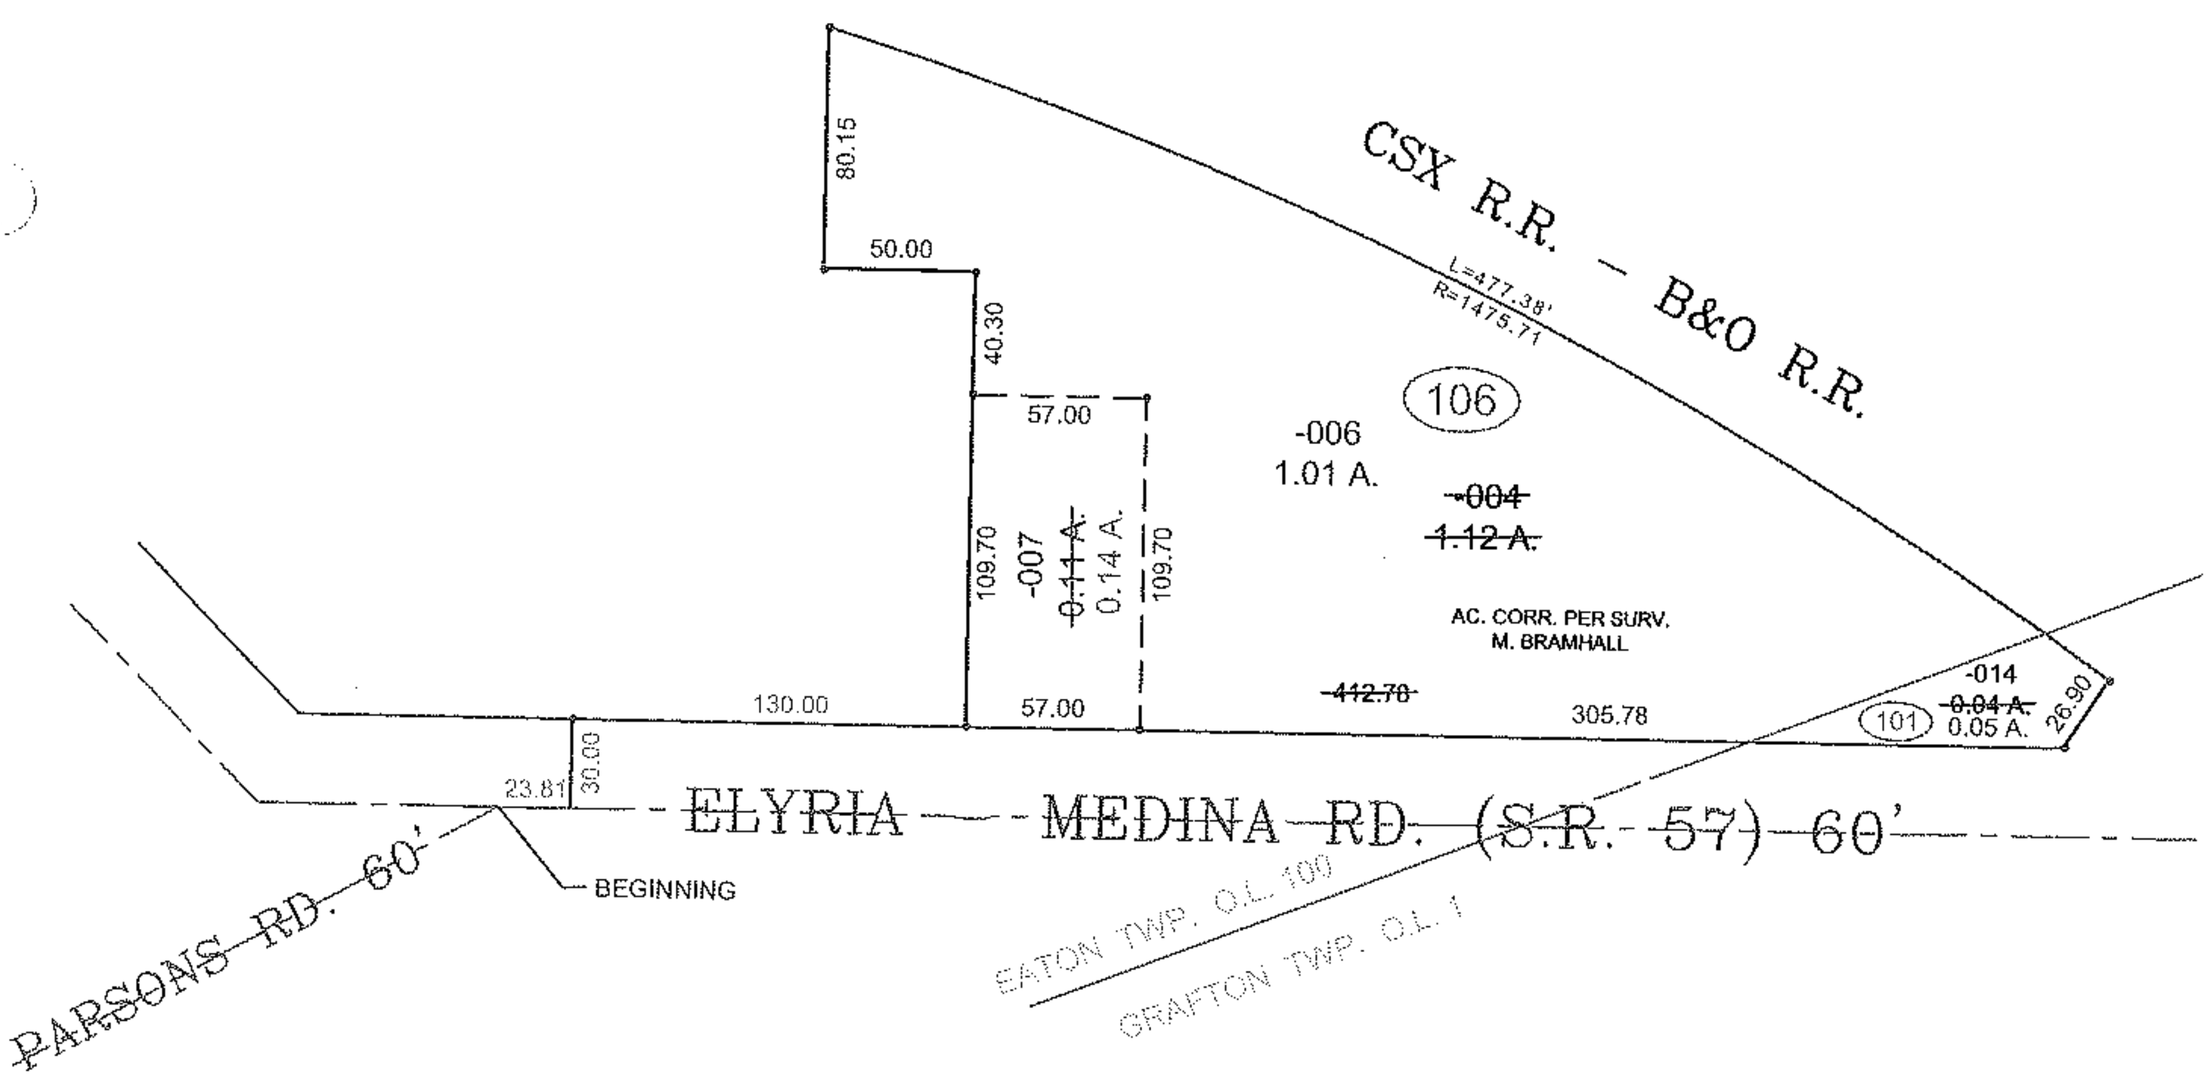

SPLITS/DEEDS PROCESSED

LORAIN COUNTY TAX MAP DEPARTMENT
226 MIDDLE AVE. ELYRIA, OHIO

SURVEYED BY: MICHAEL BRAMHALL
CLOSURE: 0.01 : 10,000
MAP PAGE(S): 11-00-081 & 11-00-100-B
APPROVED BY: TJS DATE: 10/12/10
SCALE: 1"= 100 PRIOR INST.: DV 435/549