PARENT PARCEL: ADD TO DUPLICATE

CHILD PARCEL: 12-00-076-630-001

STARTING POINT: XXXXXX

14-02869-A

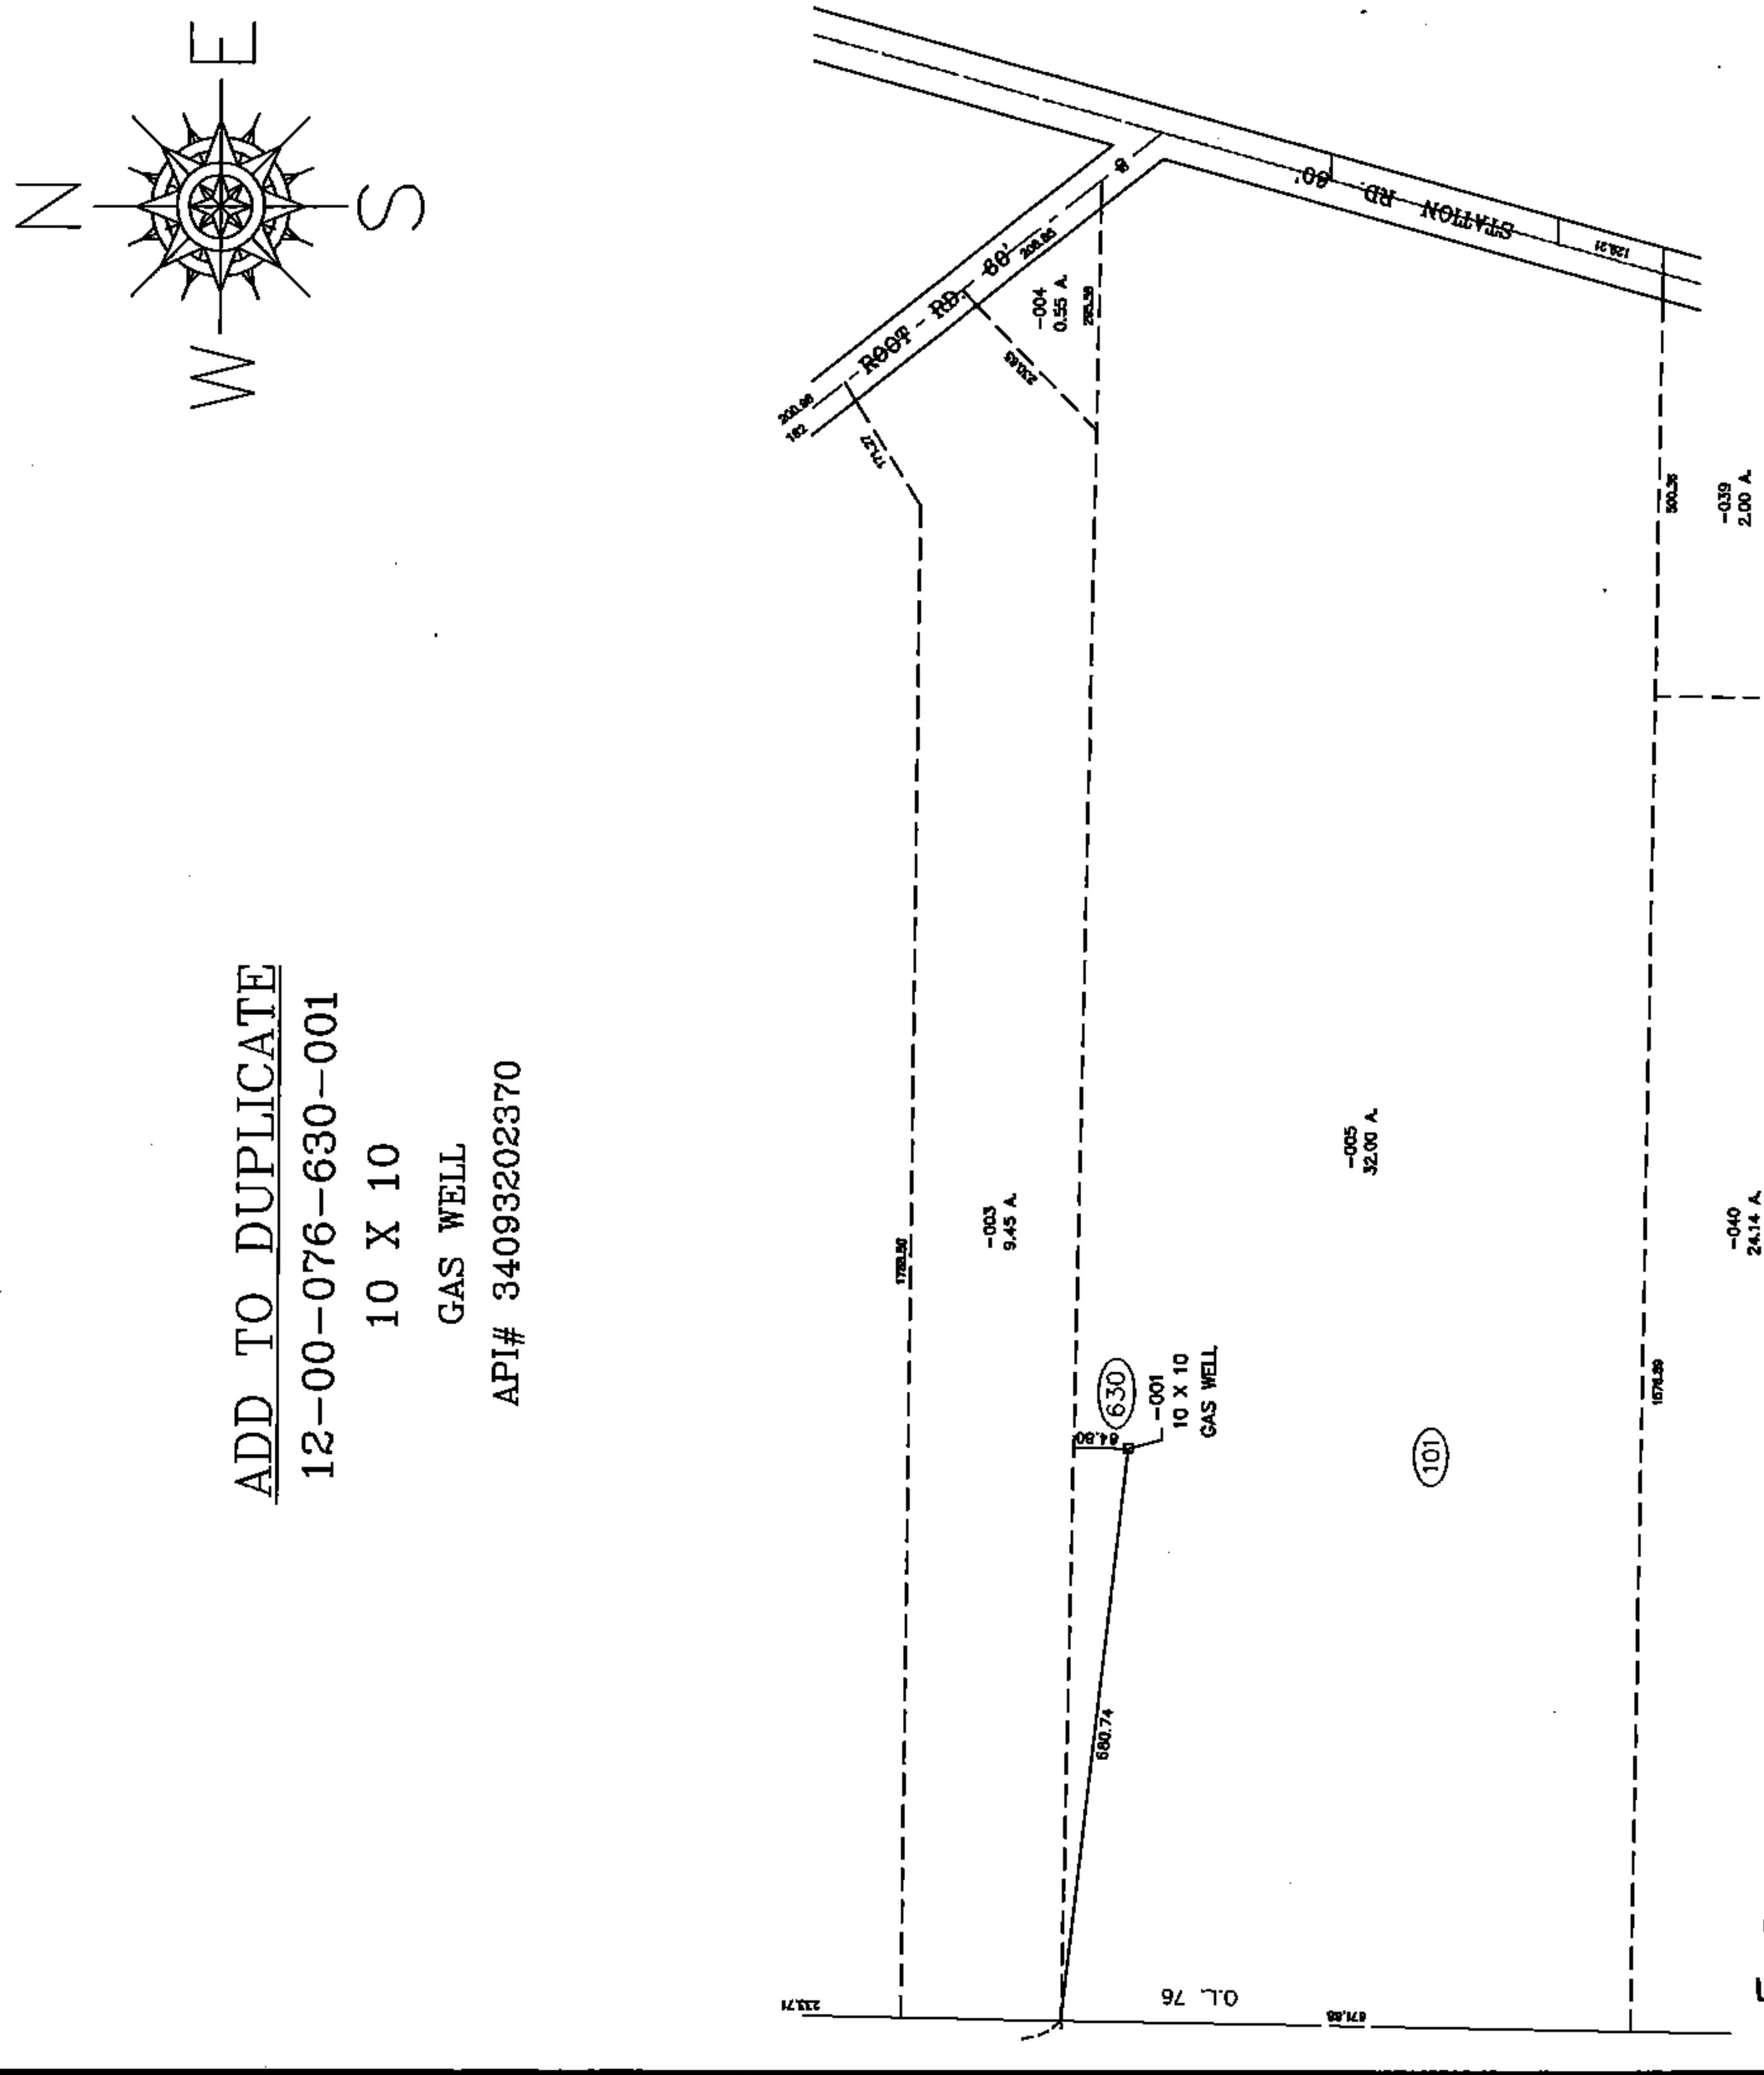

SPLITS/DEEDS PROCESSED

LORAIN COUNTY TAX MAP DEPARTMENT
226 MIDDLE AVE. ELYRIA, OHIO

SURVEYED BY: NONE

CLOSURE: NA

MAP PAGE(S): 12-00-076

APPROVED BY: TJS DATE: 1/16/14

SCALE: 1"= 300 PRIOR INSTRUMENT: NA