PARENT PARCEL: 18-00-047-000-021, -022

CHILD PARCEL: 18-00-047-000-023 THRU -025

STARTING POINT: NORTHEAST CORNER OF BRIGHTON TWP. O.L.30

10-02873

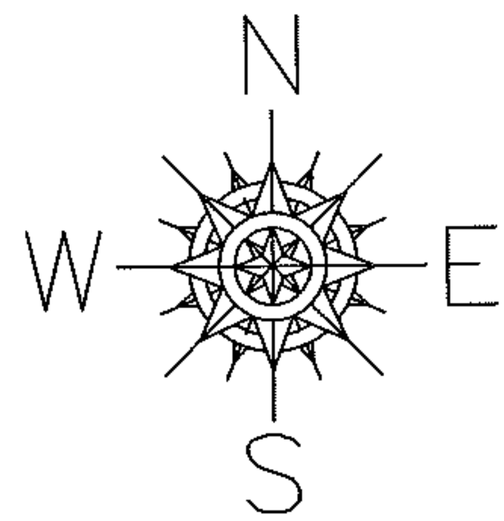

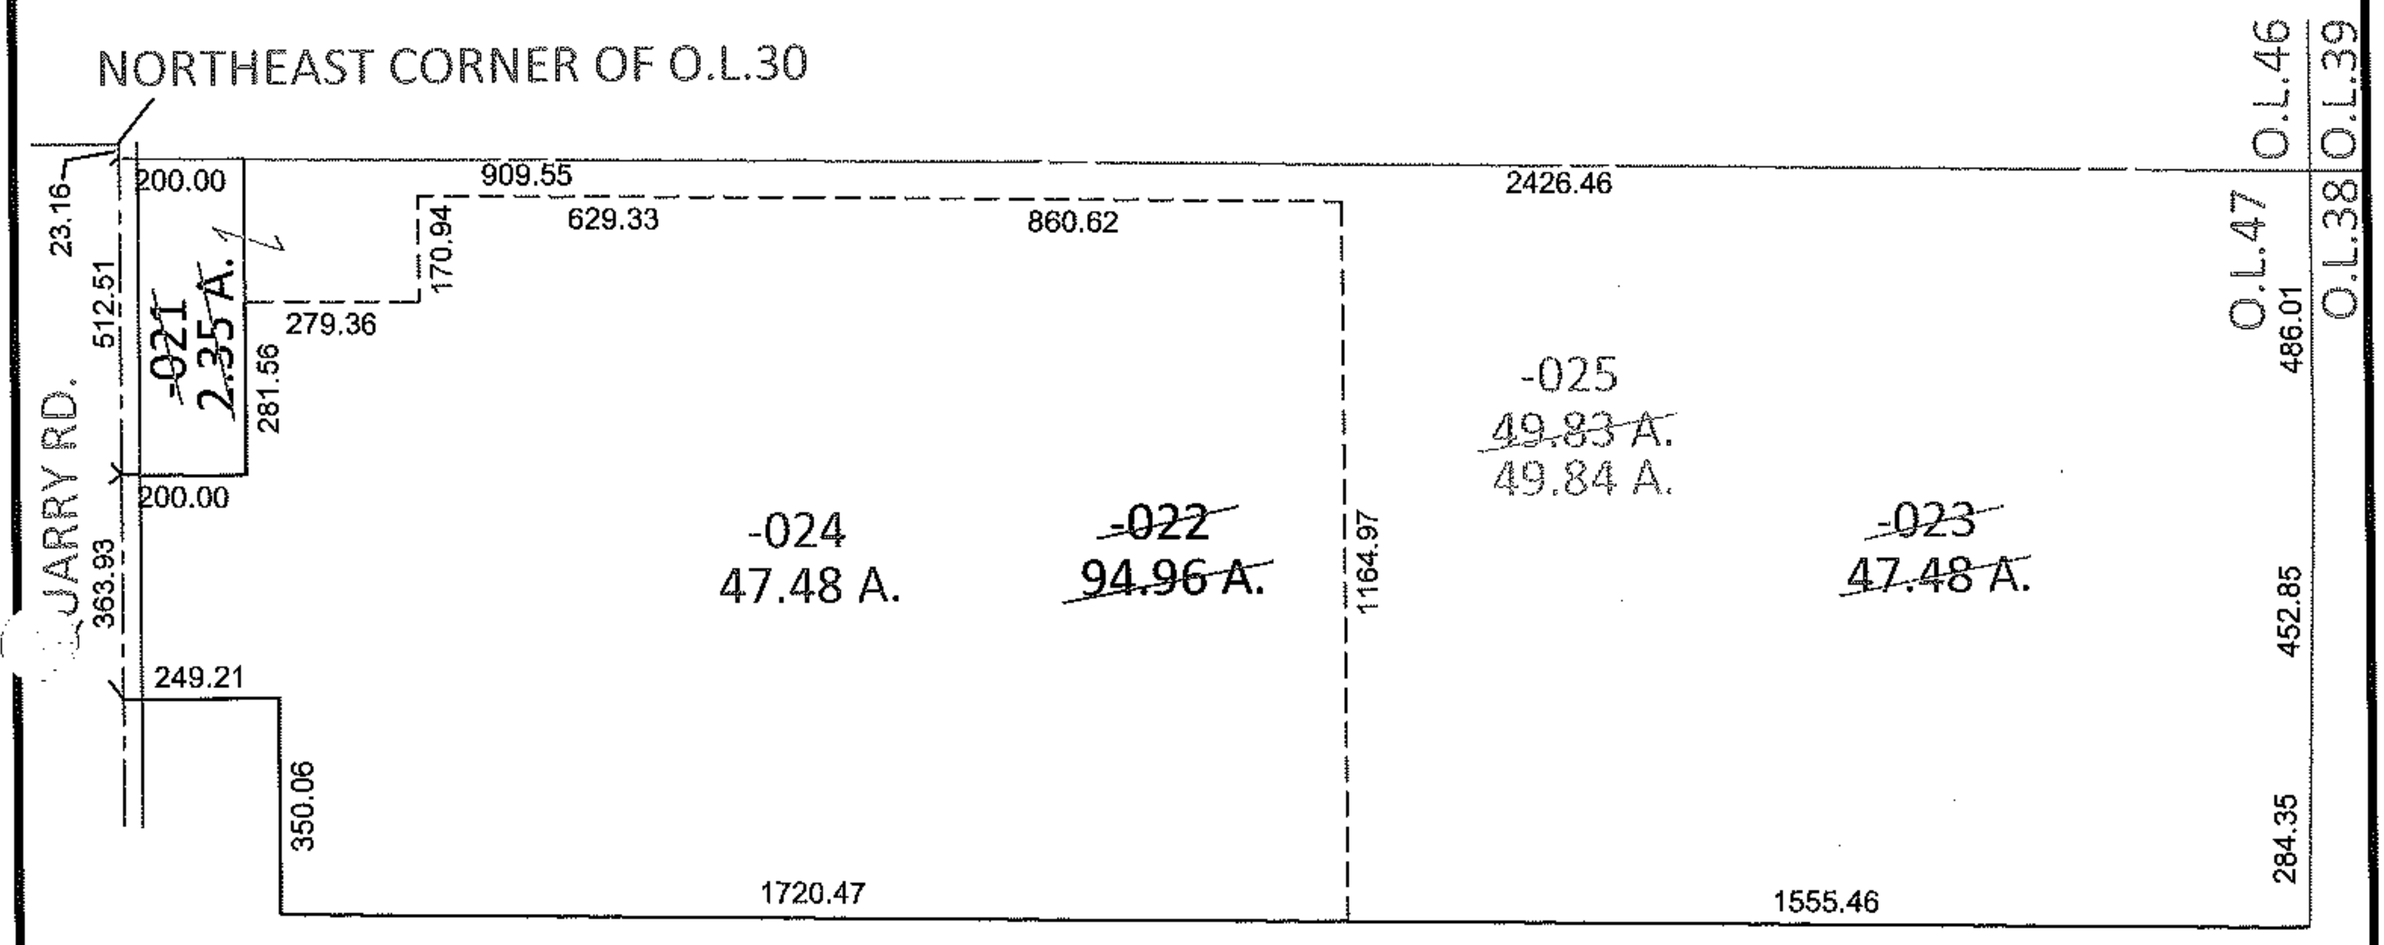

SPLITS/DEEDS PROCESSED

LORAIN COUNTY TAX MAP DEPARTMENT
226 MIDDLE AVE. ELYRIA, OHIO

SURVEYED BY: RICHARD D. CARLSON

CLOSURE: .01:10,000

MAP PAGE(S): 18-E

APPROVED BY: RRM DATE: 11-10-10

SCALE: 1"= 500 PRIOR INST.: 20050089638