RASTER

PARENT PARCEL: 14-00-141-000-003, -020

CHILD PARCEL: 14-00-141-000-022

STARTING POINT: CENTERLINE OF WEST RD & O.L. 141

11-02896

N

W E

S

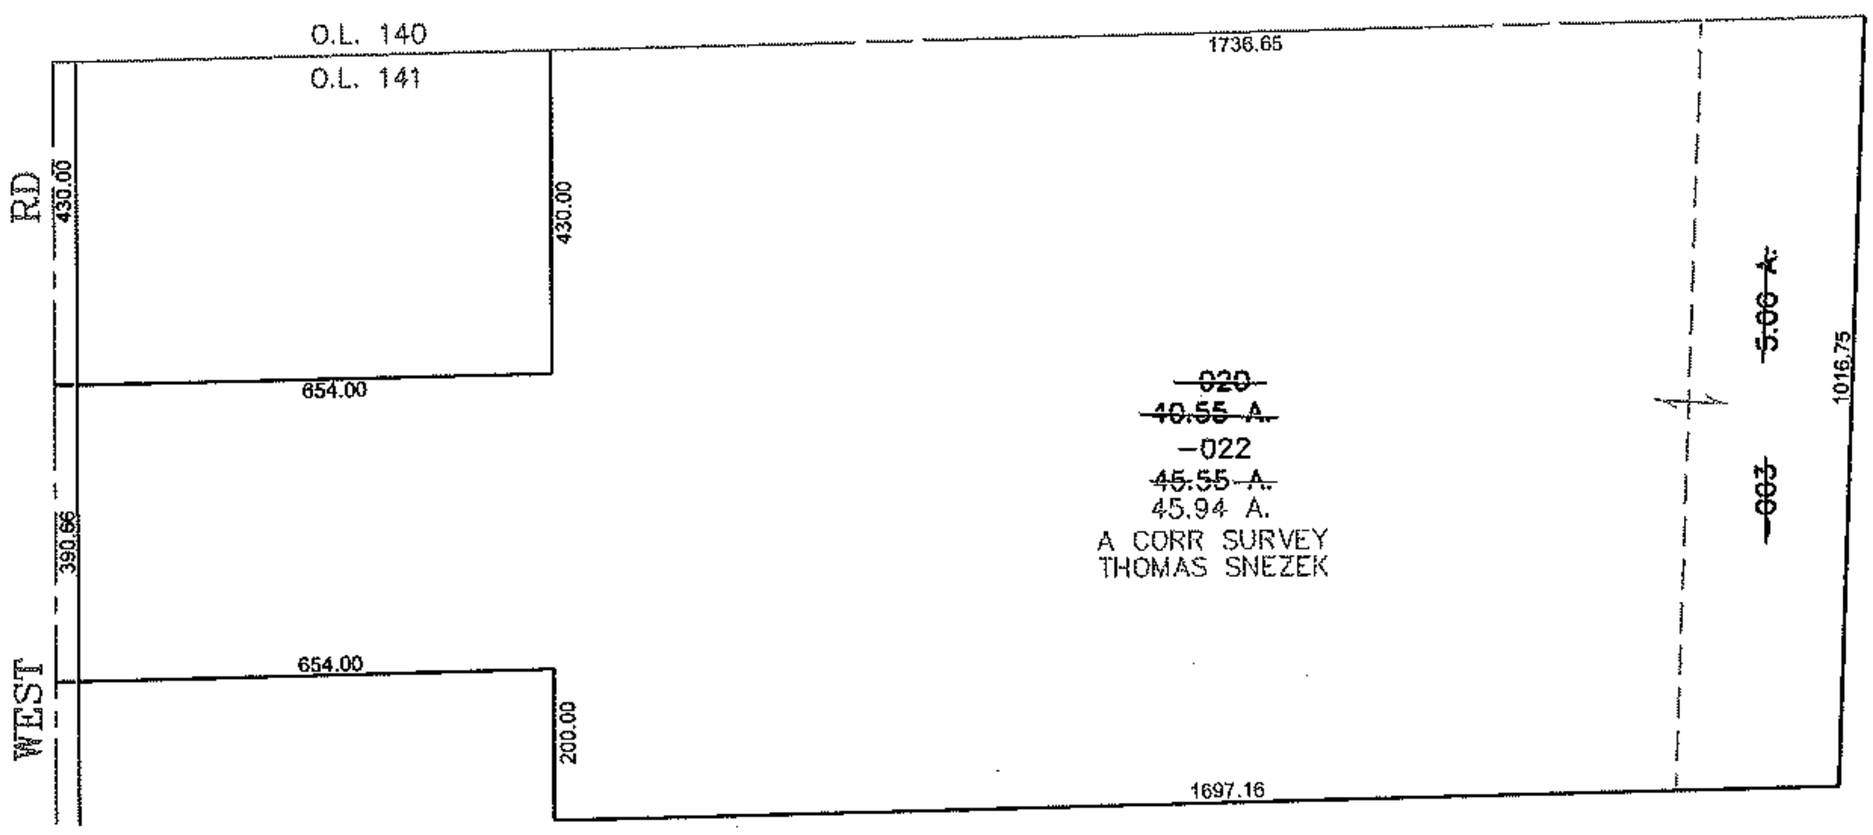

SPLITS/DEEDS PROCESSED

LORAIN COUNTY TAX MAP DEPARTMENT

226 MIDDLE AVE. ELYRIA, OHIO

SURVEYED BY: THOMAS SNEZEK

CLOSURE: 0.00 : 10,000

MAP PAGE(S): 14-H

APPROVED BY: JAH DATE: 2/2/2011

SCALE: 1"= 400 PRIOR INST.: 20010789365