PARENT PARCEL: 07-00-013-000-121, 07-00-024-101-080

CHILD PARCEL: 07-00-024-110, -111 07-00-013-000-442, -443

STARTING POINT: NORTHEAST CORNER OF O.L. 24 & LORAIN RD

11-02904

N

W E

S

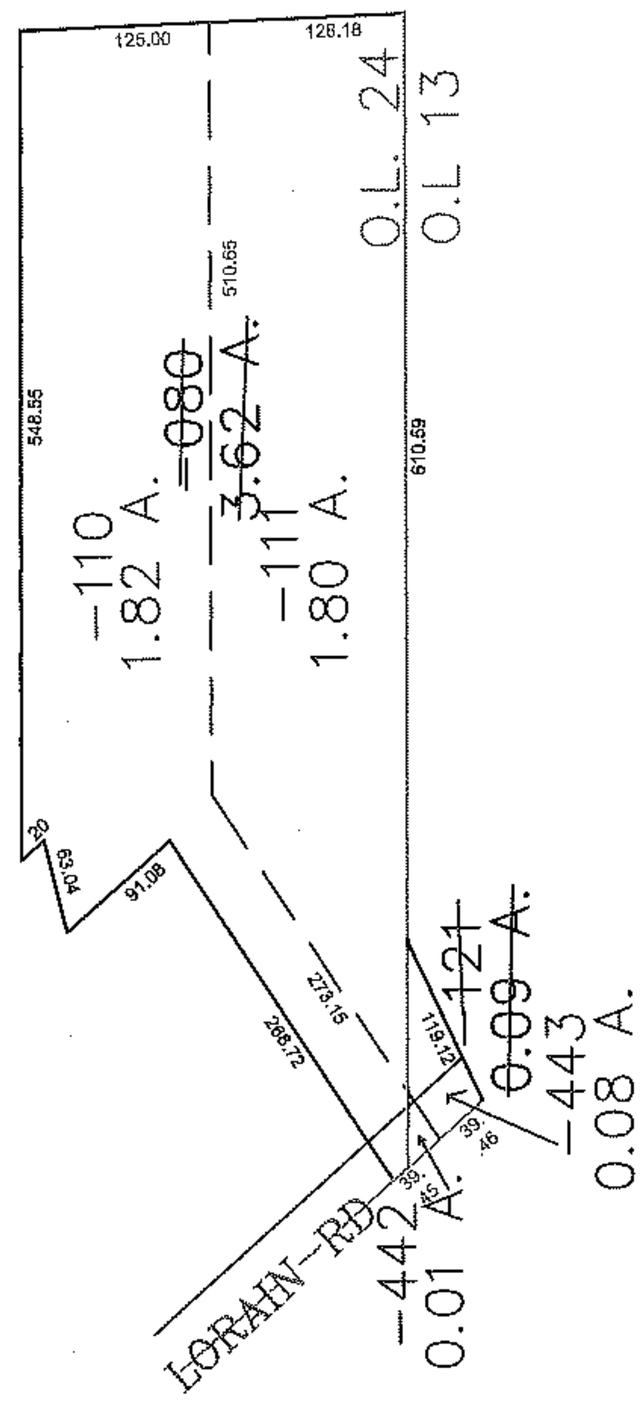

SPLITS/DEEDS PROCESSED

LORAIN COUNTY TAX MAP DEPARTMENT
226 MIDDLE AVE. ELYRIA, OHIO

SURVEYED BY: DANE HAPONEK

CLOSURE: 0.00 : 10,000

MAP PAGE(S): 07-00-013-A

APPROVED BY: JAH DATE: 3/10/11

SCALE: 1"= 200 PRIOR INSTRUMENT: 19950361031