PARENT PARCEL: 02-00-051-129-017

CHILD PARCEL: 02-00-051-129-020, -021

STARTING POINT: SW CORNER OF S/L 141 & NORTHERLY RW LINE OF "G" ST

11-02917

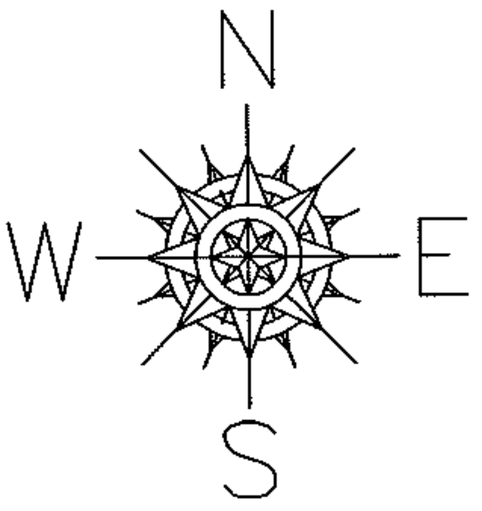

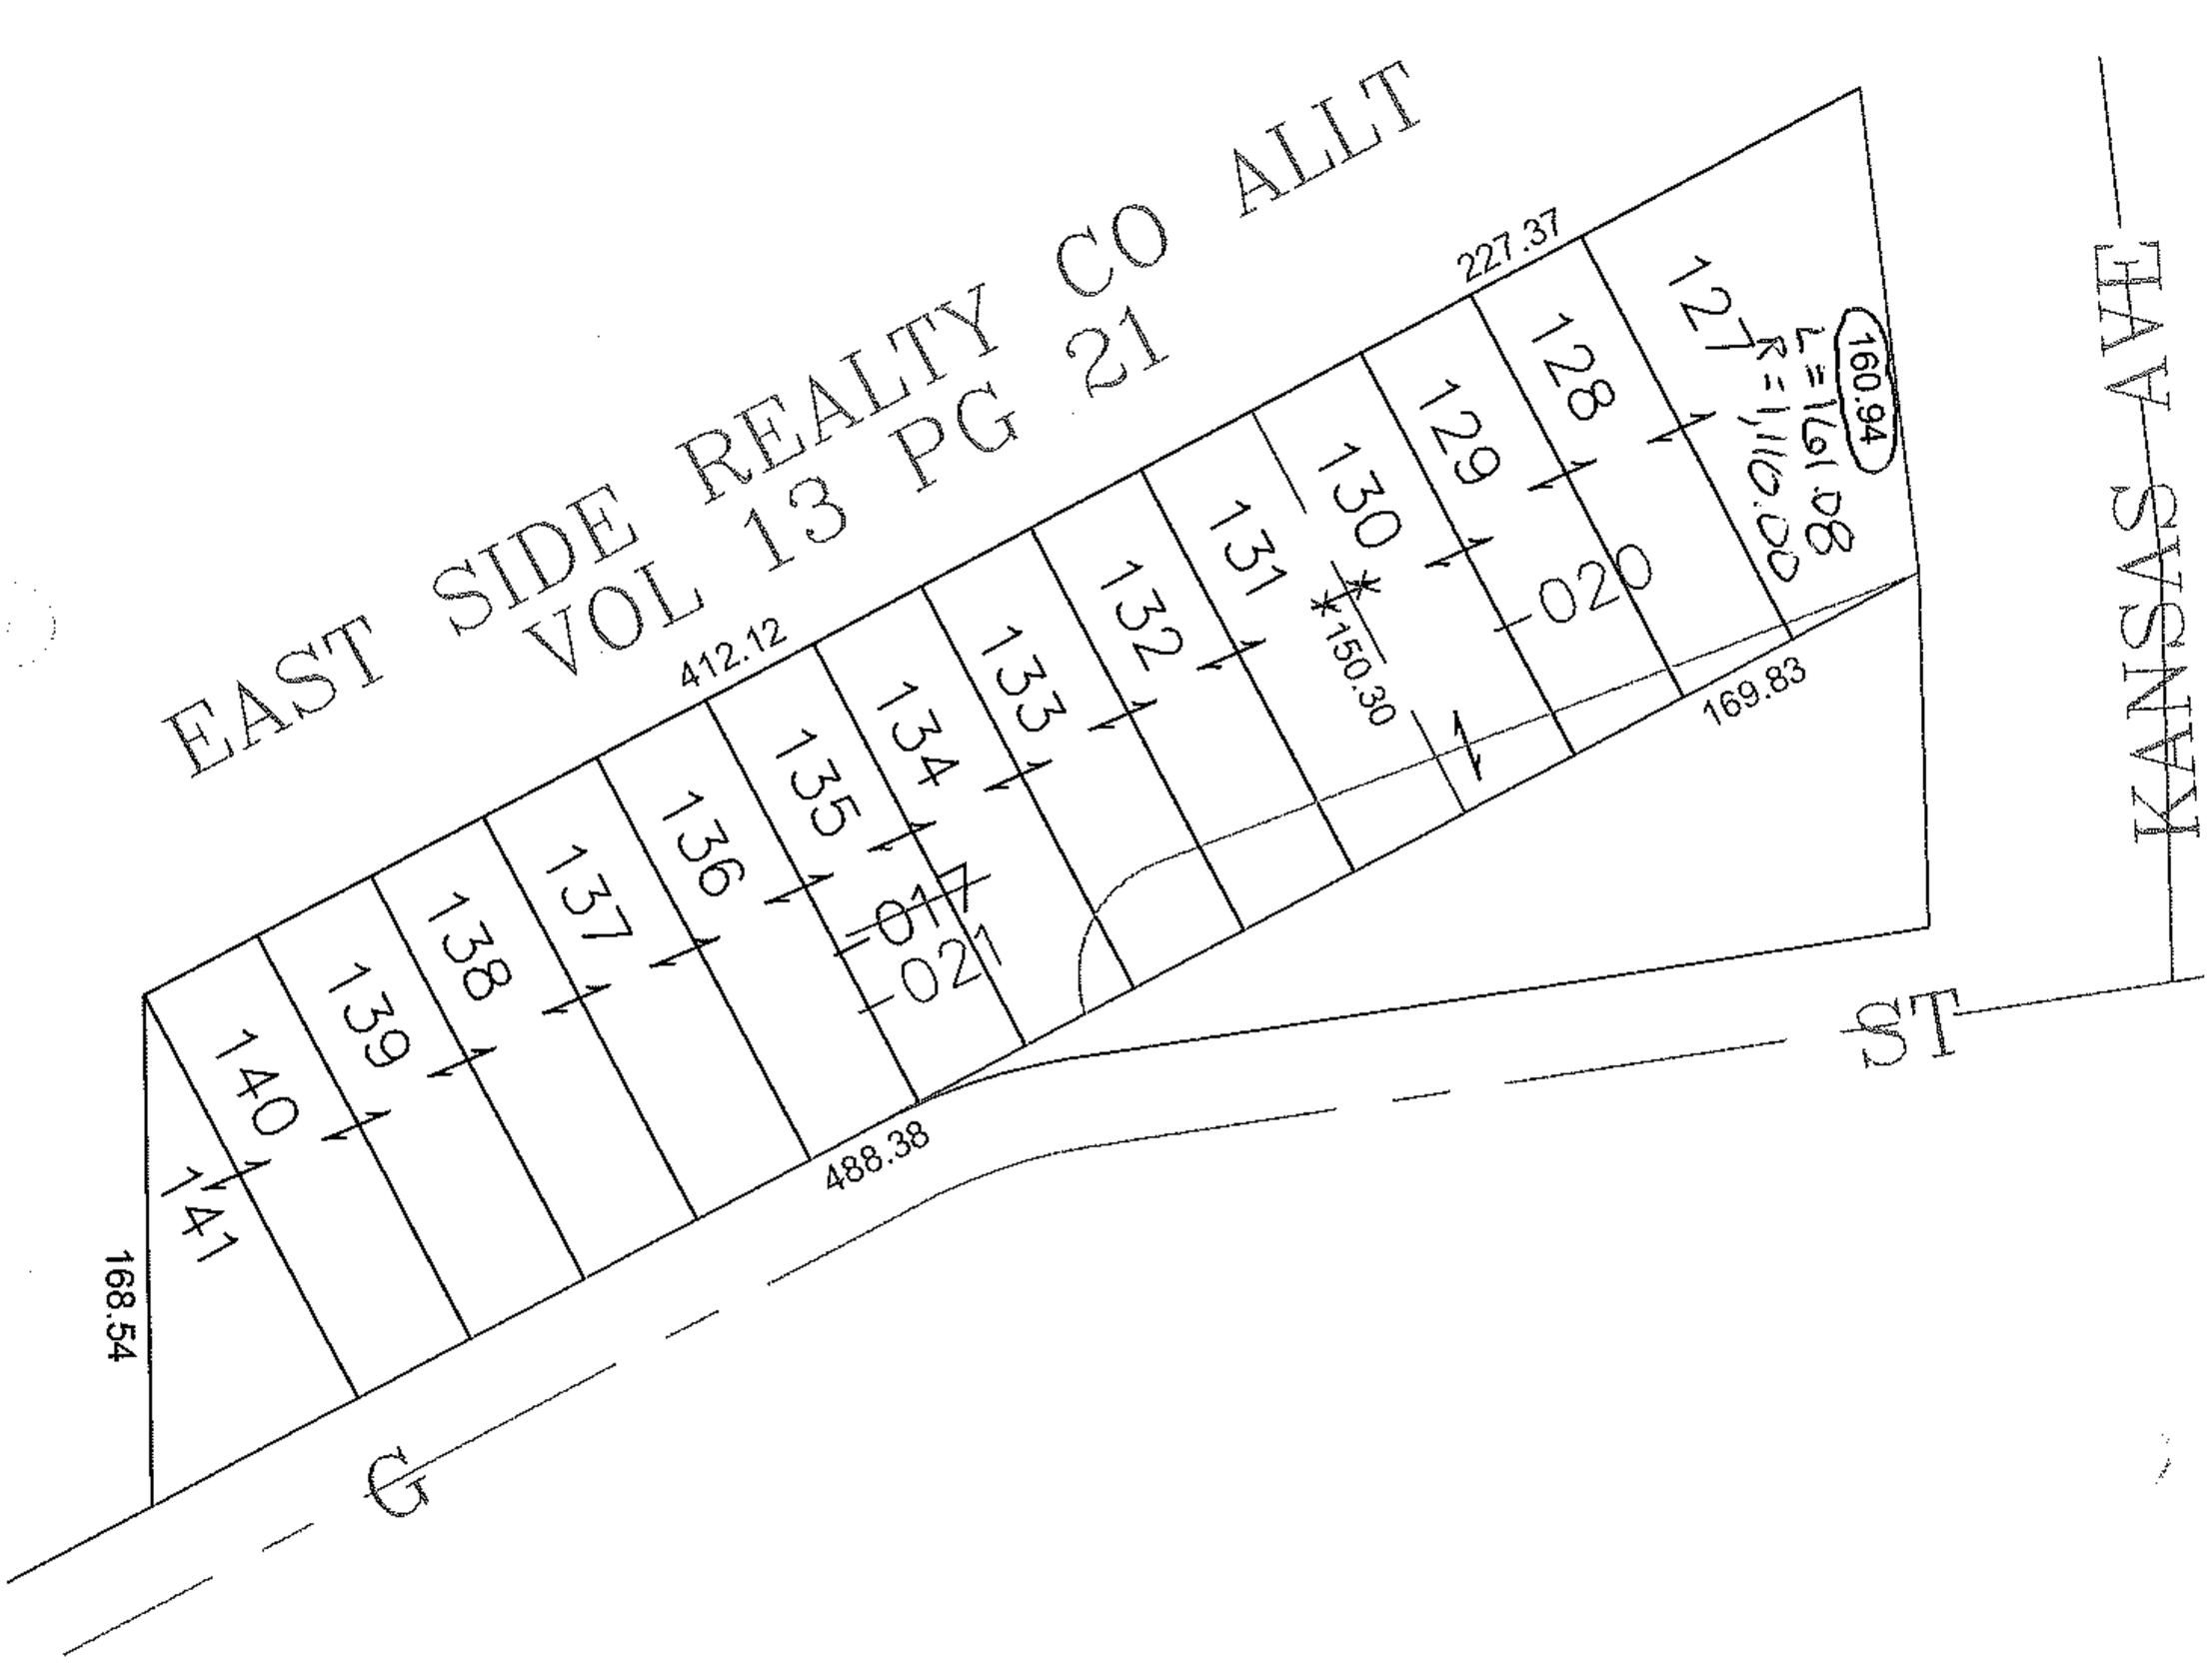

SPLITS/DEEDS PROCESSED

LORAIN COUNTY TAX MAP DEPARTMENT
226 MIDDLE AVE. ELYRIA, OHIO

SURVEYED BY: KEVIN CLARK

CLOSURE: 0.00 : 10,000

MAP PAGE(S): 02-00-051-A

APPROVED BY: JAH DATE: 5-4-2011

SCALE: 1"= 100 PRIOR INSTRUMENT: 20040023076