PARENT PARCEL: 04-00-018-128-231, 230

CHILD PARCEL: 04-00-018-128-233 THRU -238

STARTING POINT: CENTERLINE OF WALKER RD & AVON BELDEN RD

11-02921

N

W E

S

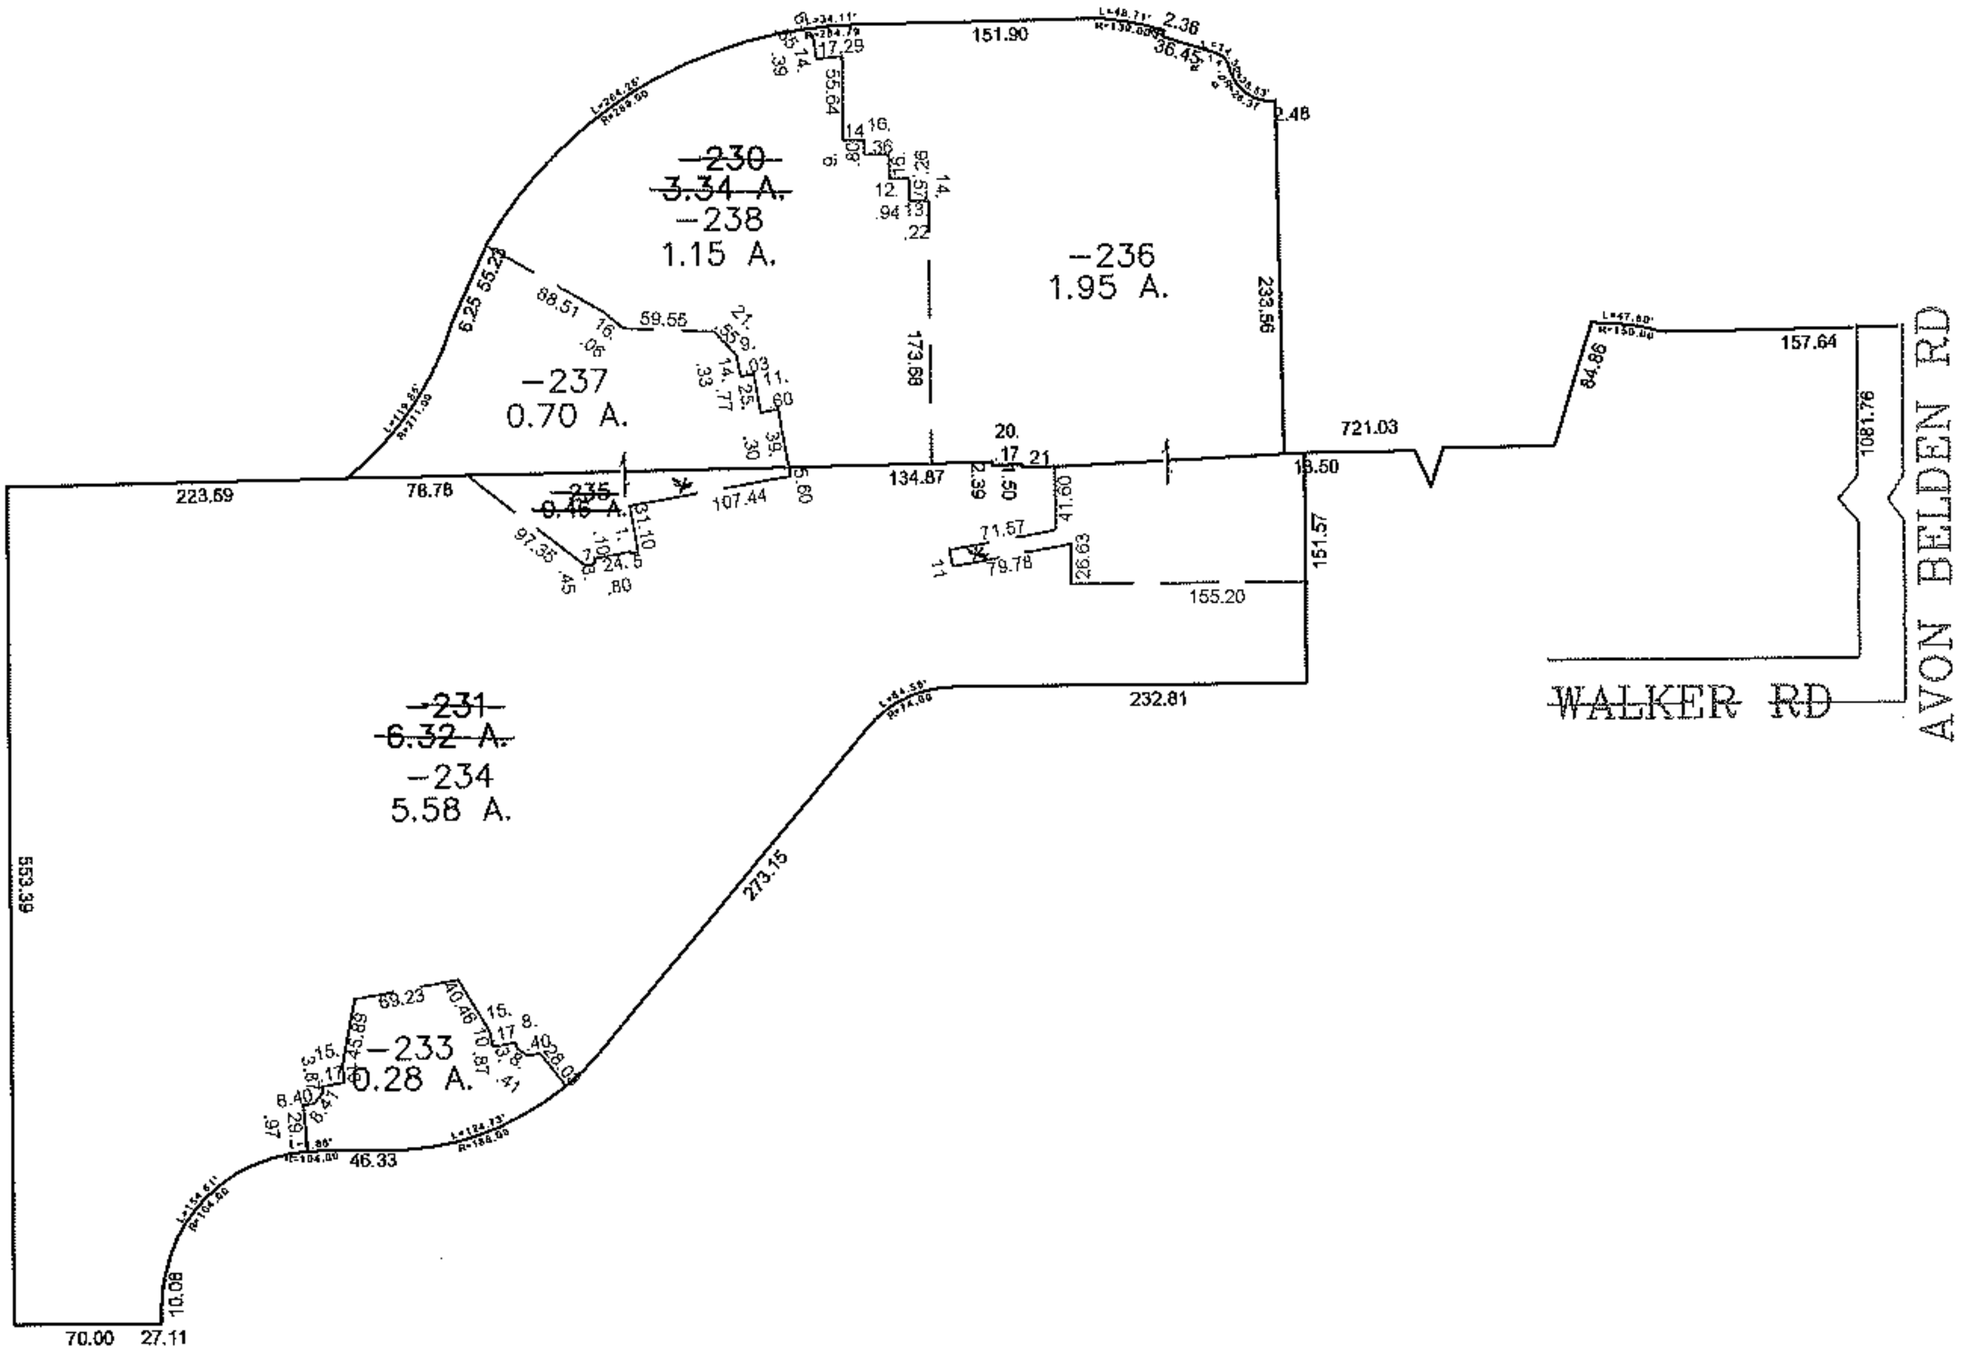

SPLITS/DEEDS PROCESSED

LORAIN COUNTY TAX MAP DEPARTMENT
226 MIDDLE AVE. ELYRIA, OHIO

SURVEYED BY: MICHAEL BRAMHALL

CLOSURE: 0.00 : 10,000

MAP PAGE(S): 04-00-018-J

APPROVED BY: JAH DATE: 5-11-11

SCALE: 1"= 200 PRIOR INSTRUMENT: 20040018470