RASTER

PARENT PARCEL: 03-00-033-115-005, -024, 003, -004, 012

CHILD PARCEL: 03-00-033-115-033 THRU -041

STARTING POINT: CENTERLINE OF ABBE RD & WALKER RD

11-02927

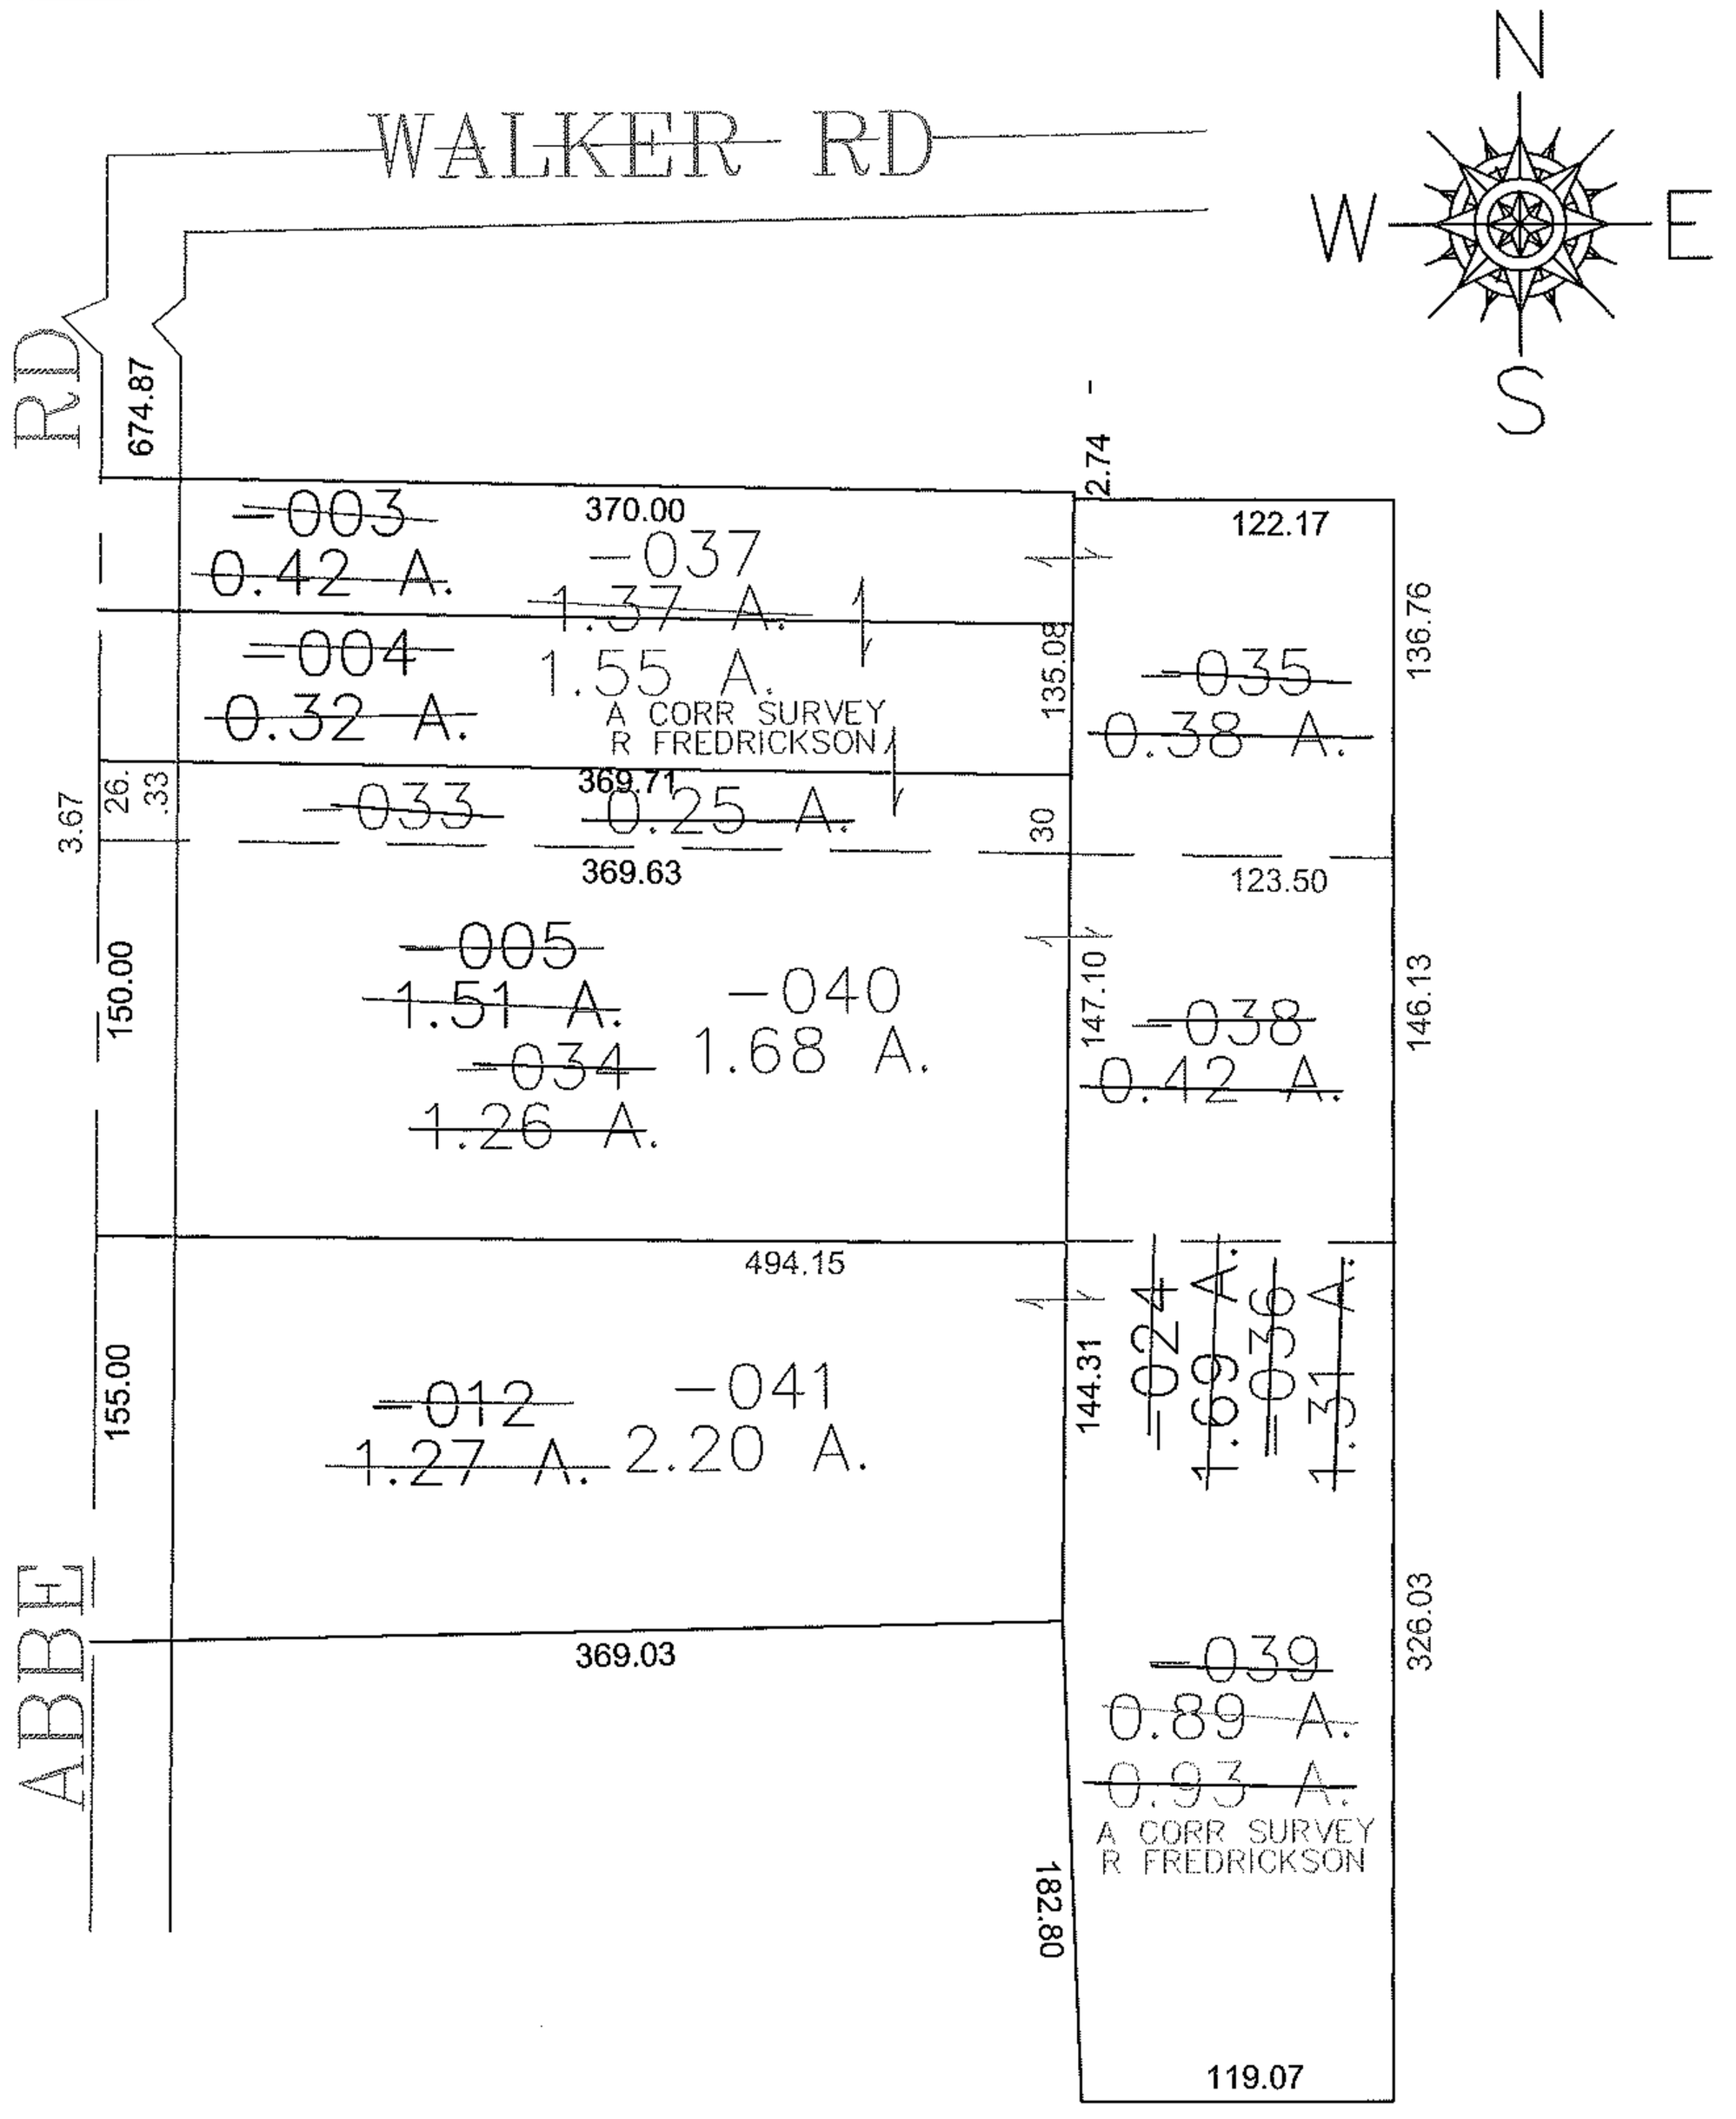

SPLITS/DEEDS PROCESSED

LORAIN COUNTY TAX MAP DEPARTMENT
226 MIDDLE AVE. ELYRIA, OHIO

SURVEYED BY: RICHARD FREDRICKSON

CLOSURE: 0.00 : 10,000

MAP PAGE(S): 03-00-033-B

APPROVED BY: JAH DATE: 6-9-2011

SCALE: 1"= 100 PRIOR INSTRUMENT: 19990607049