PARENT PARCEL: 11-00-025-000-025, -023, 11-00-024-000-020

CHILD PARCEL: 11-00-025-000-033 THRU -035 11-00-024-000-082, -083

STARTING POINT: CENTERLINE OF REED RD & CSX RR

11-02946

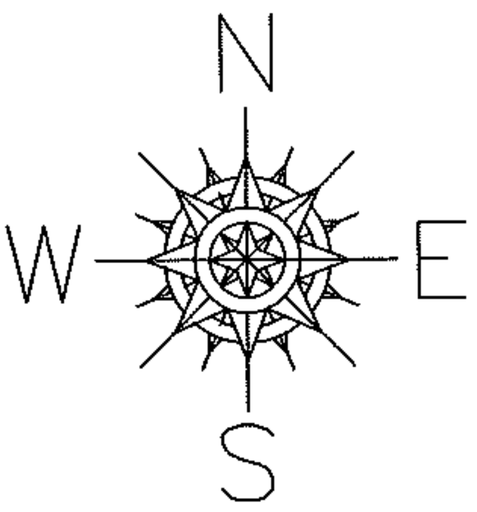

CSX R.R.

REED RD

604.35

201.44

1374.11

10

200.00

645.00

100.00

876.00

~~-025~~
~~16.60 A.~~
-034
~~11.91 A.~~
11.92 A.
A CORR SURVEY
RICHARD FREDRICKSON

201.36

-035
~~7.63 A.~~
7.64 A.
A CORR SURVEY
RICHARD FREDRICKSON
~~-033~~
~~4.69 A.~~

~~-023~~
~~2.94 A.~~

228.00

886.82

563.00

615.00

387.00

477.00

O.L. 25

O.L. 24

~~-083~~
~~0.02 A.~~
1.45 A.
A CORR SURVEY
RICHARD FREDRICKSON

~~-020~~
~~1.60 A.~~

-082
1.58 A.

425.17

460.77

SPLITS/DEEDS PROCESSED

LORAIN COUNTY TAX MAP DEPARTMENT
226 MIDDLE AVE. ELYRIA, OHIO

SURVEYED BY: RICHARD FREDRICKSON

CLOSURE: 0.00 : 10,000

MAP PAGE(S): 11-00-025-A

APPROVED BY: JAH DATE: 9-12-2011

SCALE: 1"= 200 PRIOR INSTRUMENT: 20070199906