PARENT PARCEL: 04-00-020-102-040

CHILD PARCEL: 04-00-020-102-050 THRU -053

TING POINT: MON. BOX, CL OF WALKER RD. & CL OF JACOX RD.

11-02949

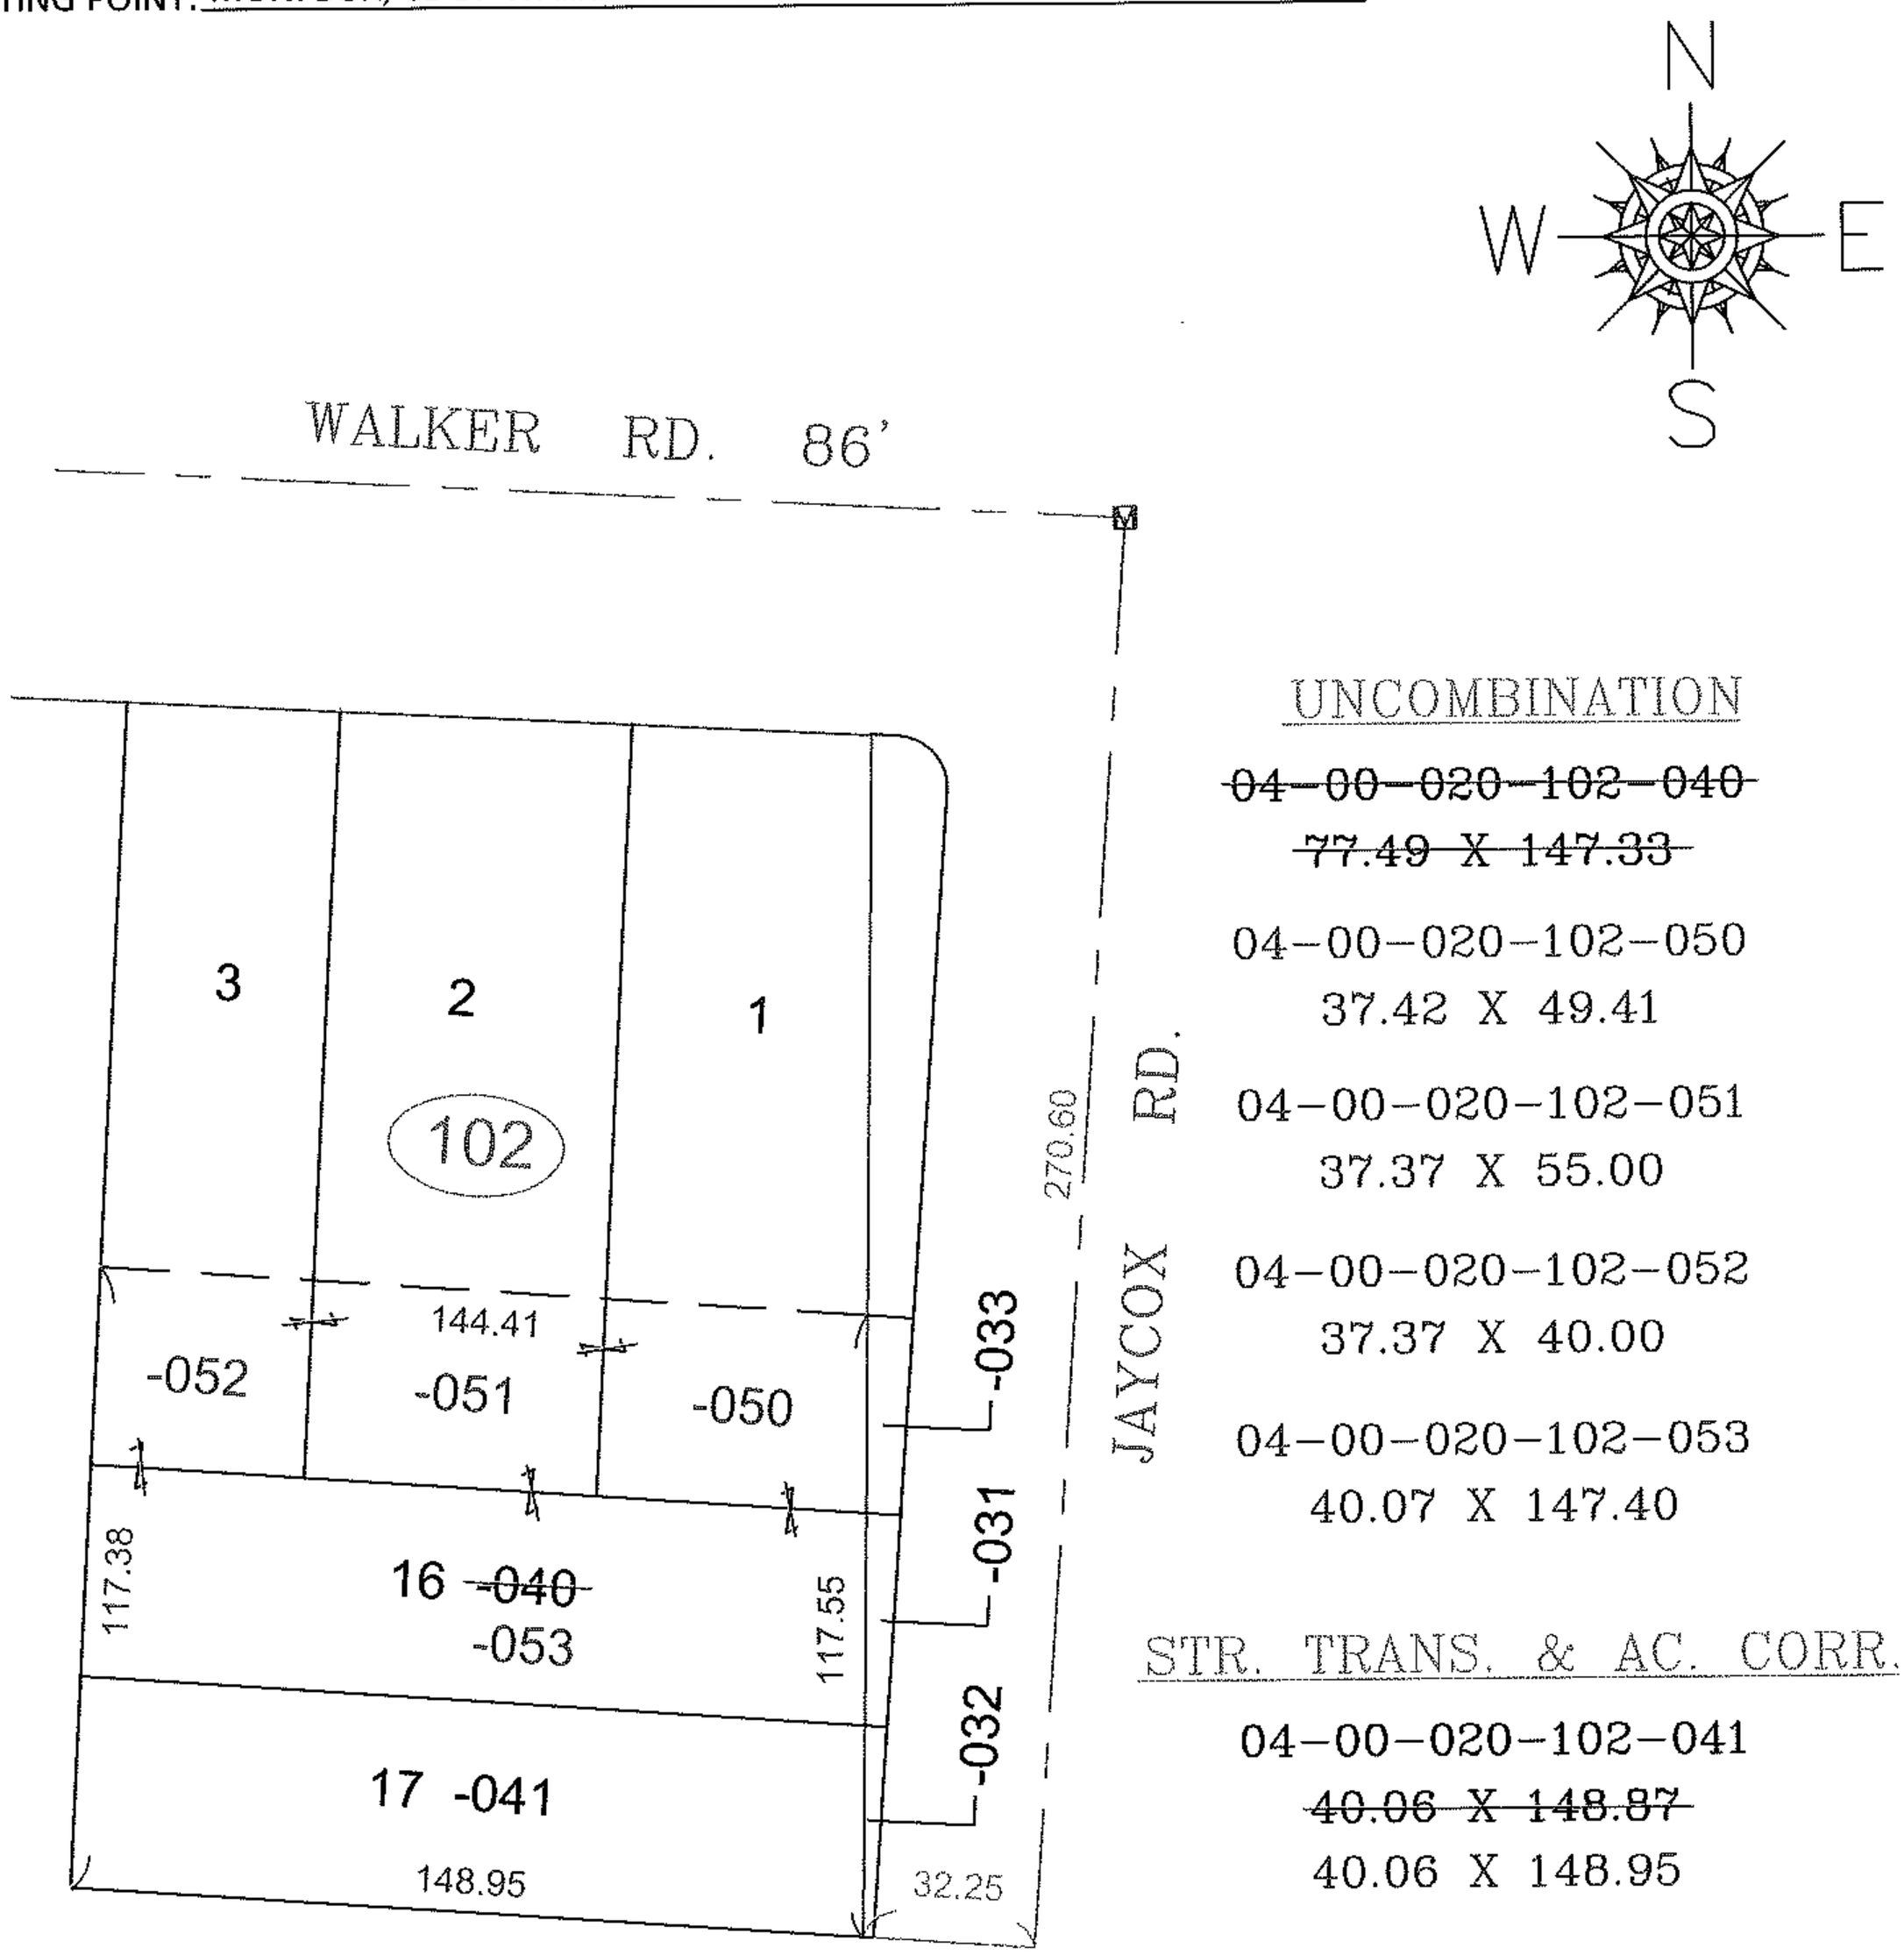

SPLITS/DEEDS PROCESSED

LORAIN COUNTY TAX MAP DEPARTMENT
226 MIDDLE AVE. ELYRIA, OHIO

SURVEYED BY: DALE R. HAYWOOD

CLOSURE: 0.01 : 10,000

MAP PAGE(S): 4-00-020-B

APPROVED BY: TJS DATE: 9/27/11

SCALE: 1"= 50' PRIOR INST.: 20110372726