

PARENT PARCEL: 11-00-056-000-001

CHILD PARCEL: \_\_\_\_\_

STARTING POINT: NORTHWEST CORNER OF O.L.56

14-02971-A

ELYRIA - TWINSBURG RD. (S.R. 82)

618.10

11.10

3506.00

-001  
~~48.42 A.~~  
48.85 A.

AC. CORR. PER. PRIOR DEEDS

3187.90



O.L.65

O.L.56

607.00

O.L.64

O.L.57

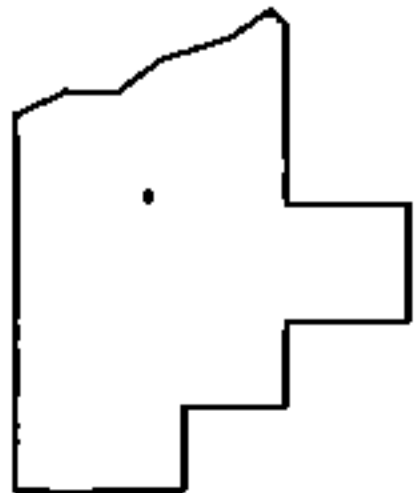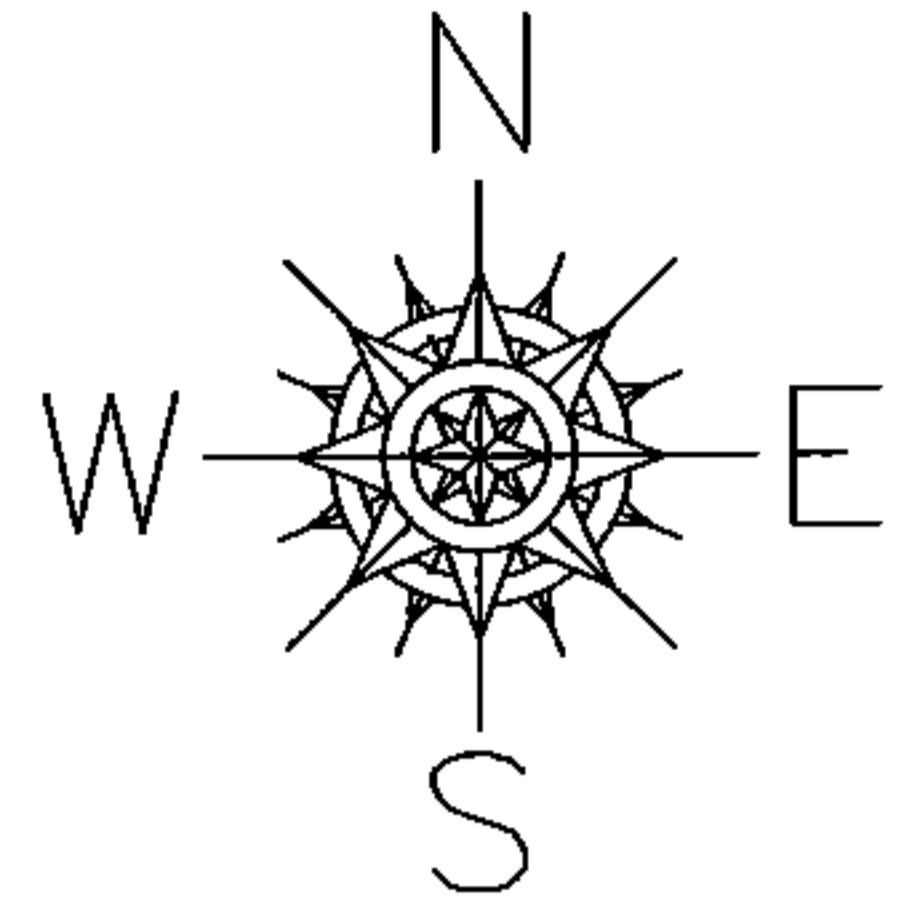

**SPLITS/DEEDS PROCESSED**

LORAIN COUNTY TAX MAP DEPARTMENT  
226 MIDDLE AVE. ELYRIA, OHIO

SURVEYED BY: N/A

CLOSURE: N/A

MAP PAGE(S): 11-F NORTH

APPROVED BY: RRM DATE: 6-26-14

SCALE: 1" = 500 PRIOR INST.: DV 1102/760