RASTER

PARENT PARCEL: 04-00-025-000-016 & 04-00-025-000-353

CHILD PARCEL: 04-00-025-000-528 THRU -533

STARTING POINT: I.P. MON. BOX, 60' EAST OF CL OF AUGUSTA WAY & CL OF NAGEL RD.

11-02972

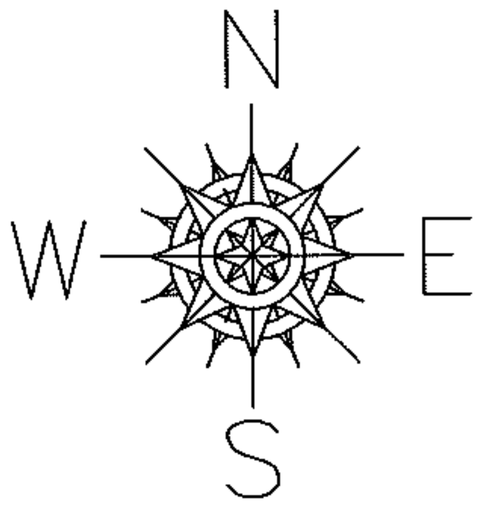

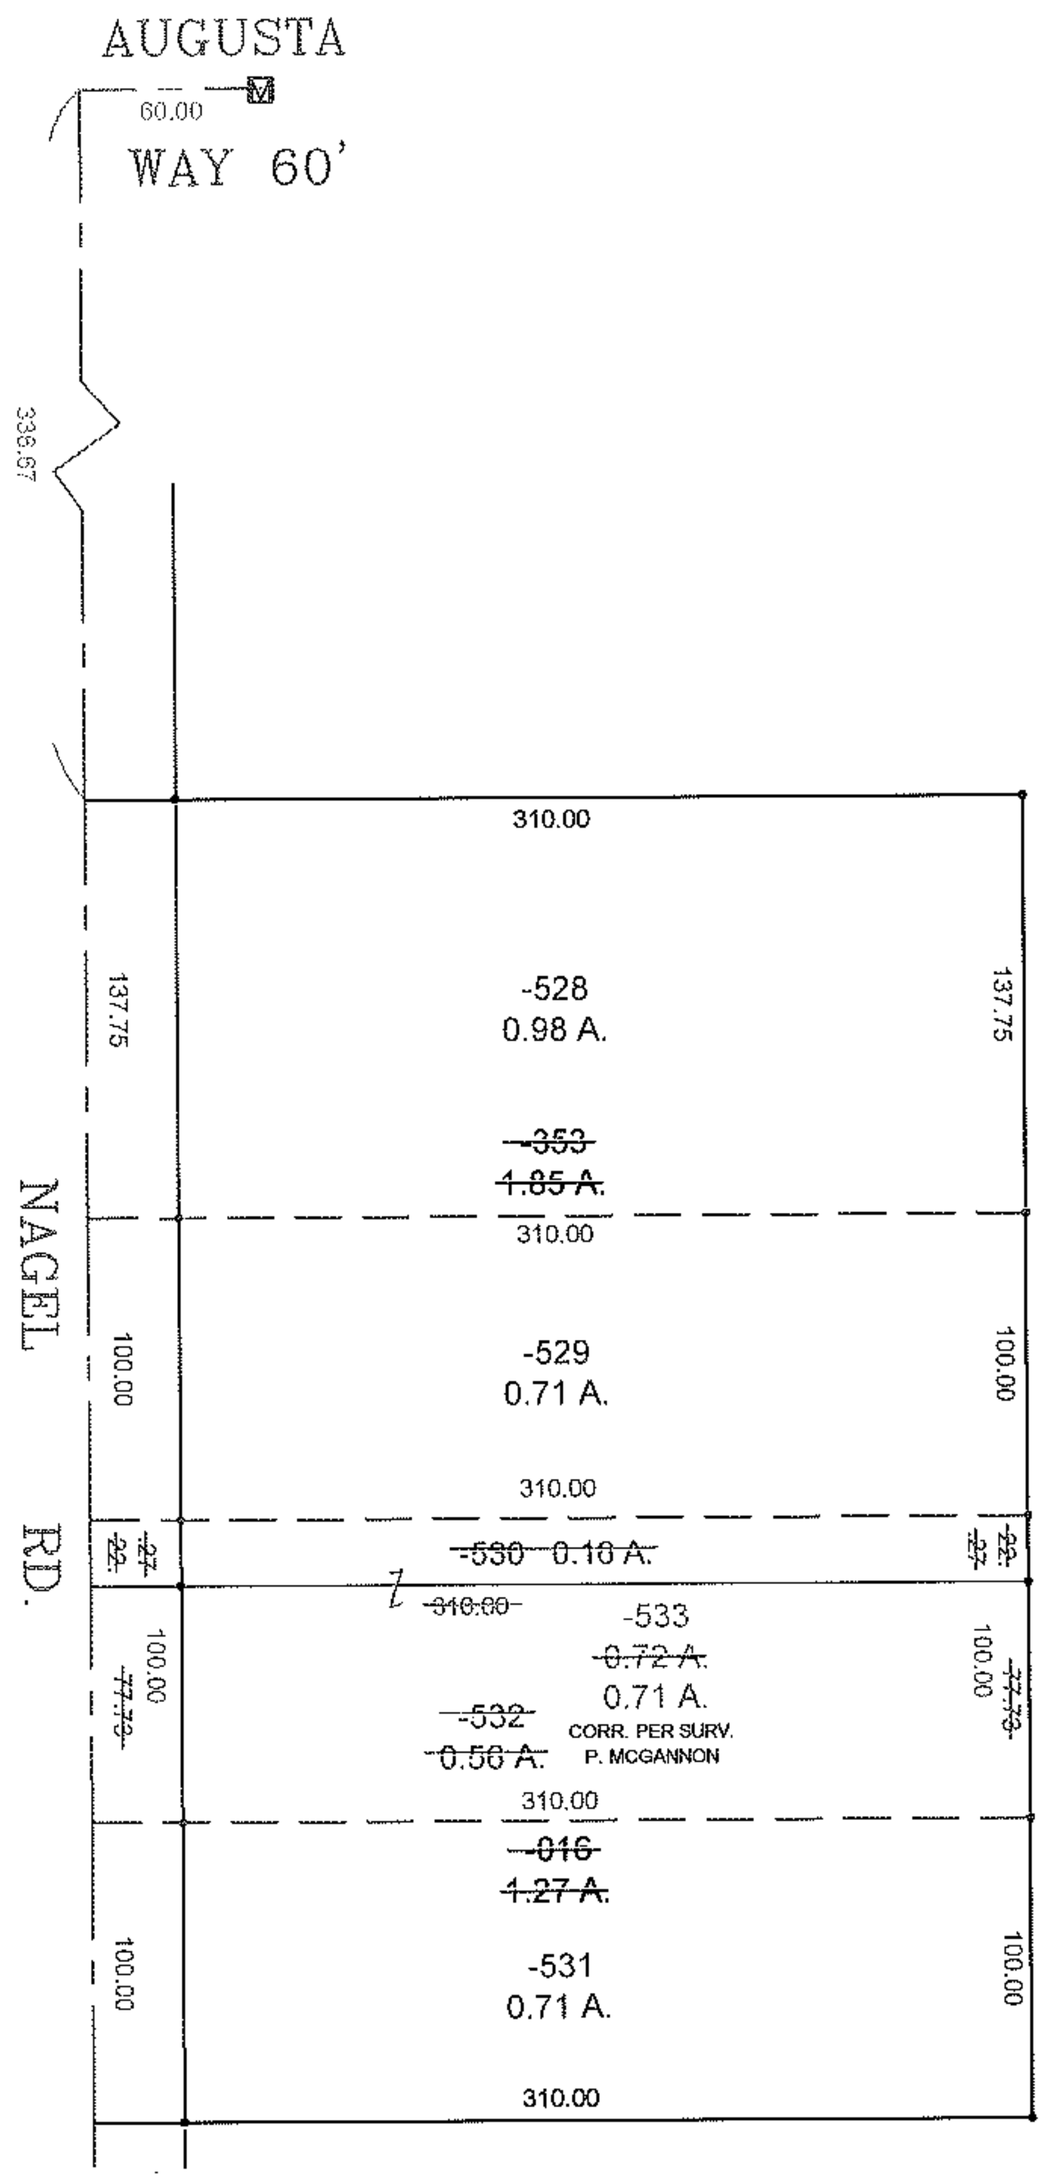

PRIOR INST.: 20110364720

PRIOR INST.: 20110374404

SPLITS/DEEDS PROCESSED

LORAIN COUNTY TAX MAP DEPARTMENT
226 MIDDLE AVE. ELYRIA, OHIO

SURVEYED BY: PATRICK A. MCGANNON

CLOSURE: 0.00 : 10,000

MAP PAGE(S): 04-00-025-A

APPROVED BY: TJS DATE: 11/29/11

SCALE: 1"= 100 PRIOR INST.: 20110364720