PARENT PARCEL: 08-13-010-000-004 & -012

CHILD PARCEL: XX-XX-XXX-XXX-XXX

STARTING POINT: XXXXXX

14-02974-C

N

W E

S

ACREAGE CORRECTION

08-13-010-000-004

~~2.23 A.~~

1.79 A. CALC.

CORR. PER DEED

INST. # 20070194297

ACREAGE CORRECTION

08-13-010-000-012

~~30.95 A.~~

31.39 A. CALC.

CORR. PER DEED

INST. # 20070194297

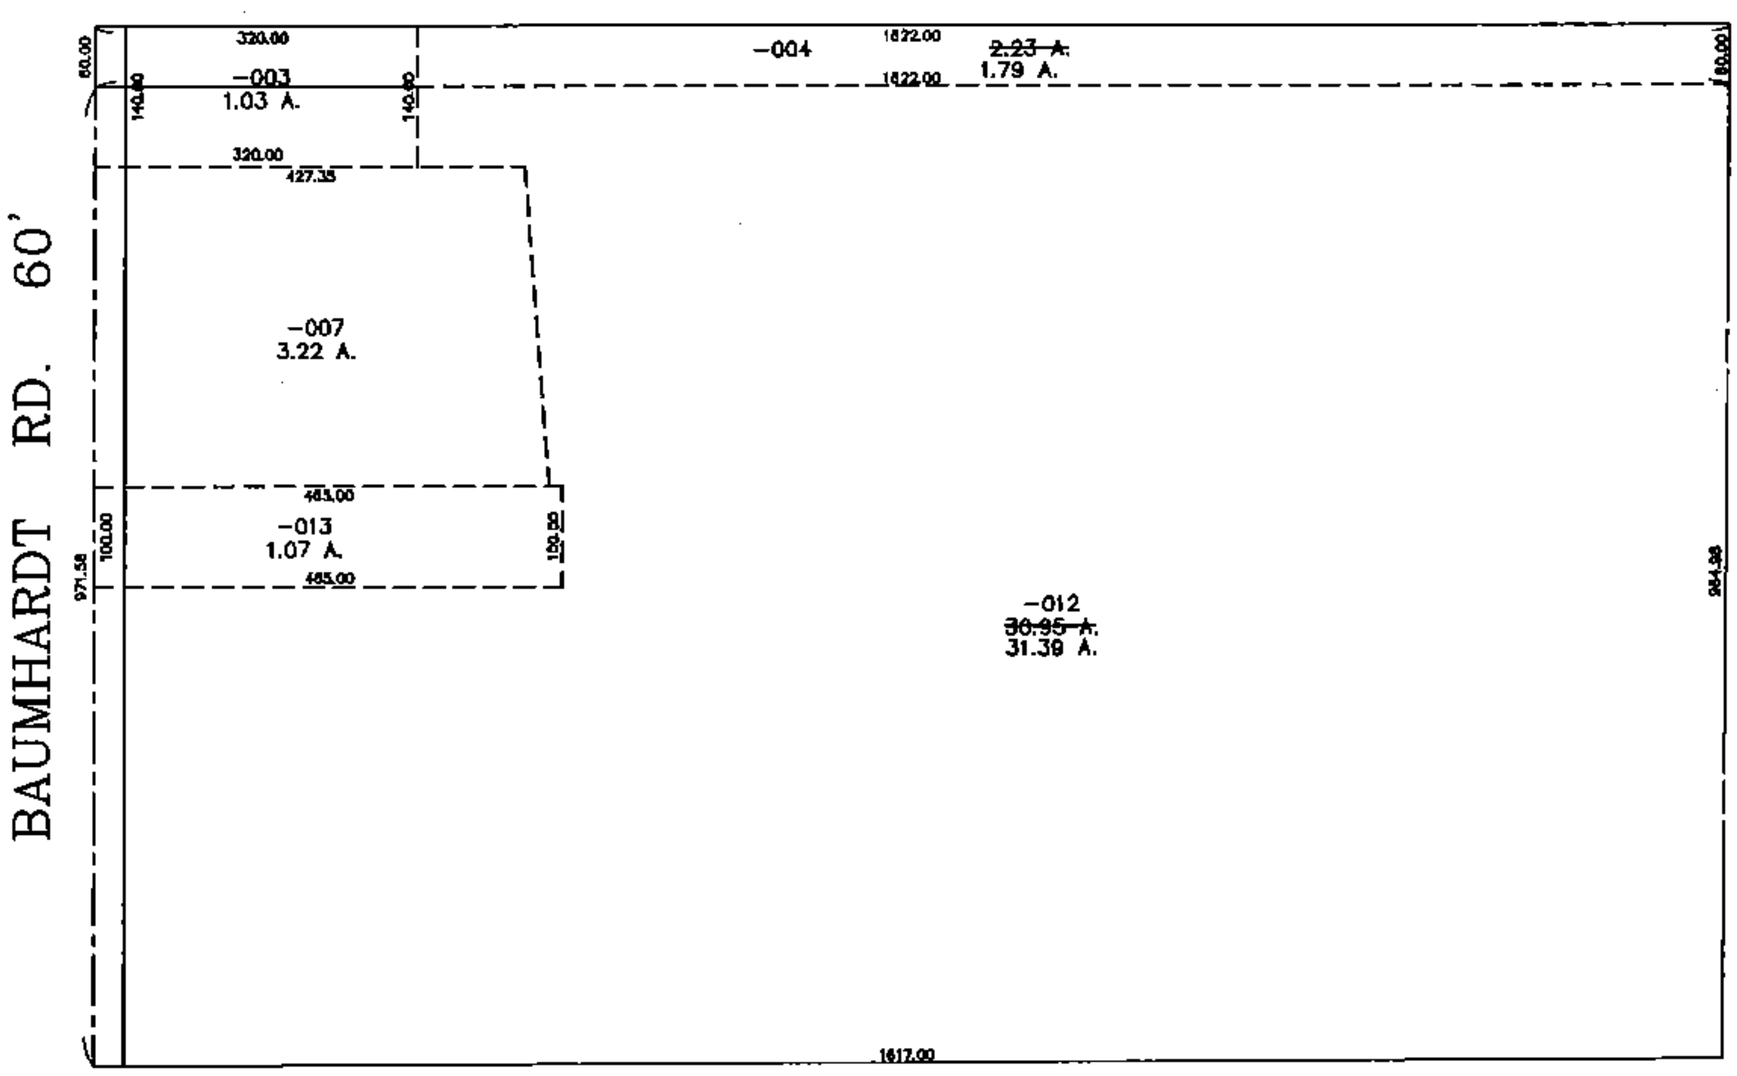

SPLITS/DEEDS PROCESSED

LORAIN COUNTY TAX MAP DEPARTMENT
226 MIDDLE AVE. ELYRIA, OHIO

SURVEYED BY: NA

CLOSURE: NA

MAP PAGE(S): 08-13-010

APPROVED BY: TJS DATE: 6/27/14

SCALE: 1"= 300 PRIOR INSTRUMENT: 20070194297