PARENT PARCEL: 03-00-040-119-050

CHILD PARCEL: 03-00-040-119-066, -067

STARTING POINT: SIDELINE OF DUNNY AVE. & FERNDALE AVE.

NO. 00028

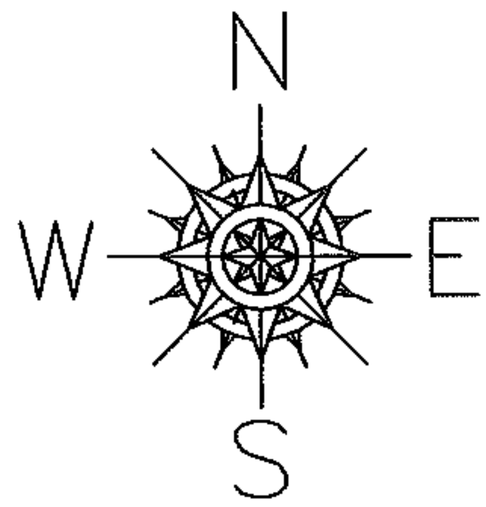

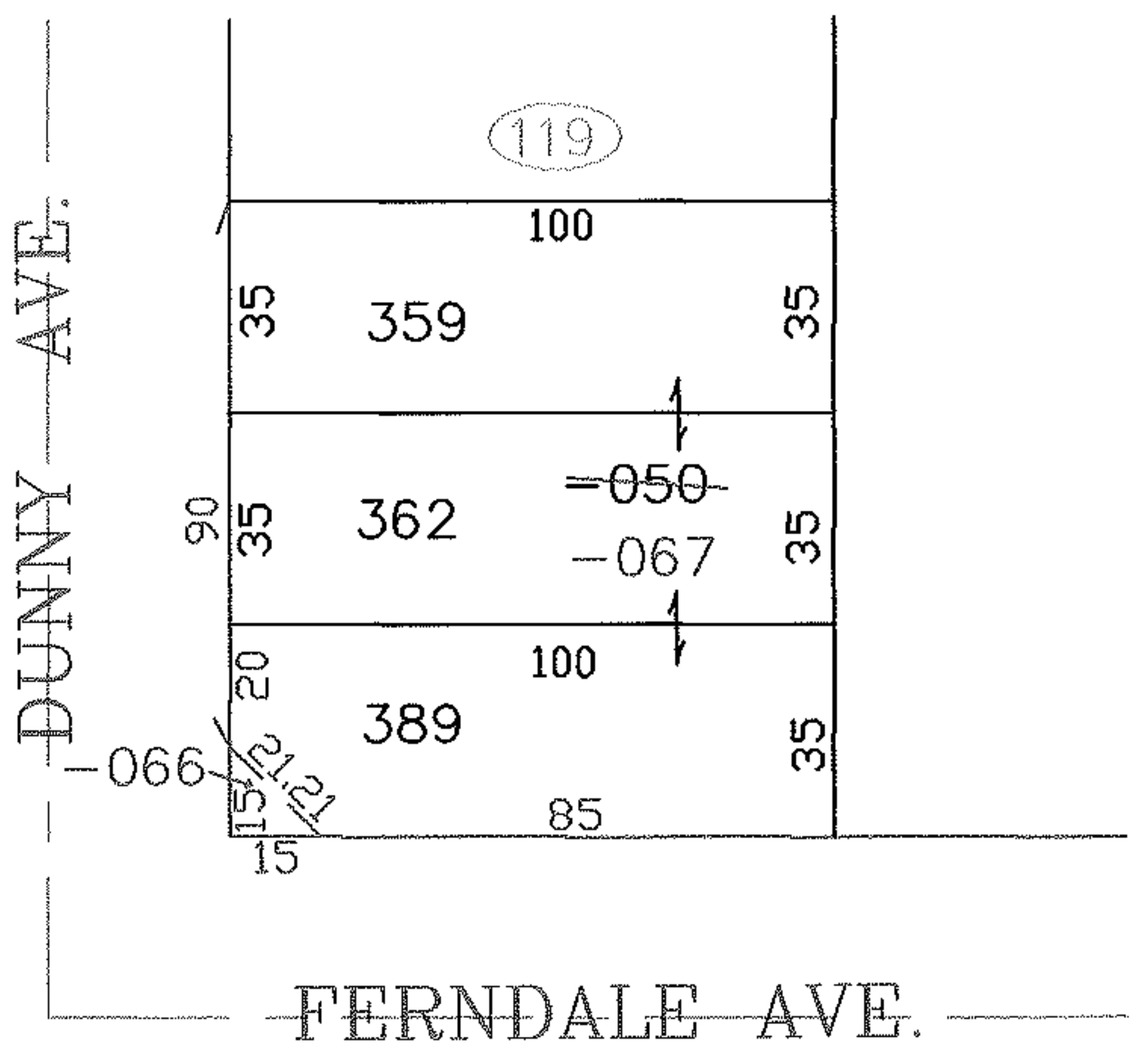

SPLITS/DEEDS PROCESSED

LORAIN COUNTY TAX MAP DEPARTMENT
226 MIDDLE AVE. ELYRIA, OHIO

SURVEYED BY: ROBERT J. MCAULEY

CLOSURE: 0.00 : 10,000

MAP PAGE(S): 3-00-040

APPROVED BY: JAH DATE: 1-31-03

SCALE: 1"= 50' PRIOR INSTRUMENT: 20000717909