PARENT PARCEL: 21-05-017-000-001, -006

CHILD PARCEL: 21-05-017-000-011, -012, -013, -014, -015

STARTING POINT: SW CORNER O.L. 17

NO. 00067

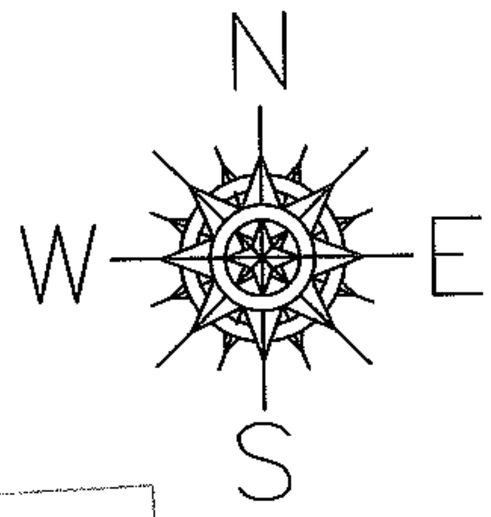

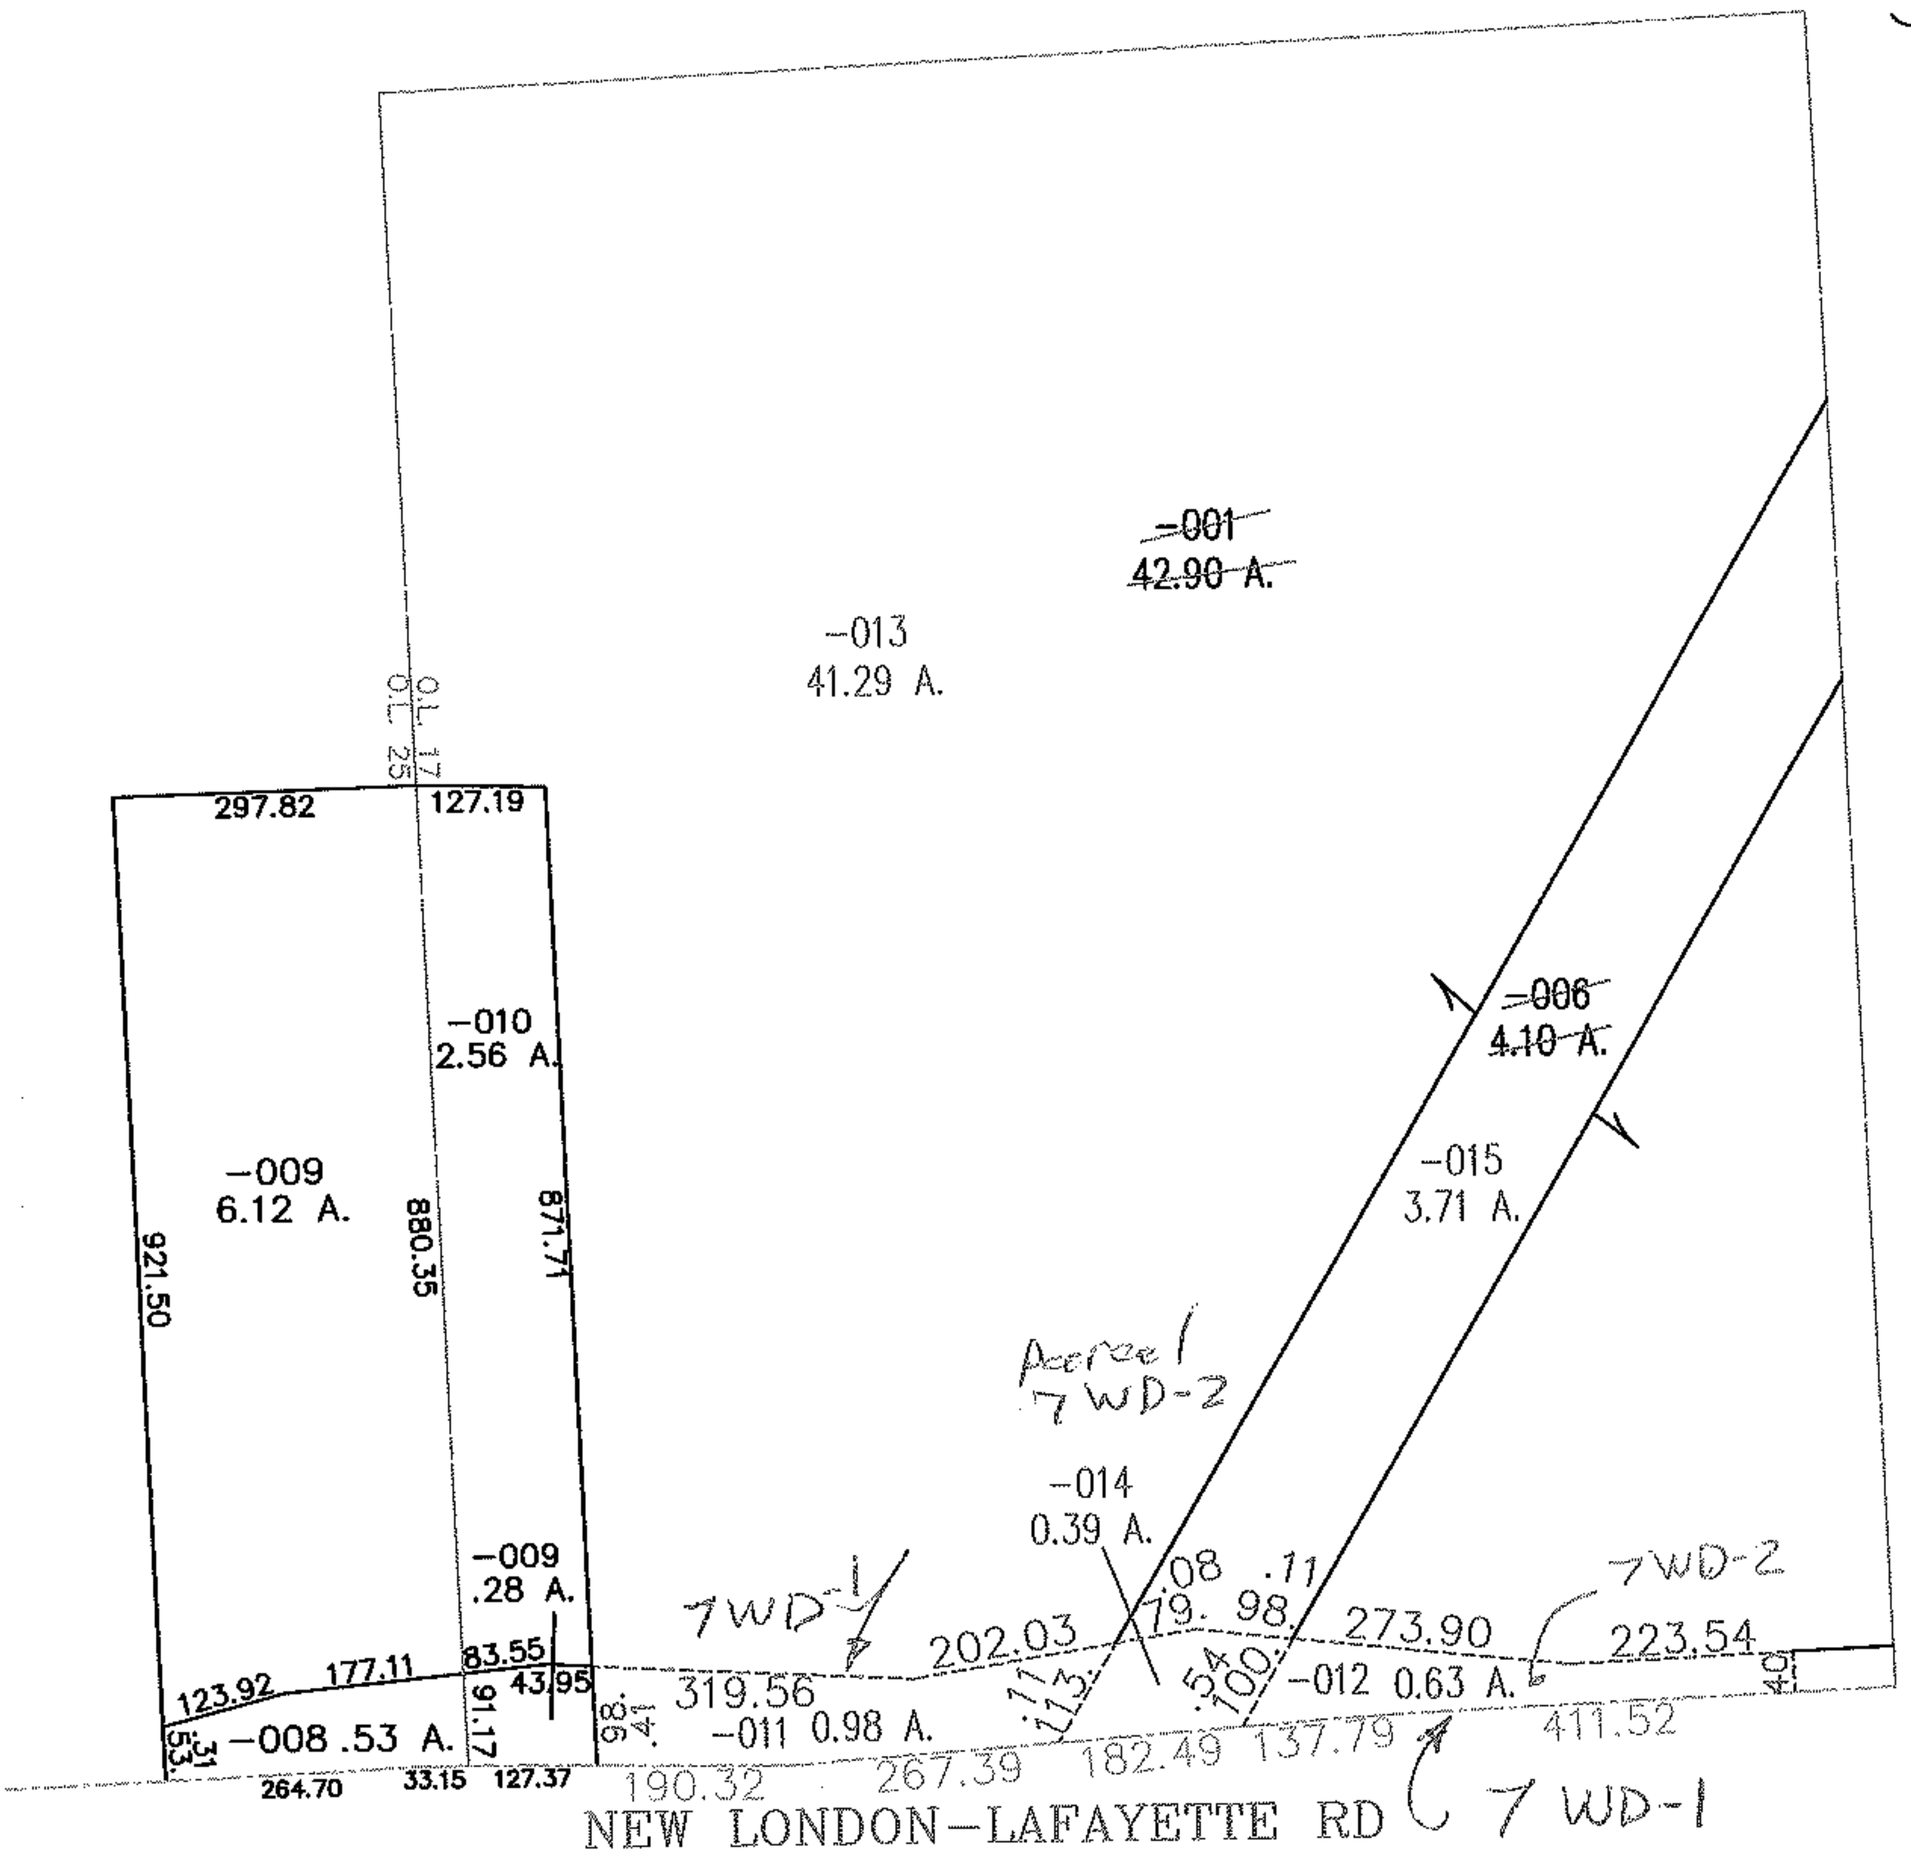

SPLITS/DEEDS PROCESSED

LORAIN COUNTY TAX MAP DEPARTMENT
226 MIDDLE AVE. ELYRIA, OHIO

SURVEYED BY: PHIL Y. SMITH

CLOSURE: 0:00

MAP PAGE(S): 21-A

APPROVED BY: DRH DATE: 3/11/2003

SCALE: 1"= 300 PRIOR INSTRUMENT: 980522516