PARENT PARCEL: 21-04-000-000-009,-011

CHILD PARCEL: 21-04-000-000-050 THRU -054

STARTING POINT: SOUTHWEST CORNER OF O.L. 17

NO. 00075

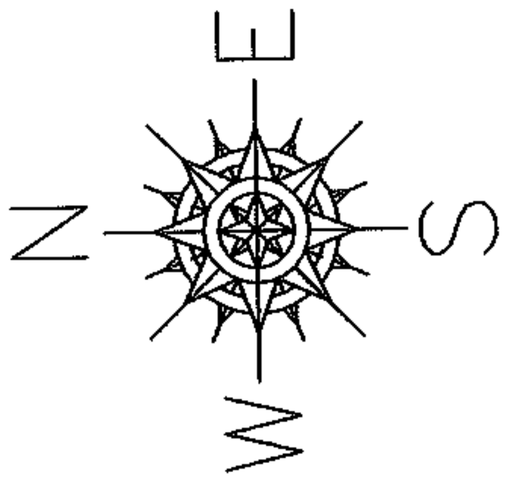

~~-011~~
~~51.00 A.~~

-054
50.48 A.

RD.

-053
0.52 A.

-051
0.42 A.

-052
43.59 A.

NEW LONDON-LAFAYETTE

-050
1.07 A.

~~-009~~
~~45.08 A.~~

TRACK 5

TRACK 4

O.L. 17

O.L. 25

SPLITS/DEEDS PROCESSED

LORAIN COUNTY TAX MAP DEPARTMENT
226 MIDDLE AVE. ELYRIA, OHIO

SURVEYED BY: PHIL Y. SHIH

CLOSURE: .02:10,000

MAP PAGE(S): 21-E

APPROVED BY: RRM DATE: 11-13-03

SCALE: 1"= 200 PRIOR INSTRUMENT: 980512677