RASTER

PARENT PARCEL: 03-00-011-102-119

CHILD PARCEL:

STARTING POINT: INT C.L. ABBE RD AND SOUTHERLY LINE OF O.L. 11

NO. 00809-C

MAP CORR. ONLY

PARCEL-116 SHOULD B 42.73FT OFF SIDELINE

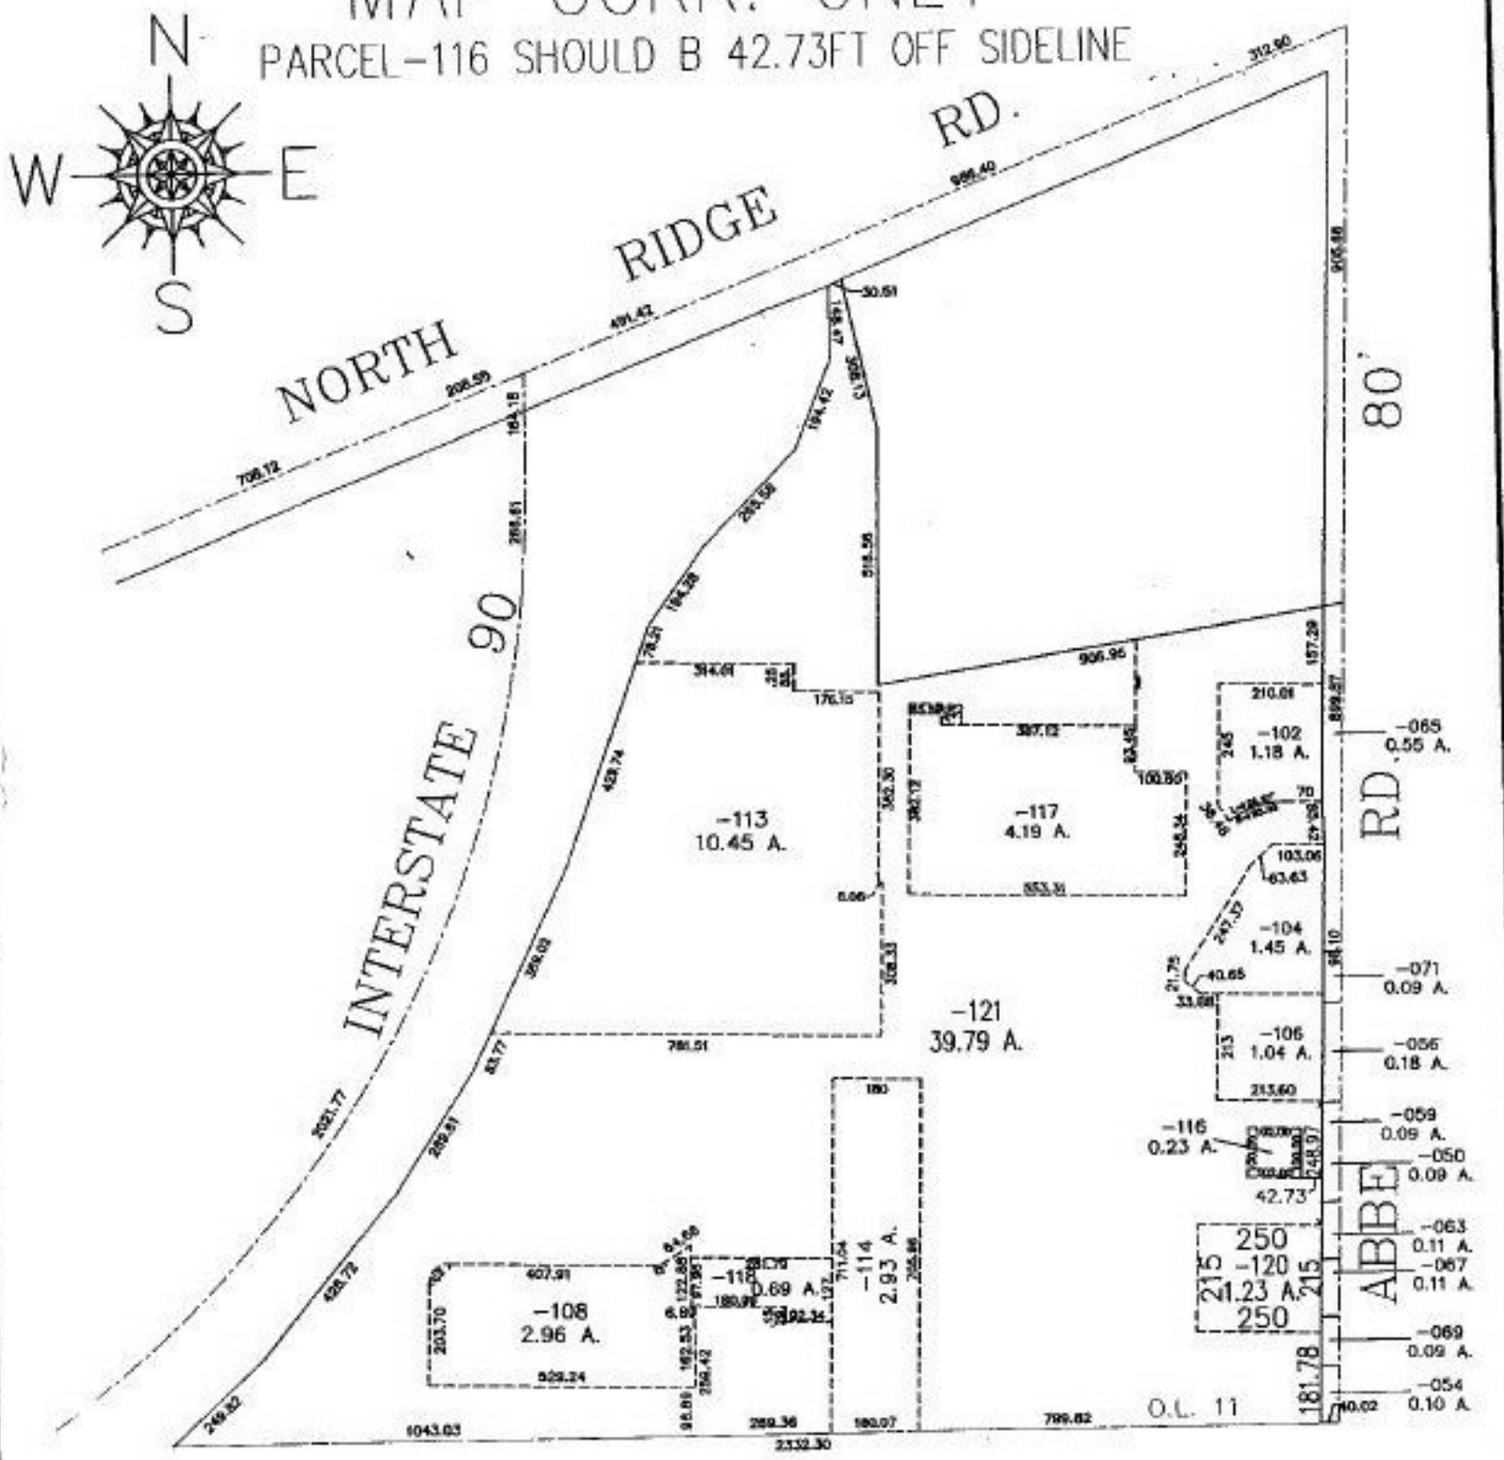

SPLITS/DEEDS PROCESSED

LORAIN COUNTY TAX MAP DEPARTMENT
226 MIDDLE AVE. ELYRIA, OHIO

SURVEYED BY: STUART W. SAYLER

CLOSURE: 0.00/10,000

MAP PAGE(S): 03-00-011-A

APPROVED BY: RBM DATE: 2/5/03

SCALE: 1"= 400 PRIOR INSTRUMENT: 20010760042