PARENT PARCEL: 04-00-003-101-080, 04-00-002-101-002, -012, 03-00-004-000-047

PARENT PARCEL: 03-00-014-000-037

CHILD PARCEL: SAME

STARTING POINT: MULTIPLE

NO. 00858-A

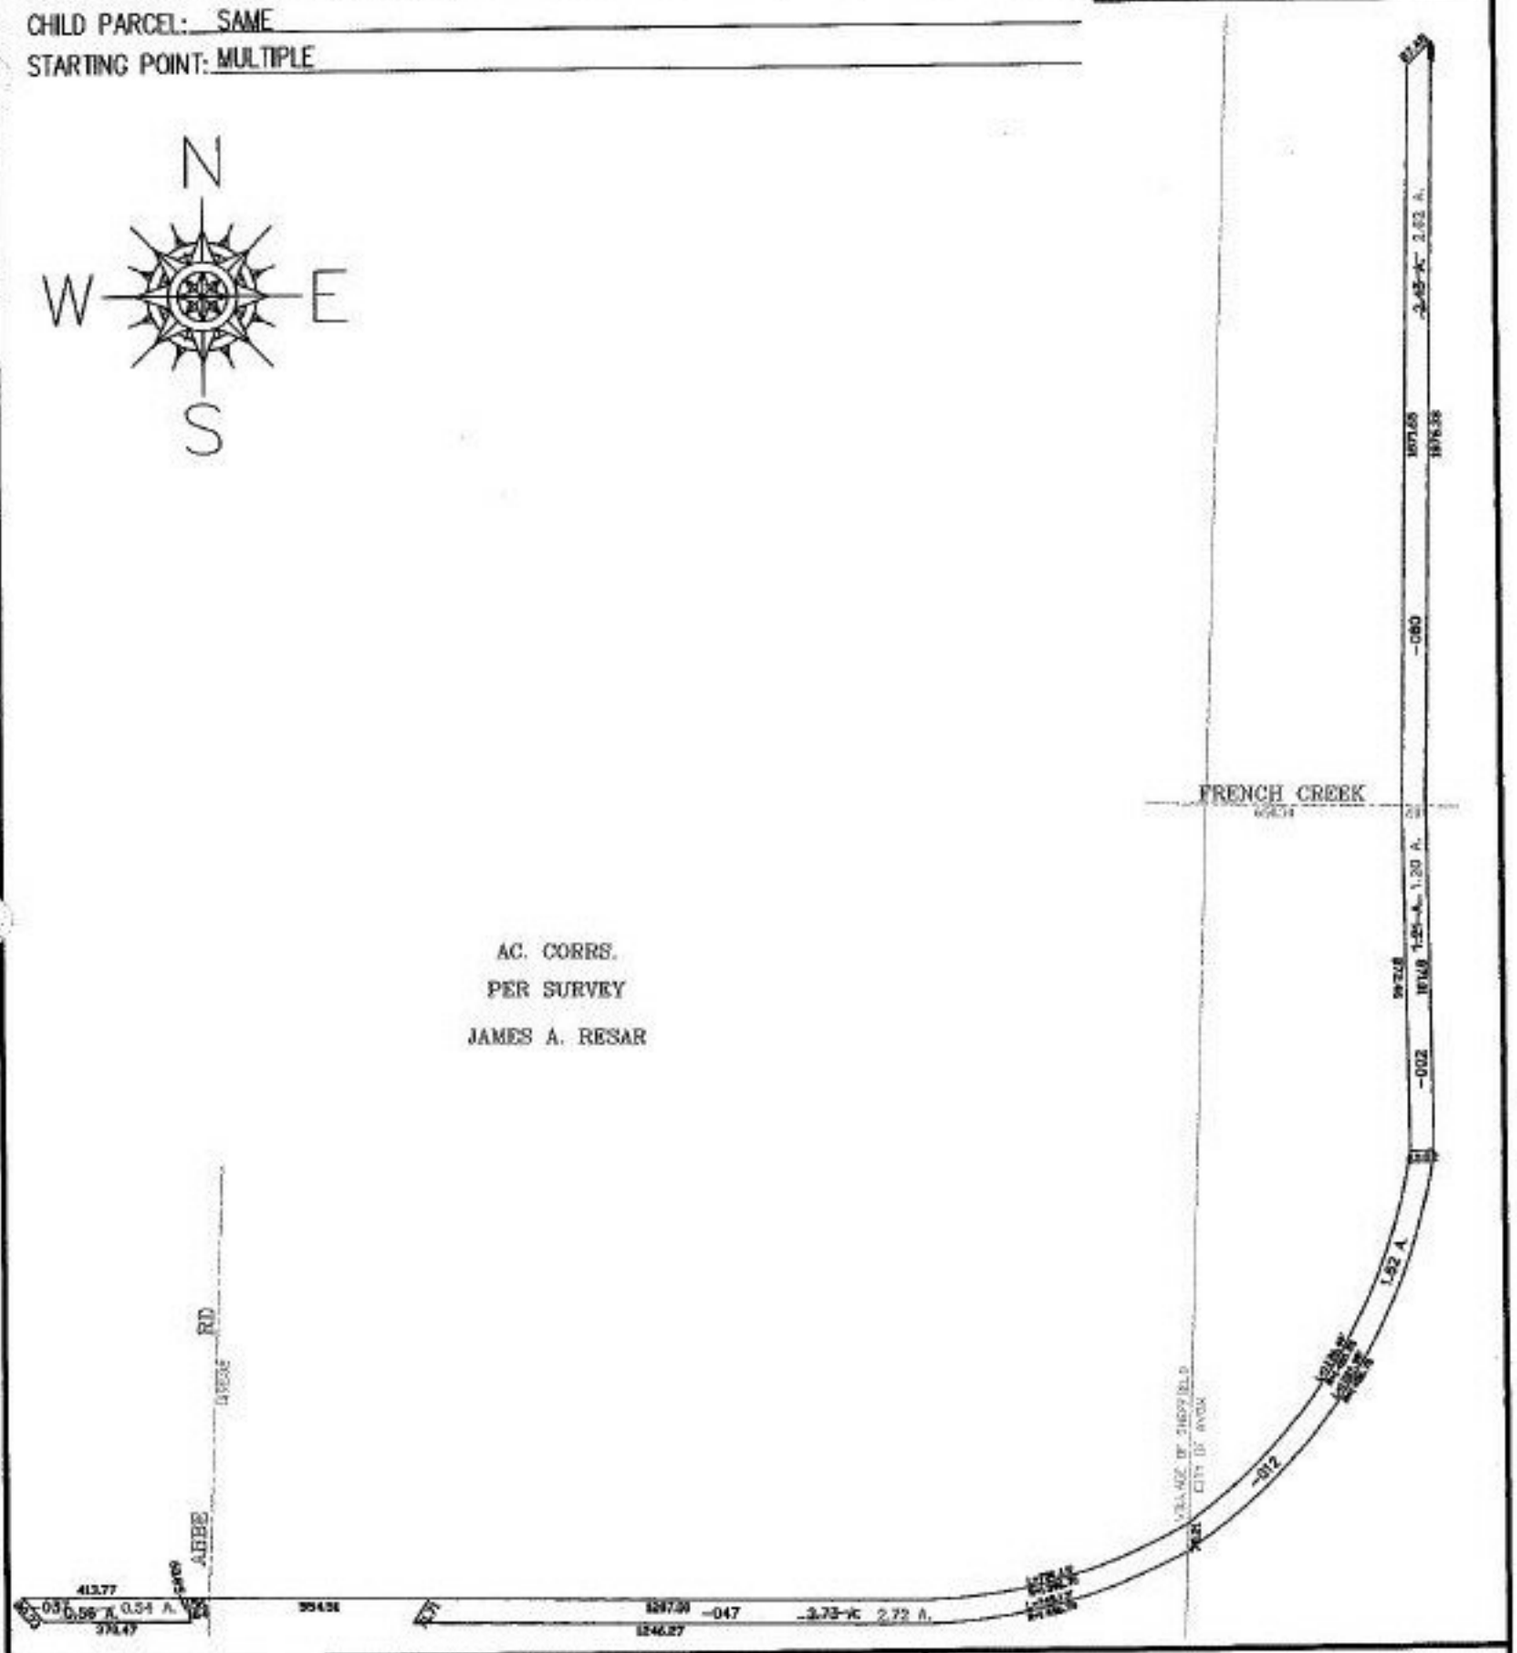

SPLITS/DEEDS PROCESSED

LORAIN COUNTY TAX MAP DEPARTMENT
226 MIDDLE AVE. ELYRIA, OHIO

SURVEYED BY: JAMES A. RESAR

CLOSURE: 0.00 MAP PAGE(S): 3-4,

04-00-003-E, -002-A, 03-00-004-A, -014-B

APPROVED BY: DRH DATE: 5/19/03

SCALE: 1" = 500 PRIOR INSTRUMENT:

04-00-003-101-080