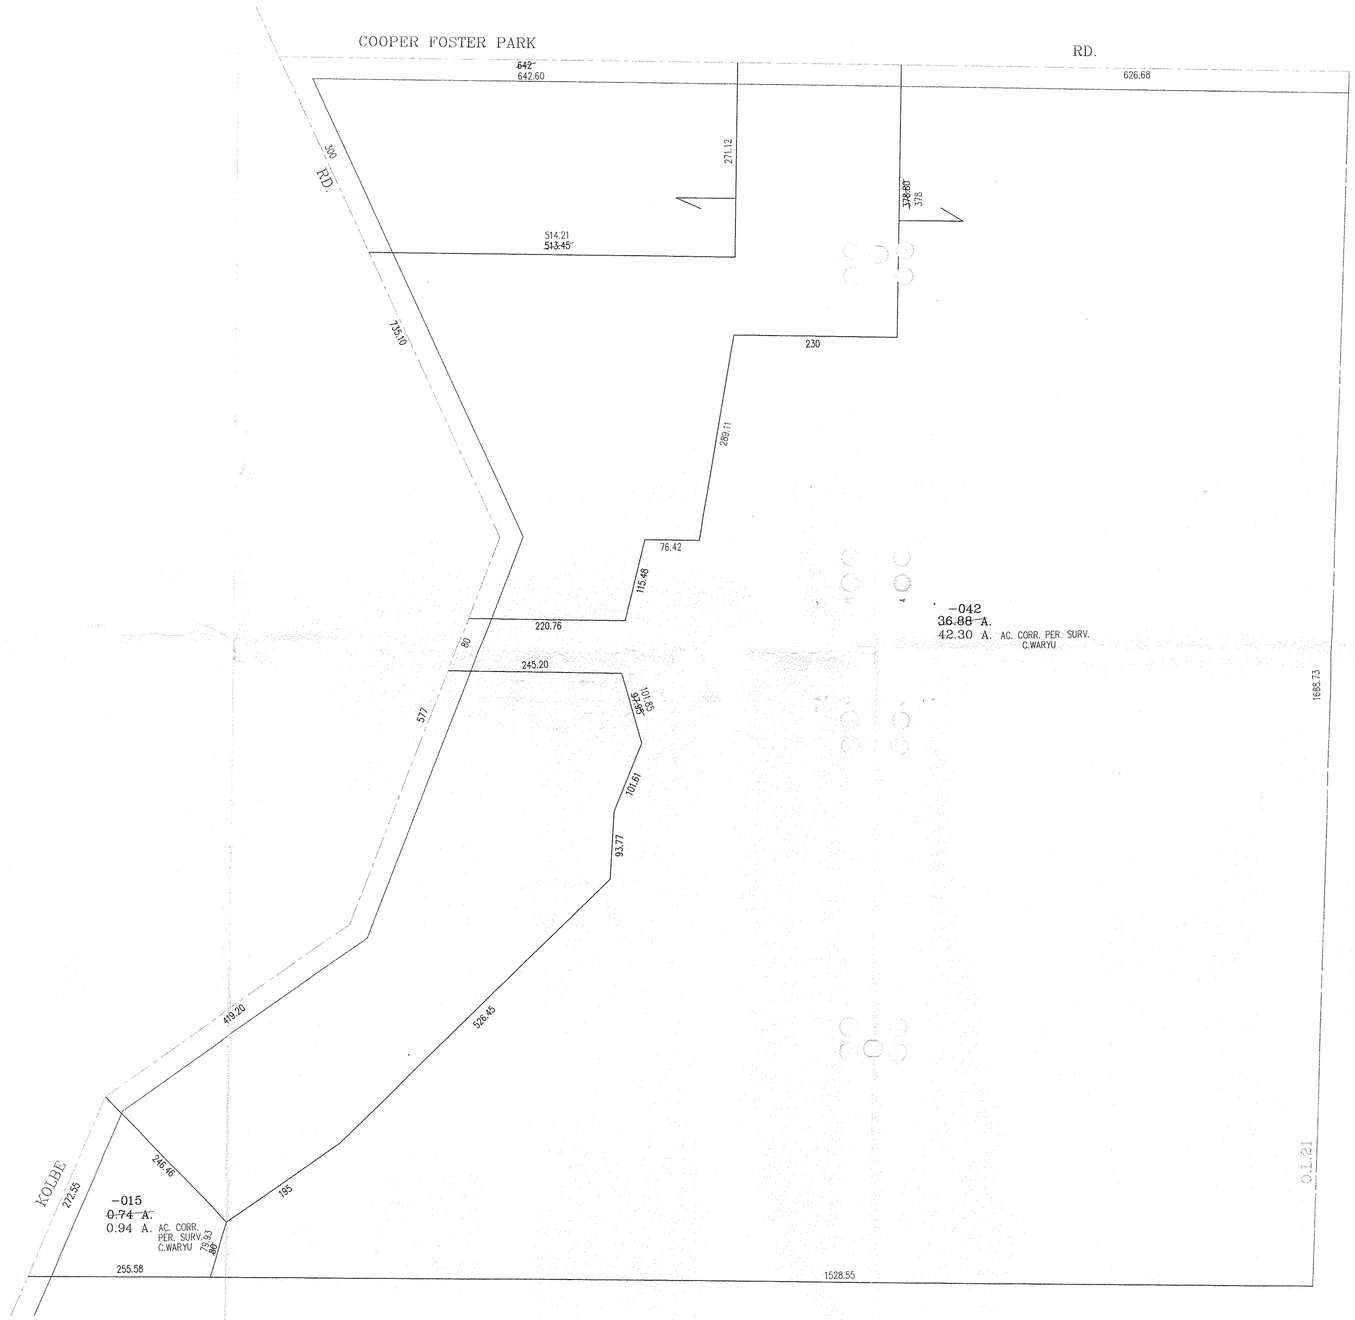

№ 00886-A
APPROVED
LORAIN CO.
MAP DEPT.
DATE 11-13-03
PAGE 05-00-021-B
BY R. MAINES
03-00886-A

#03-00886-A