#01300

S

~~03-00-088-101-017~~
~~537.15 A.~~

~~03-00-088-101-018~~
~~497.53 A.~~
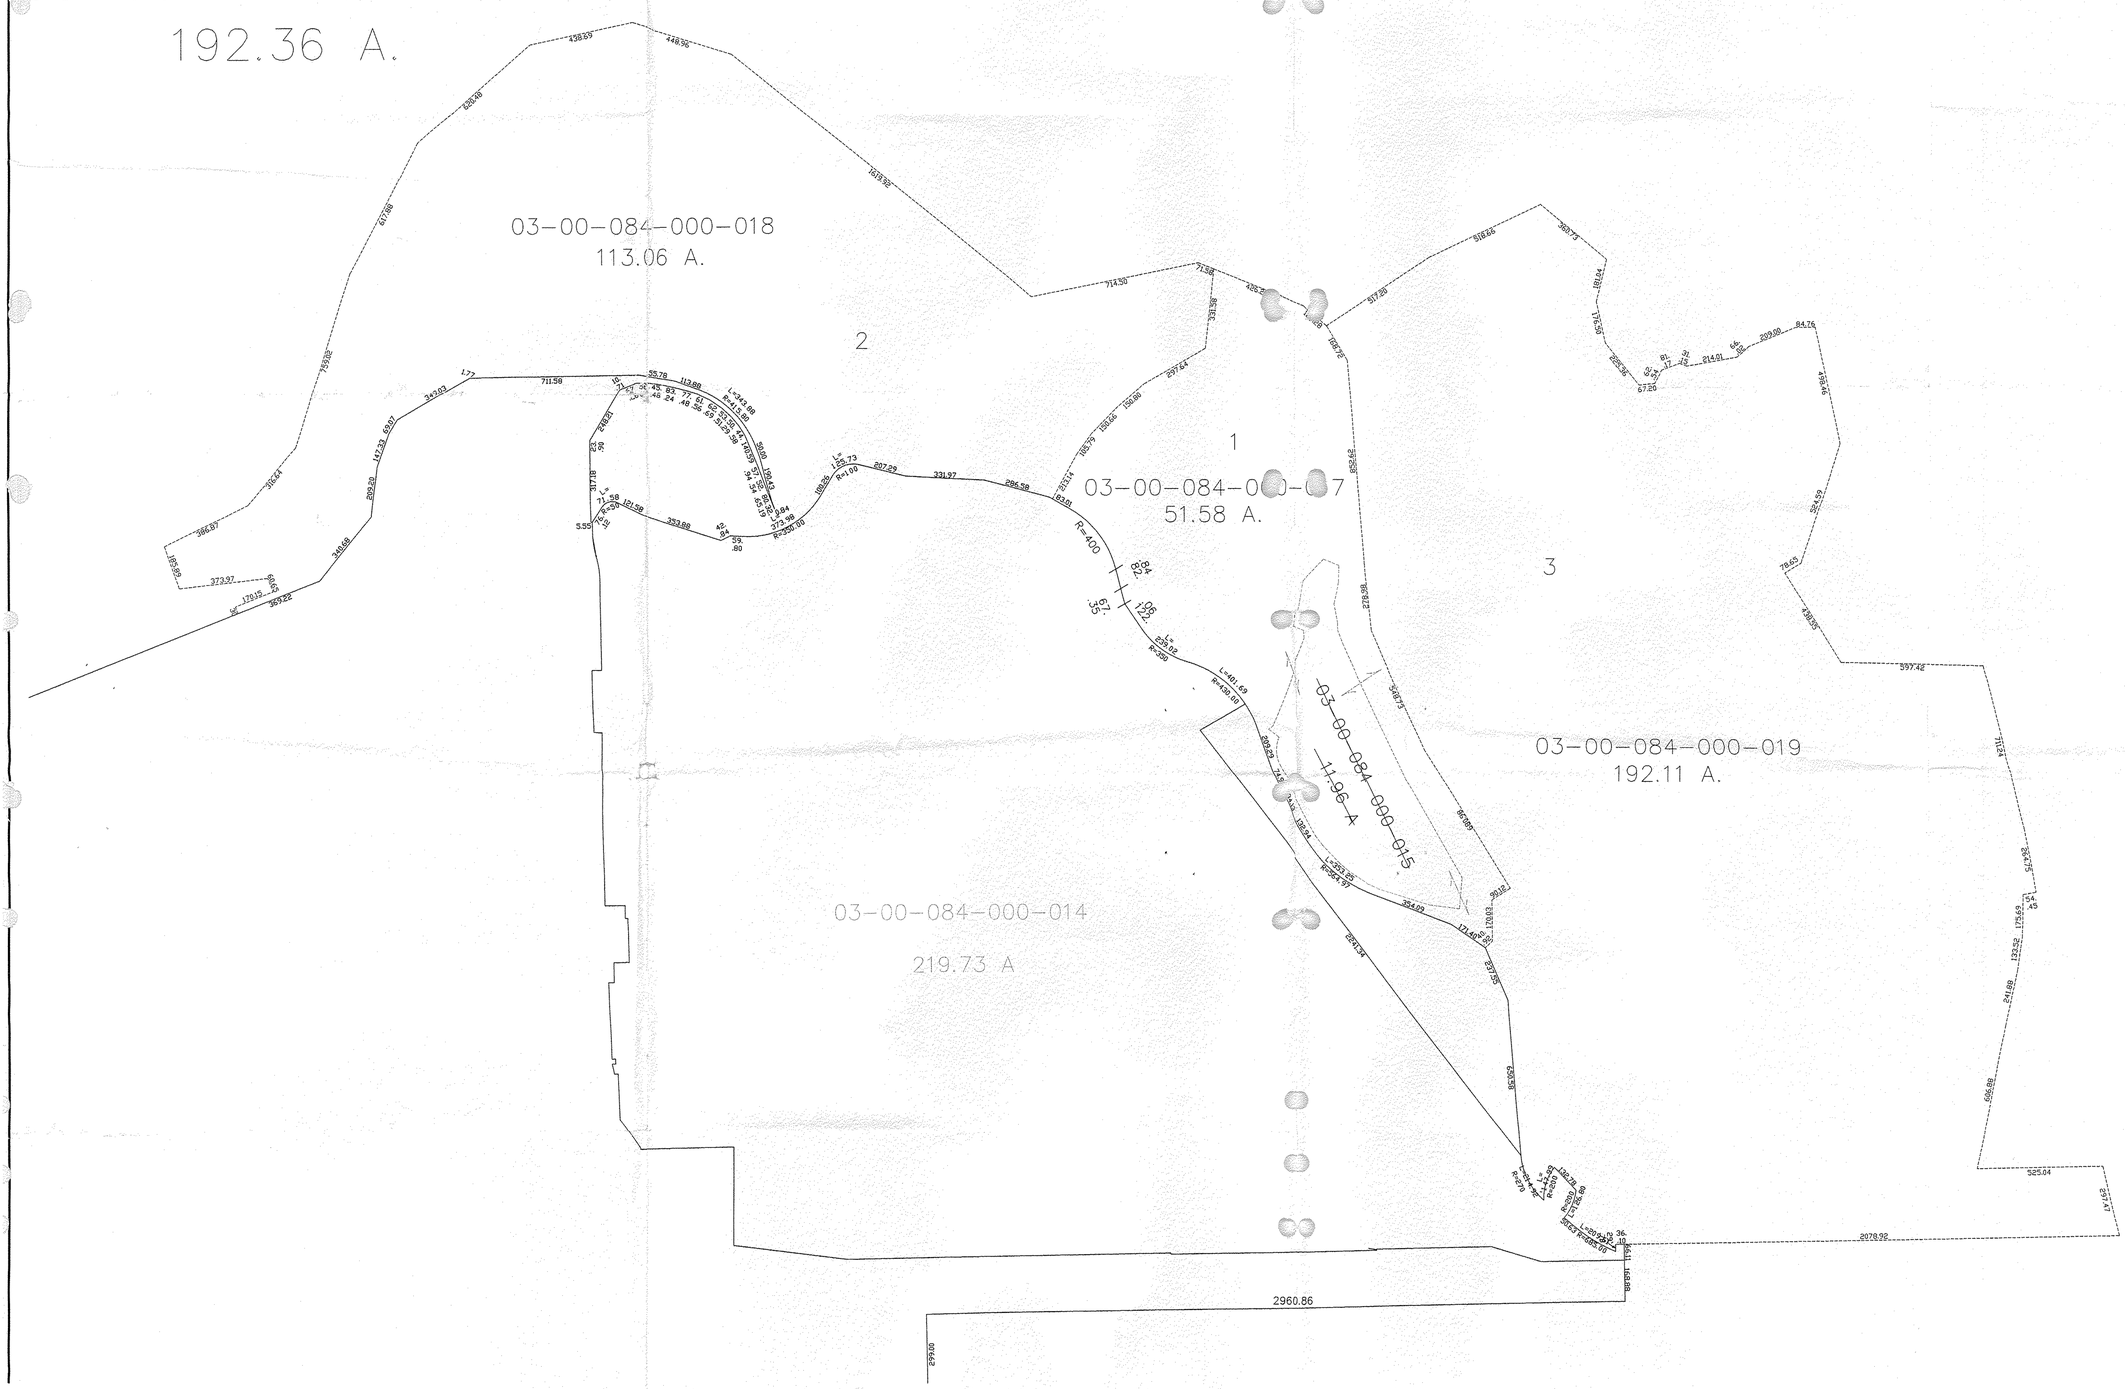
03-00-088-101-019
192.36 A.