RASTER

PARENT PARCEL: 04-00-023-110-026, -050
CHILD PARCEL: 04-00-023-110-055 THRU -060
STARTING POINT: CENTERLINE OF SCHWARTS RD. & NAGEL RD.

NO. 01316

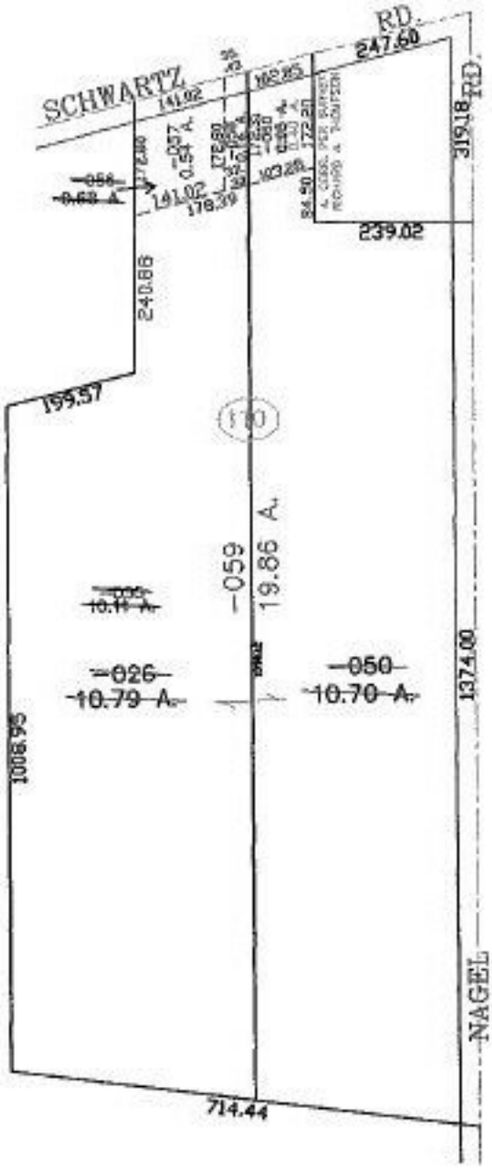

SPLITS/DEEDS PROCESSED
LORAIN COUNTY TAX MAP DEPARTMENT
226 MIDDLE AVE. ELYRIA, OHIO

SURVEYED BY: RICHARD A. THOMPSON
CLOSURE: 0.00 : 10.000
MAP PAGE(S): 04-00-023-H
APPROVED BY: JAH DATE: 3-06-03
SCALE: 1"= 300 PRIOR INSTRUMENT: 20010774675