RASTER

PARENT PARCEL: 03-00-001-000-018, 03-00-002-102-020

CHILD PARCEL: 03-00-002-102-044, 03-00-001-000-126 THRU -128

STARTING POINT: CENTERLINE OF DETROIT RD. & ABBE RD.

NO. 01333

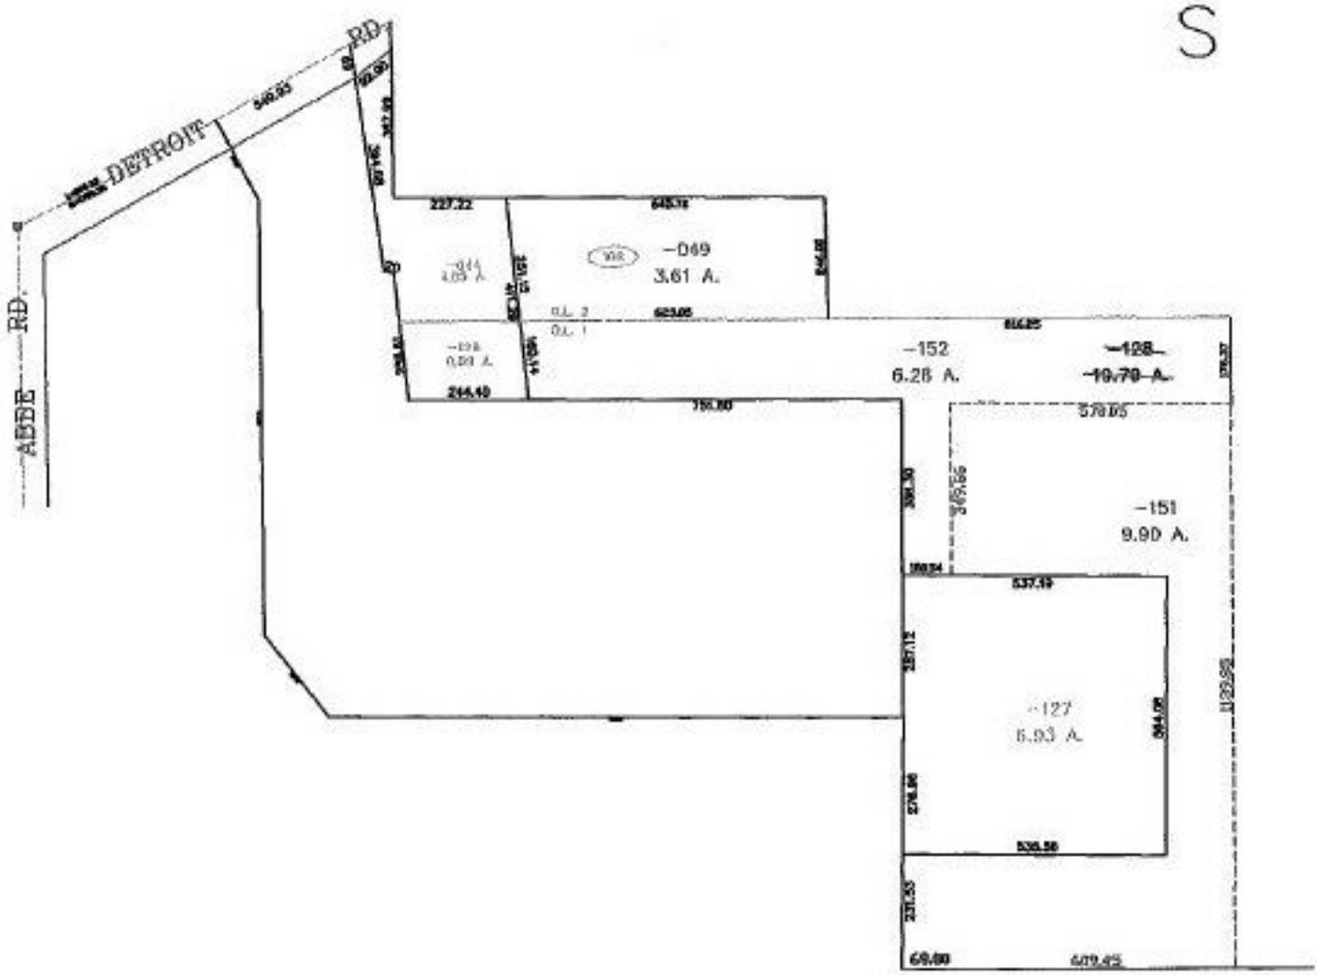

SPLITS/DEEDS PROCESSED

LORAIN COUNTY TAX MAP DEPARTMENT

226 MIDDLE AVE. ELYRIA, OHIO

SURVEYED BY: RAYMOND W. FOOS

CLOSURE: 0.00 : 10,000

MAP PAGE(S): 3-00-001-A -002-A

APPROVED BY: JAH DATE: 4-16-03

SCALE: 1"= 400 PRIOR INSTRUMENT: OR 1438/745