RASTER

PARENT PARCEL: 18-00-047-000-007, -009, -011

CHILD PARCEL: 18-00-047-000-014, -015

STARTING POINT: CENTERLINE OF JONES RD. & QUARRY RD.

NO. 01336

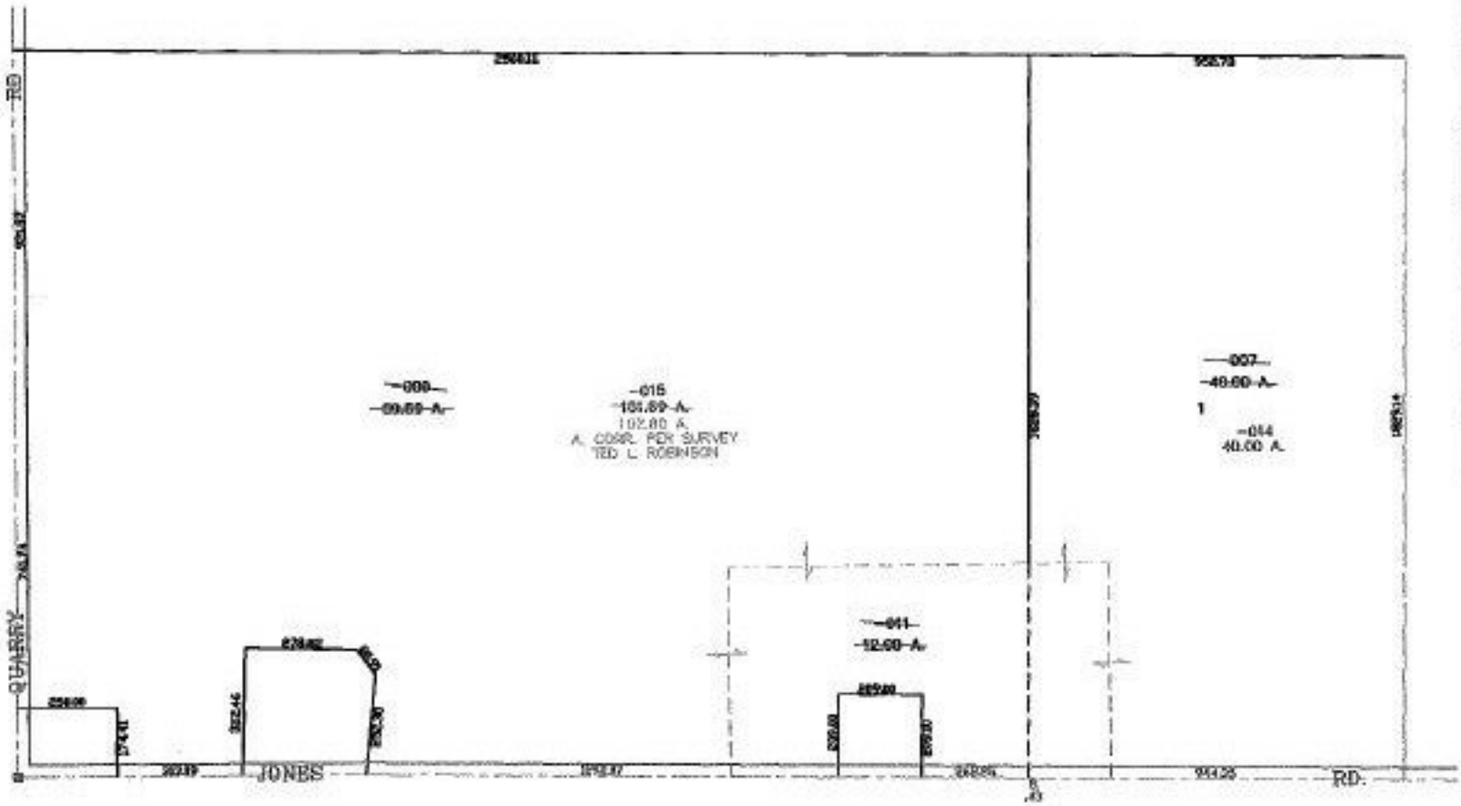

SPLITS/DEEDS PROCESSED

LORAIN COUNTY TAX MAP DEPARTMENT
226 MIDDLE AVE. ELYRIA, OHIO

SURVEYED BY: TED L. ROBINSON

CLOSURE: 0.00 : 10,000

MAP PAGE(S): 18-F

APPROVED BY: JAH DATE: 3-26-03

SCALE: 1"= 500 PRIOR INSTRUMENT: 20010726735