RASTER

PARENT PARCEL: 04-00-003-103-012
CHILD PARCEL: 04-00-003-103-034, -035
STARTING POINT: INT CL OF FRENCH CREEK RD AND EASTERLY LINE OF O.L.3

NO. 01353

N
W E
S

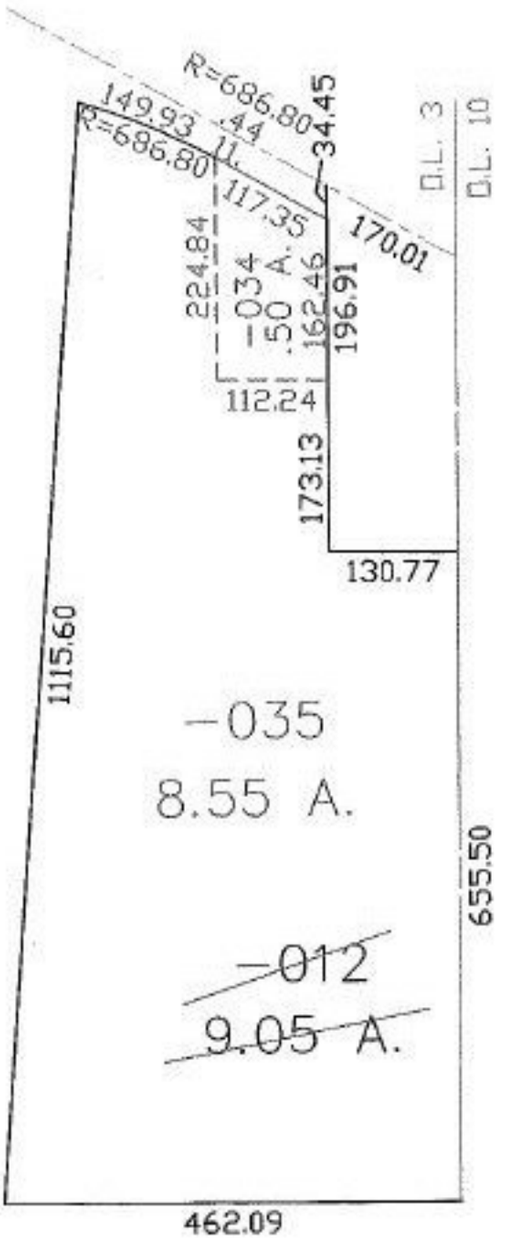

SPLITS/DEEDS PROCESSED
LORAIN COUNTY TAX MAP DEPARTMENT
226 MIDDLE AVE. ELYRIA, OHIO

SURVEYED BY: CARL R. ANDERSON
CLOSURE: 0.00
MAP PAGE(S): 04-00-003-H
APPROVED BY: DRH DATE: 4/22/2003
SCALE: 1"= 200 PRIOR INSTRUMENT: 20030898775