RASTER

PARENT PARCEL: 03-00-034-102-007, -017
CHILD PARCEL: 03-00-034-102-018, -019
STARTING POINT: NW CORNER OF SL 35

NO. 01356

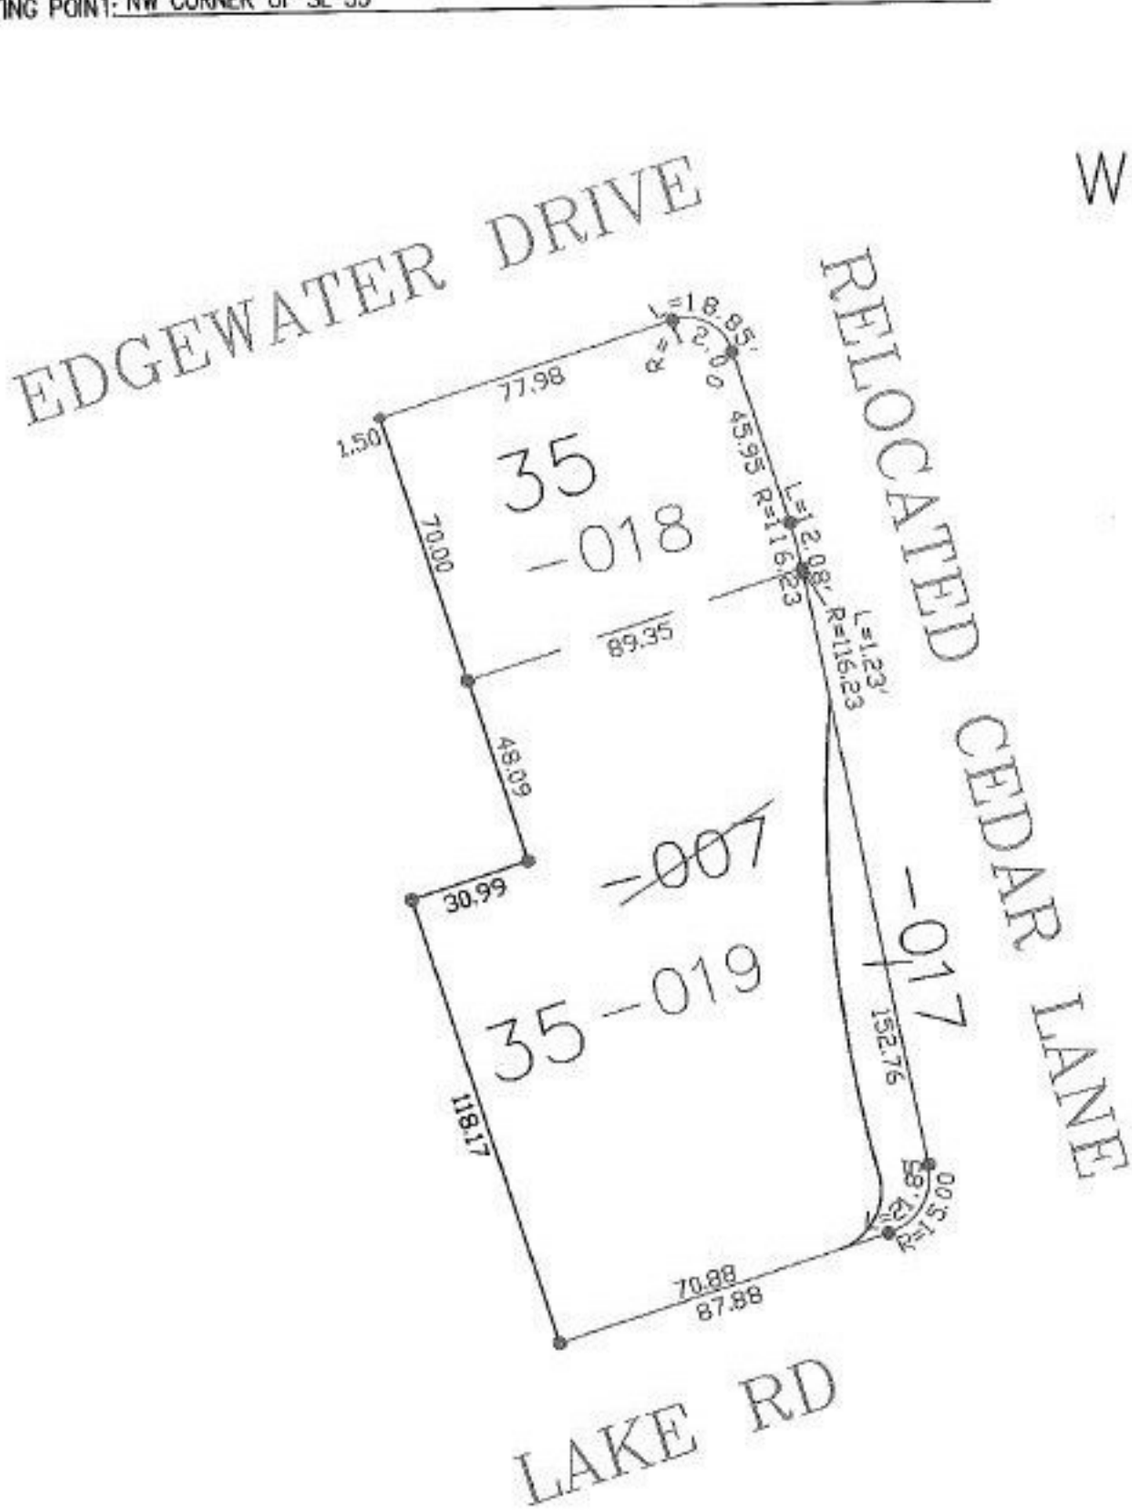

SPLITS/DEEDS PROCESSED
LORAIN COUNTY TAX MAP DEPARTMENT
226 MIDDLE AVE. ELYRIA, OHIO

SURVEYED BY: ALEX KELSER
CLOSURE: 0:00
MAP PAGE(S): 03-00-034-A
APPROVED BY: DRH DATE: 4/25/2003
SCALE: 1" = 50' PRIOR INSTRUMENT: P.V. 11 P.7

Prior Inst. 200300050690
REF. DOCUMENT