#02-01376

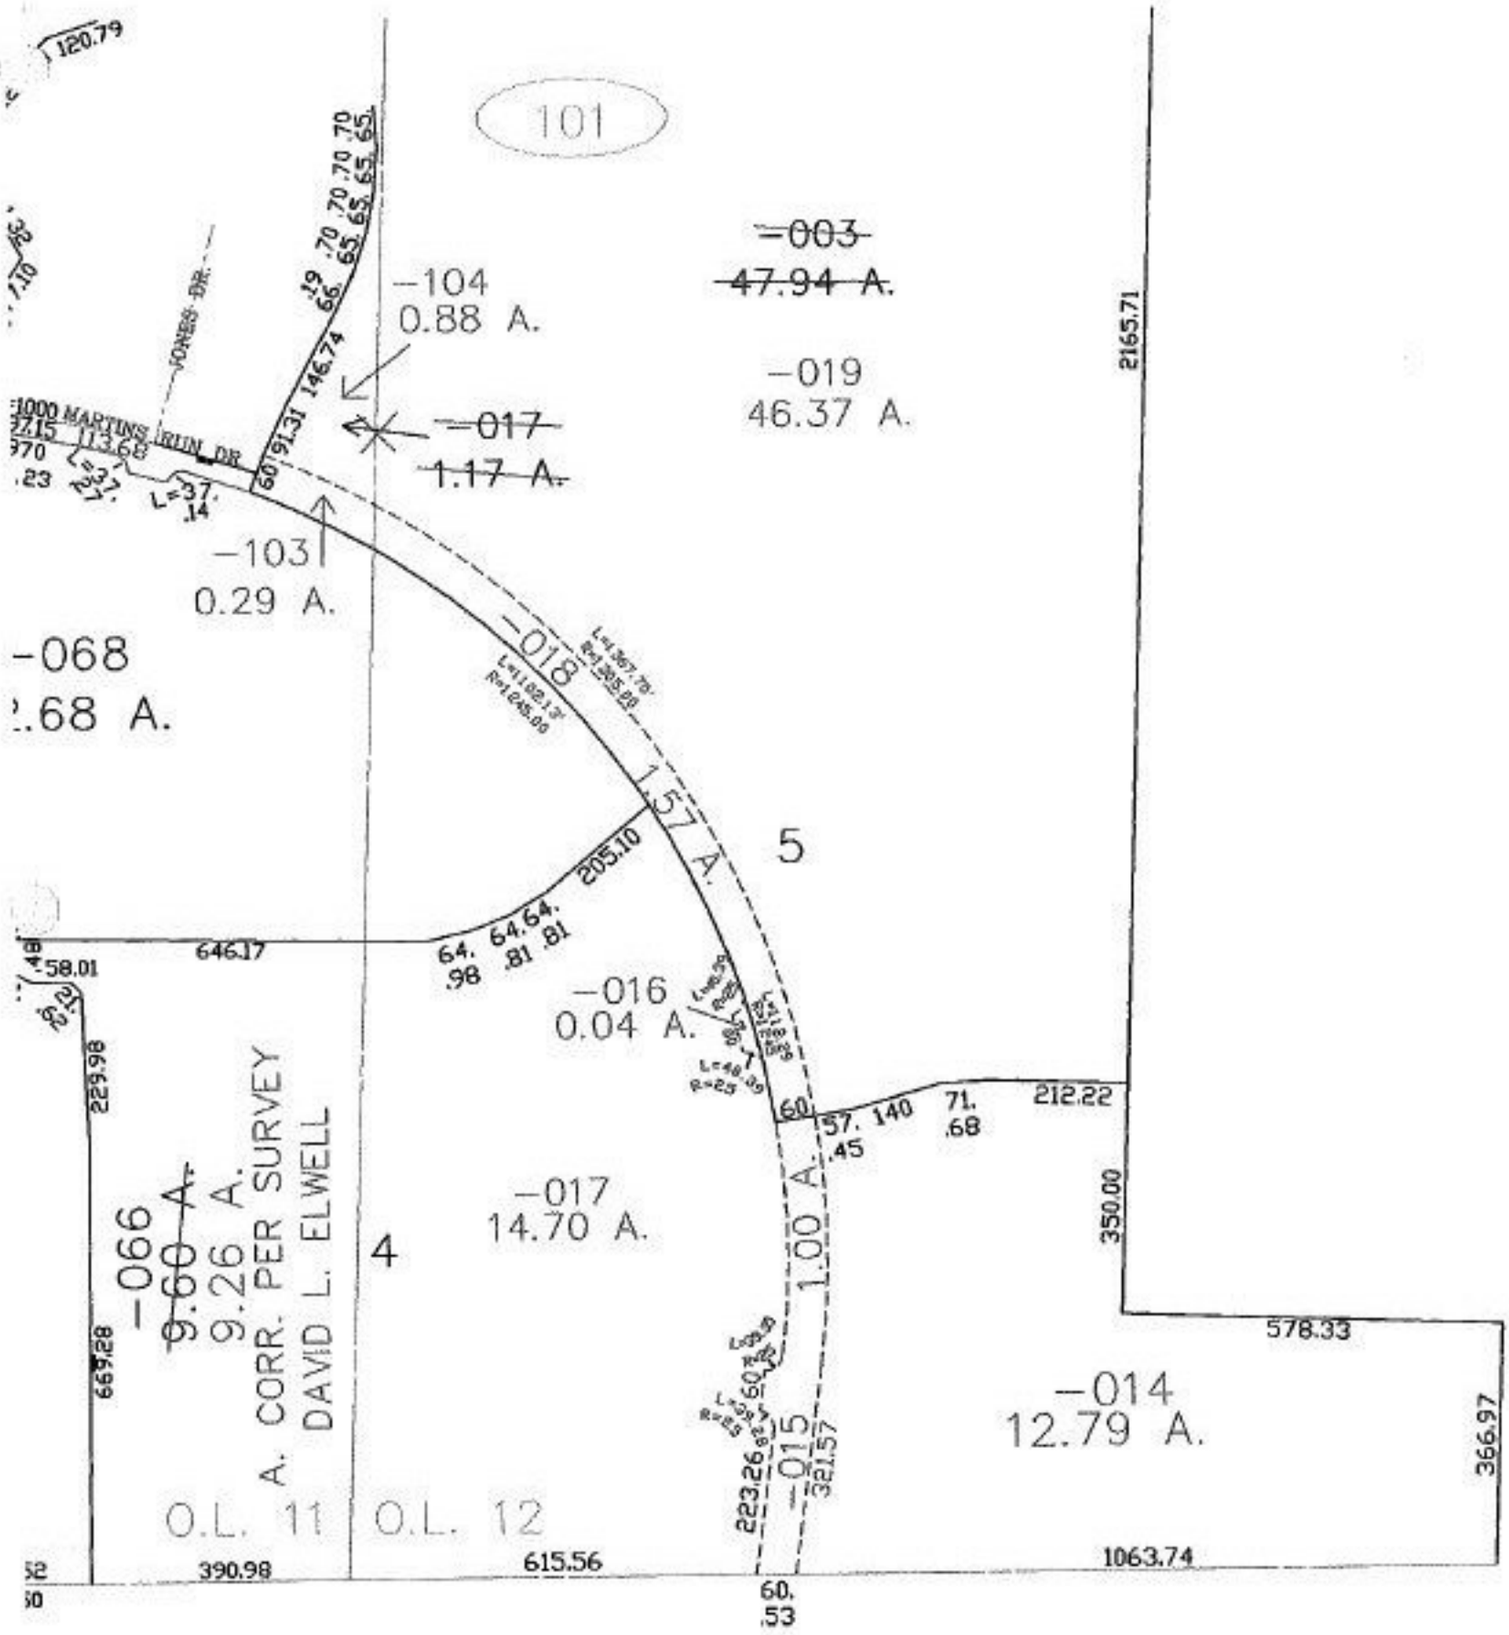
101
-104
0.88 A.
-003
47.94 A.
-019
46.37 A.
-017
1.17 A.
-103
0.29 A.
-018
1.57 A.
-068
.68 A.
-016
0.04 A.
-017
14.70 A.
-066
9.60 A.
9.26 A.
A. CORR. PER SURVEY
DAVID L. ELWELL
-015
1.00 A.
-014
12.79 A.
5
4
O.L. 11
O.L. 12
JONES DR.
MARTINS IRUN DR.
2165.71
646.17
205.10
212.22
350.00
578.33
366.97
1063.74
615.56
390.98
669.28
229.98
223.26
321.57
91.31
146.74
113.68
120.79